

CLAIM OF BENEFICIAL USE MAP



TO CHANGE PLACE OF USE AND POINTS OF APPROPRIATION

PER T-13942

FOR ELDER RANCH, LLC

TOWNSHIP 27 SOUTH, RANGE 34 EAST, SECTION 19, W.M.

TAX LOT: 3100

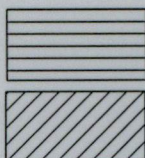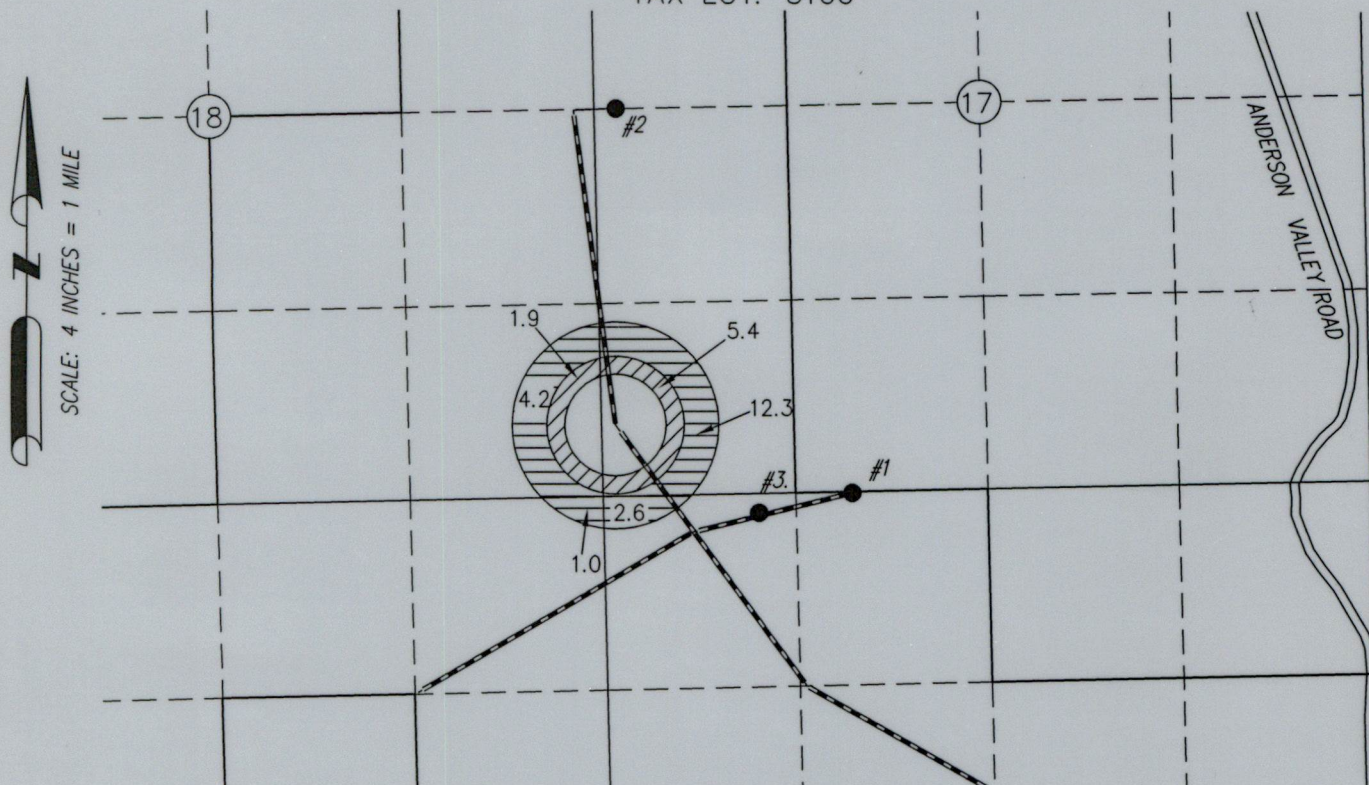

20.1 ACRES IR PER
T-13942 FROM G-8593

7.3 ACRES IR PER T-13942 FROM
G-8593 LAYERED WITH G-8592

CONVEYANCE

WELL 1 (HARN 52719) 43.21845° -118.55715°


- LOCATED 10 FEET SOUTH AND 930 FEET WEST FROM
THE 1/4 CORNER BETWEEN SECTIONS 17 & 20.
FLOW METER IS LOCATED 4.5' SW FROM WELL.

WELL 2 (HARN 52795) 43.22566° -118.56396°

- LOCATED 0 FEET SOUTH AND 150 FEET EAST FROM THE
1/4 CORNER BETWEEN SECTIONS 17 & 18.
FLOW METER IS LOCATED 4' EAST FROM WELL.

WELL 3 (HARN 52796) 43.21812° -118.55954°

- LOCATED 130 FEET SOUTH AND 1570 FEET WEST FROM
THE 1/4 CORNER BETWEEN SECTIONS 17 & 20.
FLOW METER IS LOCATED 4.5' WEST FROM WELL.

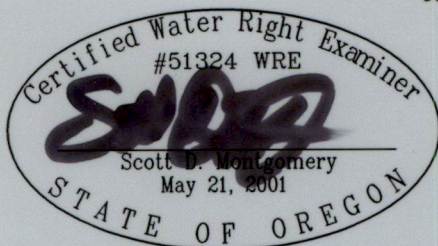

RENEWAL DATE: 12/31/2026

Received
SEP 09 2026
OWRD

THIS MAP IS FOR THE PURPOSE OF LOCATING A WATER RIGHT ONLY AND HAS NO
INTENT TO PROVIDE LEGAL DIMENSIONS OR THE LOCATION OF PROPERTY LINES.

PREPARED FOR:

ELDER RANCH, LLC
38131 SODHOUSE LANE
PRINCETON, OR 97721

PREPARED BY:



ALL POINTS ENGINEERING AND SURVEYING, INC.
P.O. BOX 767 TERREBONNE, OR 97760
(541) 548-5833 www.APEandS.com


CLAIM OF BENEFICIAL USE MAP

TO CHANGE PLACE OF USE AND POINTS OF APPROPRIATION

PER T-13942


FOR ELDER RANCH, LLC

TOWNSHIP 27 SOUTH, RANGE 34 EAST, SECTION 19, W.M.
TAX LOT: 3100

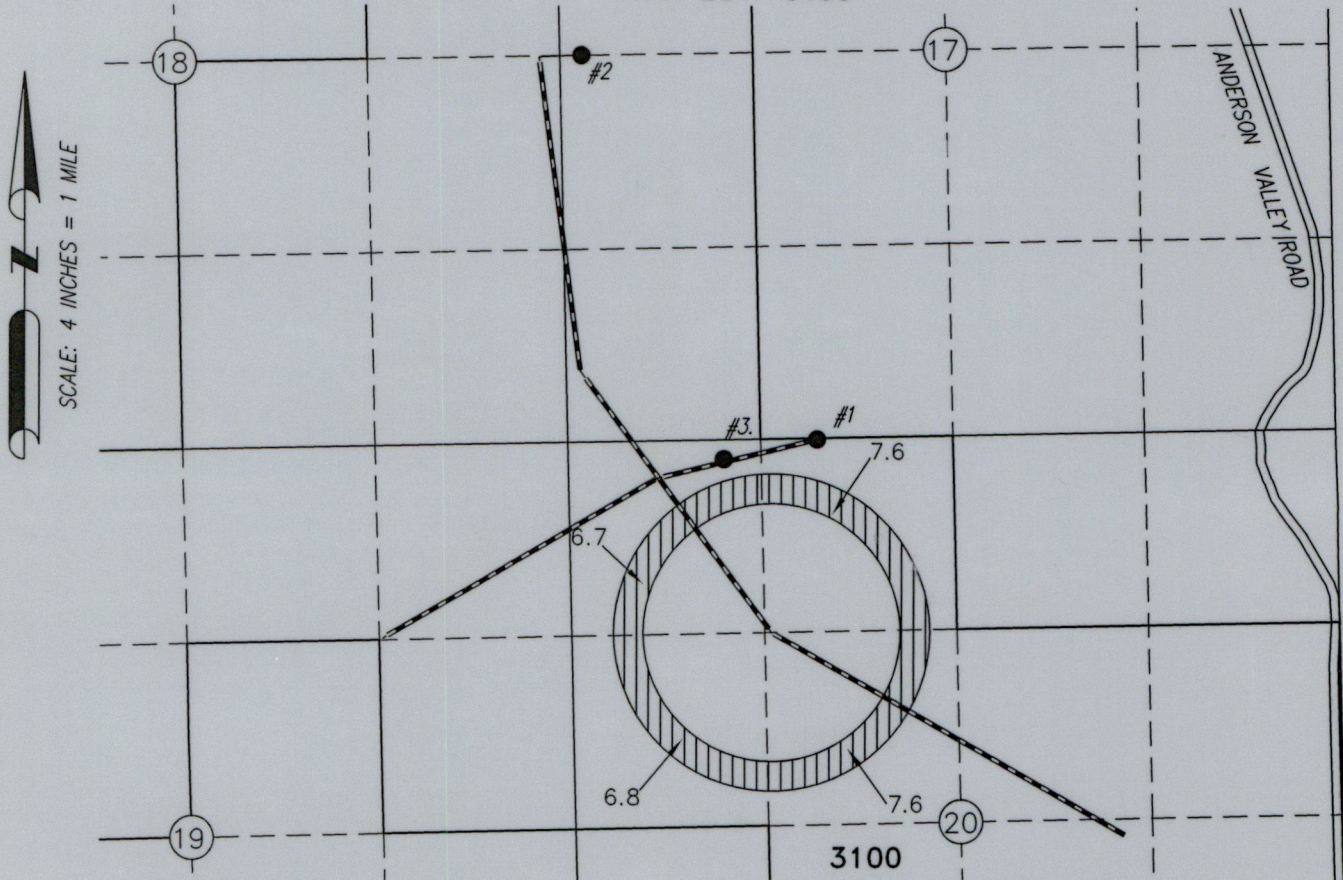

28.7 ACRES IR PER T-13942 &
FROM G-17183

CONVEYANCE

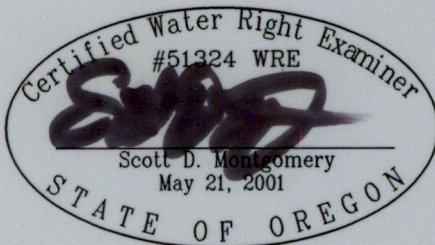

RENEWAL DATE: 12/31/2026

WELL 1 (HARN 52719) 43.21845° -118.55715°

- LOCATED 10 FEET SOUTH AND 930 FEET WEST FROM THE 1/4 CORNER BETWEEN SECTIONS 17 & 20. FLOW METER IS LOCATED 4.5' SW FROM WELL.

WELL 2 (HARN 52795) 43.22566° -118.56396°

- LOCATED 0 FEET SOUTH AND 150 FEET EAST FROM THE 1/4 CORNER BETWEEN SECTIONS 17 & 18. FLOW METER IS LOCATED 4' EAST FROM WELL.

WELL 3 (HARN 52796) 43.21812° -118.55954°

- LOCATED 130 FEET SOUTH AND 1570 FEET WEST FROM THE 1/4 CORNER BETWEEN SECTIONS 17 & 20. FLOW METER IS LOCATED 4.5' WEST FROM WELL.

Received
SEP 09 2026

OWRD

THIS MAP IS FOR THE PURPOSE OF LOCATING A WATER RIGHT ONLY AND HAS NO INTENT TO PROVIDE LEGAL DIMENSIONS OR THE LOCATION OF PROPERTY LINES.

PREPARED FOR:

ELDER RANCH, LLC
38131 SODHOUSE LANE
PRINCETON, OR 97721

PREPARED BY:



ALL POINTS ENGINEERING AND SURVEYING, INC.
P.O. BOX 767 TERREBONNE, OR 97760
(541) 548-5833 www.APEandS.com


CLAIM OF BENEFICIAL USE MAP

TO CHANGE PLACE OF USE AND POINTS OF APPROPRIATION

PER T-13942

FOR ELDER RANCH, LLC

TOWNSHIP 27 SOUTH, RANGE 34 EAST, SECTION 19, W.M.
TAX LOT: 3100

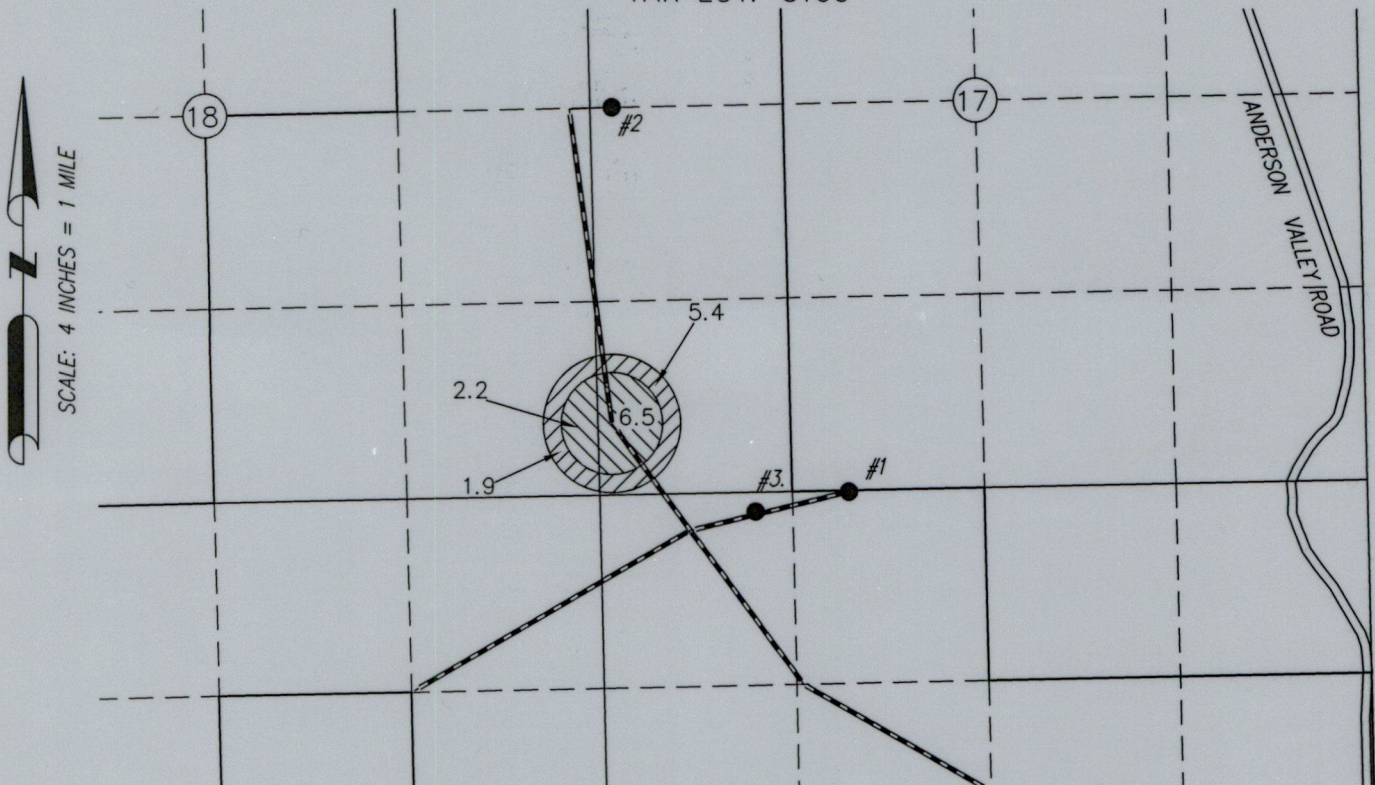


8.7 ACRES IR PER T-13942 &
FROM G-8592



7.3 ACRES IR PER T-13942 FROM
G-8592 LAYERED WITH G-8593

CONVEYANCE

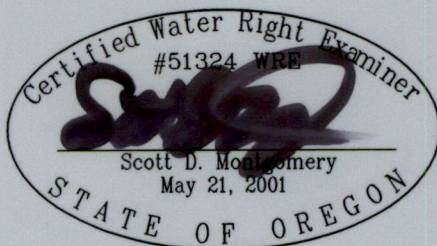

RENEWAL DATE: 12/31/2026

Received
SEP 09 2026
OWRD

- WELL 1 (HARN 52719) 43.21845° -118.55715°
LOCATED 10 FEET SOUTH AND 930 FEET WEST FROM
THE 1/4 CORNER BETWEEN SECTIONS 17 & 20.
FLOW METER IS LOCATED 4.5' SW FROM WELL.
- WELL 2 (HARN 52795) 43.22566° -118.56396°
LOCATED 0 FEET SOUTH AND 150 FEET EAST FROM THE
1/4 CORNER BETWEEN SECTIONS 17 & 18.
FLOW METER IS LOCATED 4' EAST FROM WELL.
- WELL 3 (HARN 52796) 43.21812° -118.55954°
LOCATED 130 FEET SOUTH AND 1570 FEET WEST FROM
THE 1/4 CORNER BETWEEN SECTIONS 17 & 20.
FLOW METER IS LOCATED 4.5' WEST FROM WELL.

THIS MAP IS FOR THE PURPOSE OF LOCATING A WATER RIGHT ONLY AND HAS NO
INTENT TO PROVIDE LEGAL DIMENSIONS OR THE LOCATION OF PROPERTY LINES.

PREPARED FOR:

ELDER RANCH, LLC
38131 SODHOUSE LANE
PRINCETON, OR 97721

PREPARED BY:



ALL POINTS ENGINEERING AND SURVEYING, INC.
P.O. BOX 767 TERREBONNE, OR 97760
(541) 548-5833 www.APEandS.com

CLAIM OF BENEFICIAL USE MAP


TO CHANGE PLACE OF USE AND POINTS OF APPROPRIATION

PER T-13942

FOR ELDER RANCH, LLC

TOWNSHIP 27 SOUTH, RANGE 34 EAST, SECTION 19, W.M.

TAX LOT: 3100

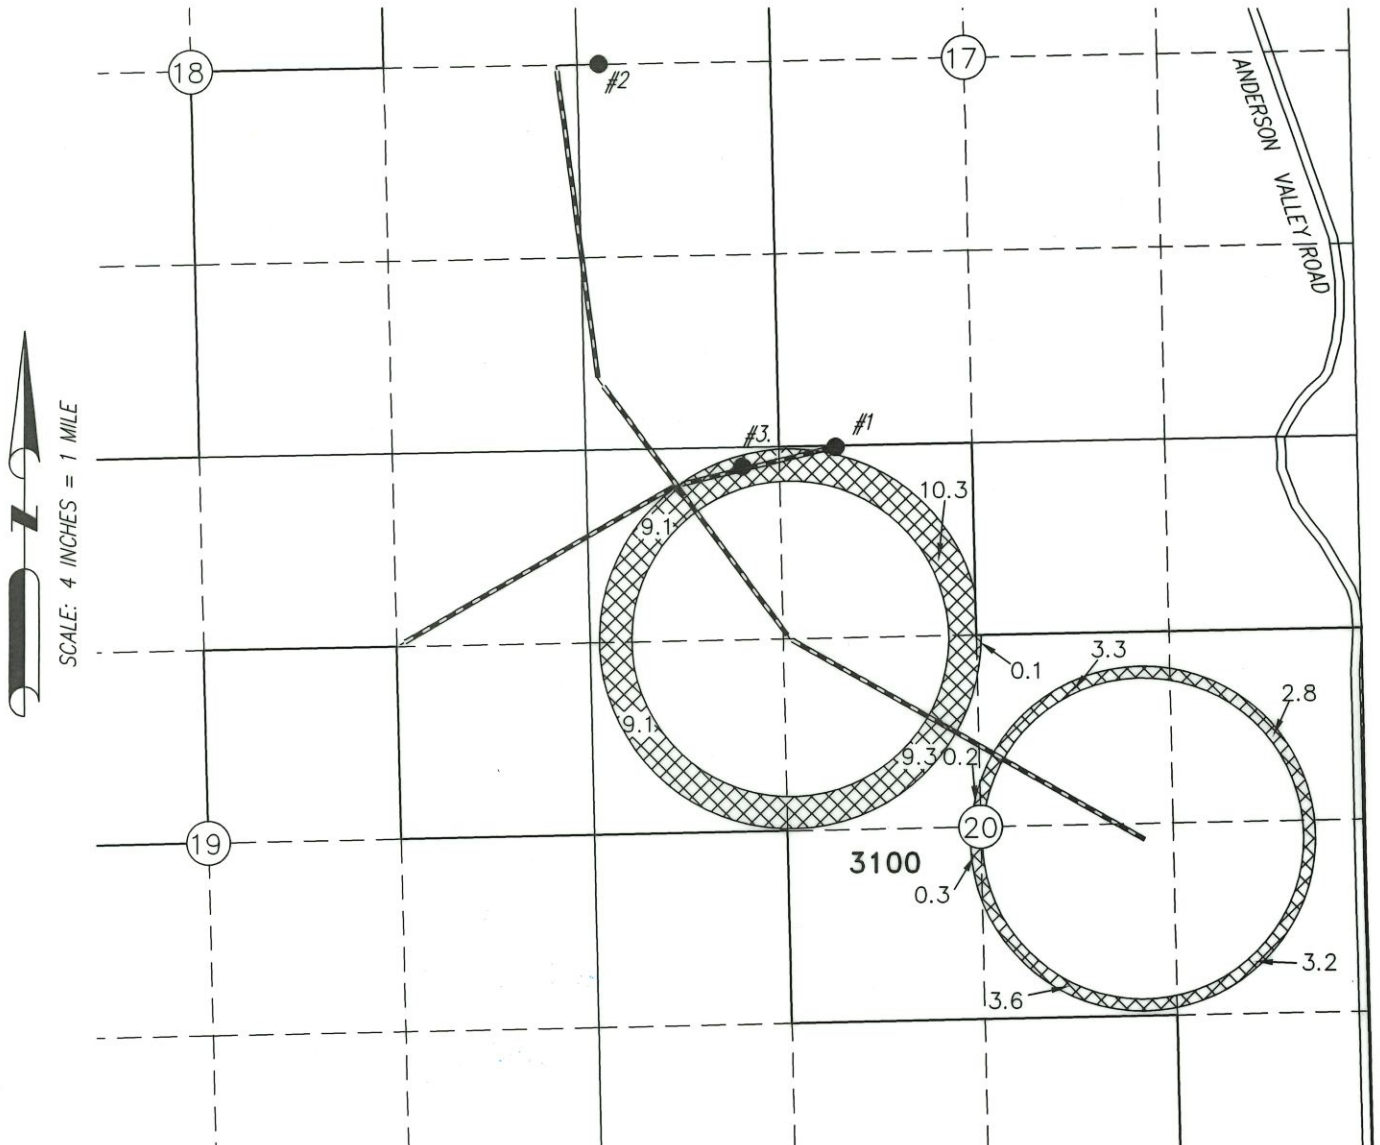

51.3 ACRES IR PER T-13942
FROM G-17183

CONVEYANCE



RENEWAL DATE: 12/31/2026

Received
SEP 09 2026
OWRD

WELL 1 (HARN 52719) 43.21845° -118.55715°

- LOCATED 10 FEET SOUTH AND 930 FEET WEST FROM THE 1/4 CORNER BETWEEN SECTIONS 17 & 20. FLOW METER IS LOCATED 4.5' SW FROM WELL.

WELL 2 (HARN 52795) 43.22566° -118.56396°

- LOCATED 0 FEET SOUTH AND 150 FEET EAST FROM THE 1/4 CORNER BETWEEN SECTIONS 17 & 18. FLOW METER IS LOCATED 4' EAST FROM WELL.

WELL 3 (HARN 52796) 43.21812° -118.55954°

- LOCATED 130 FEET SOUTH AND 1570 FEET WEST FROM THE 1/4 CORNER BETWEEN SECTIONS 17 & 20. FLOW METER IS LOCATED 4.5' WEST FROM WELL.

THIS MAP IS FOR THE PURPOSE OF LOCATING A WATER RIGHT ONLY AND HAS NO INTENT TO PROVIDE LEGAL DIMENSIONS OR THE LOCATION OF PROPERTY LINES.

PREPARED FOR:


ELDER RANCH, LLC
38131 SODHOUSE LANE
PRINCETON, OR 97721

PREPARED BY:




ALL POINTS ENGINEERING AND SURVEYING, INC.
P.O. BOX 767 TERREBONNE, OR 97760
(541) 548-5833 www.APEandS.com

CLAIM OF BENEFICIAL USE MAP
TO CHANGE PLACE OF USE AND POINTS OF APPROPRIATION
PER T-13942
FOR ELDER RANCH, LLC
TOWNSHIP 27 SOUTH, RANGE 34 EAST, SECTION 19, W.M.
TAX LOT: 3100

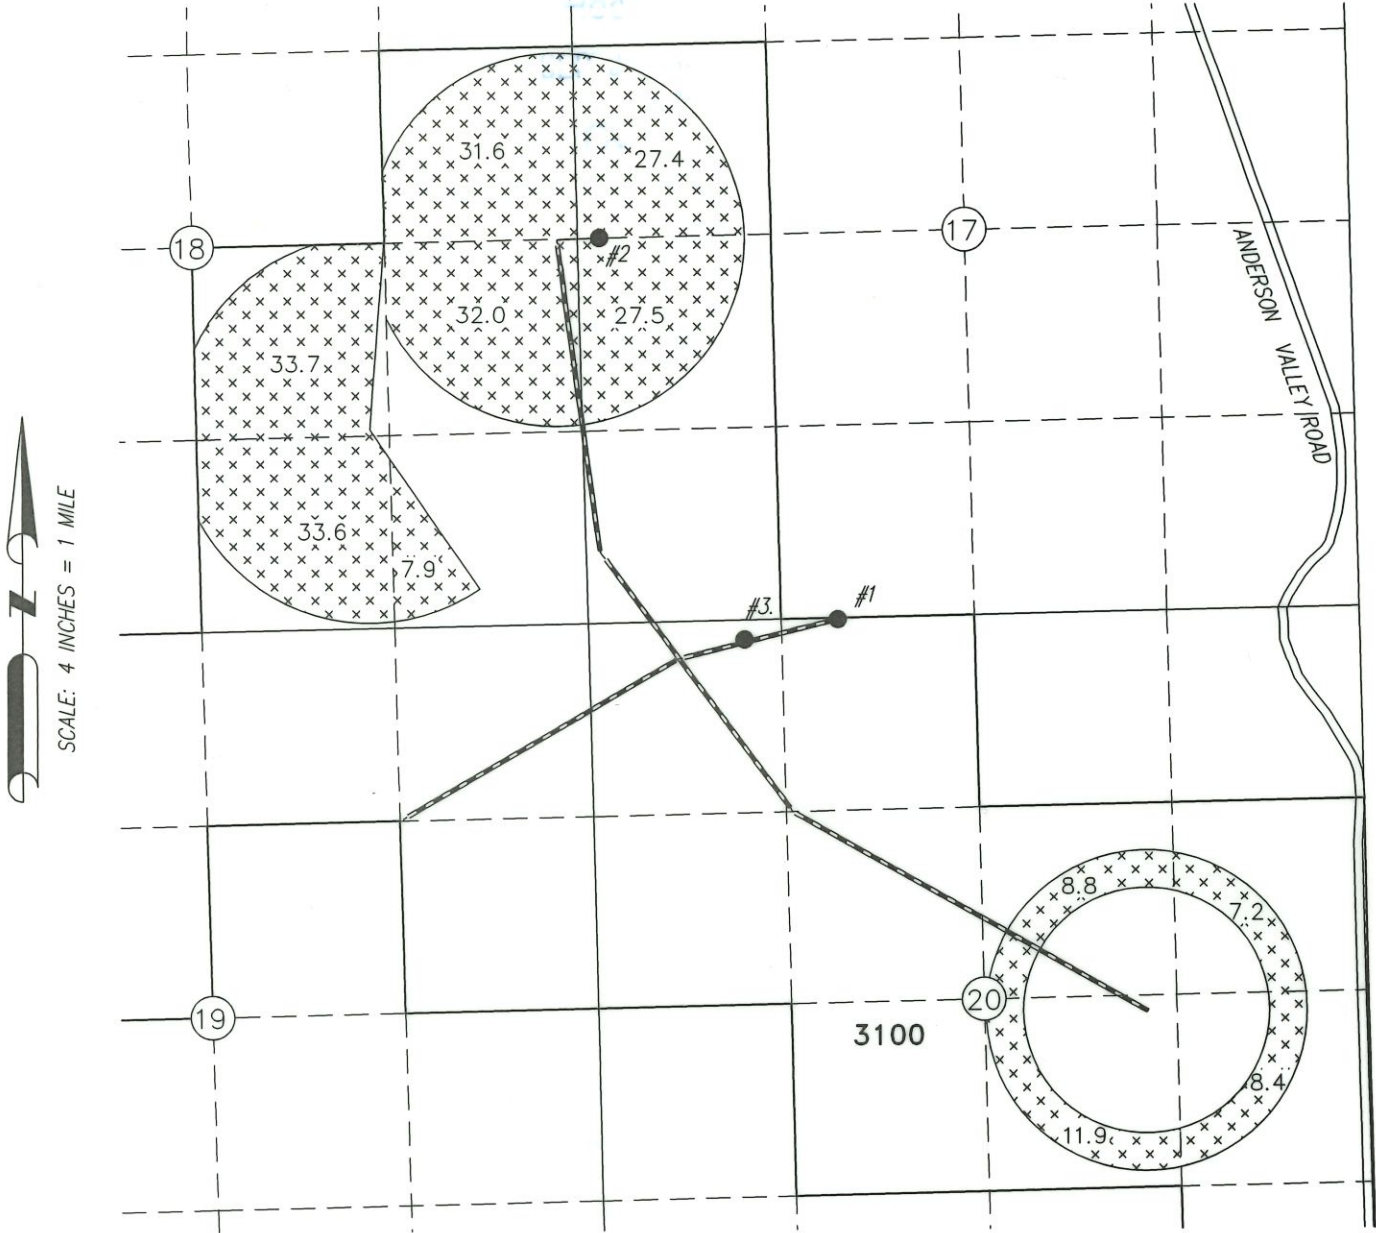

230.0 ACRES IR PER T-13942 &
FROM G-17034

CONVEYANCE

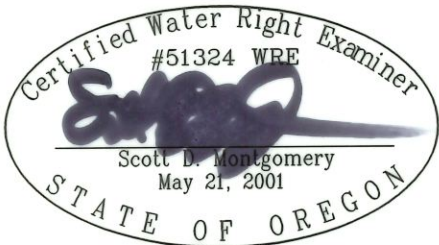

RENEWAL DATE: 12/31/2026

Received
SEP 09 2026
OWRD

- WELL 1 (HARN 52719) 43.21845° -118.55715°
● LOCATED 10 FEET SOUTH AND 930 FEET WEST FROM
THE 1/4 CORNER BETWEEN SECTIONS 17 & 20.
FLOW METER IS LOCATED 4.5' SW FROM WELL.
- WELL 2 (HARN 52795) 43.22566° -118.56396°
● LOCATED 0 FEET SOUTH AND 150 FEET EAST FROM THE
1/4 CORNER BETWEEN SECTIONS 17 & 18.
FLOW METER IS LOCATED 4' EAST FROM WELL.
- WELL 3 (HARN 52796) 43.21812° -118.55954°
● LOCATED 130 FEET SOUTH AND 1570 FEET WEST FROM
THE 1/4 CORNER BETWEEN SECTIONS 17 & 20.
FLOW METER IS LOCATED 4.5' WEST FROM WELL.

THIS MAP IS FOR THE PURPOSE OF LOCATING A WATER RIGHT ONLY AND HAS NO
INTENT TO PROVIDE LEGAL DIMENSIONS OR THE LOCATION OF PROPERTY LINES.

PREPARED FOR:


ELDER RANCH, LLC
38131 SODHOUSE LANE
PRINCETON, OR 97721

PREPARED BY:




ALL POINTS ENGINEERING AND SURVEYING, INC.
P.O. BOX 767 TERREBONNE, OR 97760
(541) 548-5833 www.APEandS.com

TAX LOT: 3100

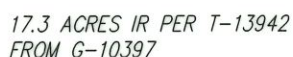

CONVEYANCE

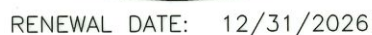

LOCATED 130 FEET SOUTH AND 1570 FEET WEST FROM
THE 1/4 CORNER BETWEEN SECTIONS 17 & 20.
FLOW METER IS LOCATED 4.5' WEST FROM WELL.

Received
SEP 09 2020
OWRD

THIS MAP IS FOR THE PURPOSE OF LOCATING A WATER RIGHT ONLY AND HAS NO INTENT TO PROVIDE LEGAL DIMENSIONS OR THE LOCATION OF PROPERTY LINES.

ALL POINTS ENGINEERING AND SURVEYING, INC.
P.O. BOX 767 TERREBONNE, OR 97760
(541) 548-5833 www.APEandS.com

CLAIM OF BENEFICIAL USE MAP


TO CHANGE PLACE OF USE AND POINTS OF APPROPRIATION

PER T-13942

FOR ELDER RANCH, LLC


TOWNSHIP 27 SOUTH, RANGE 34 EAST, SECTION 19, W.M.

TAX LOT: 3100

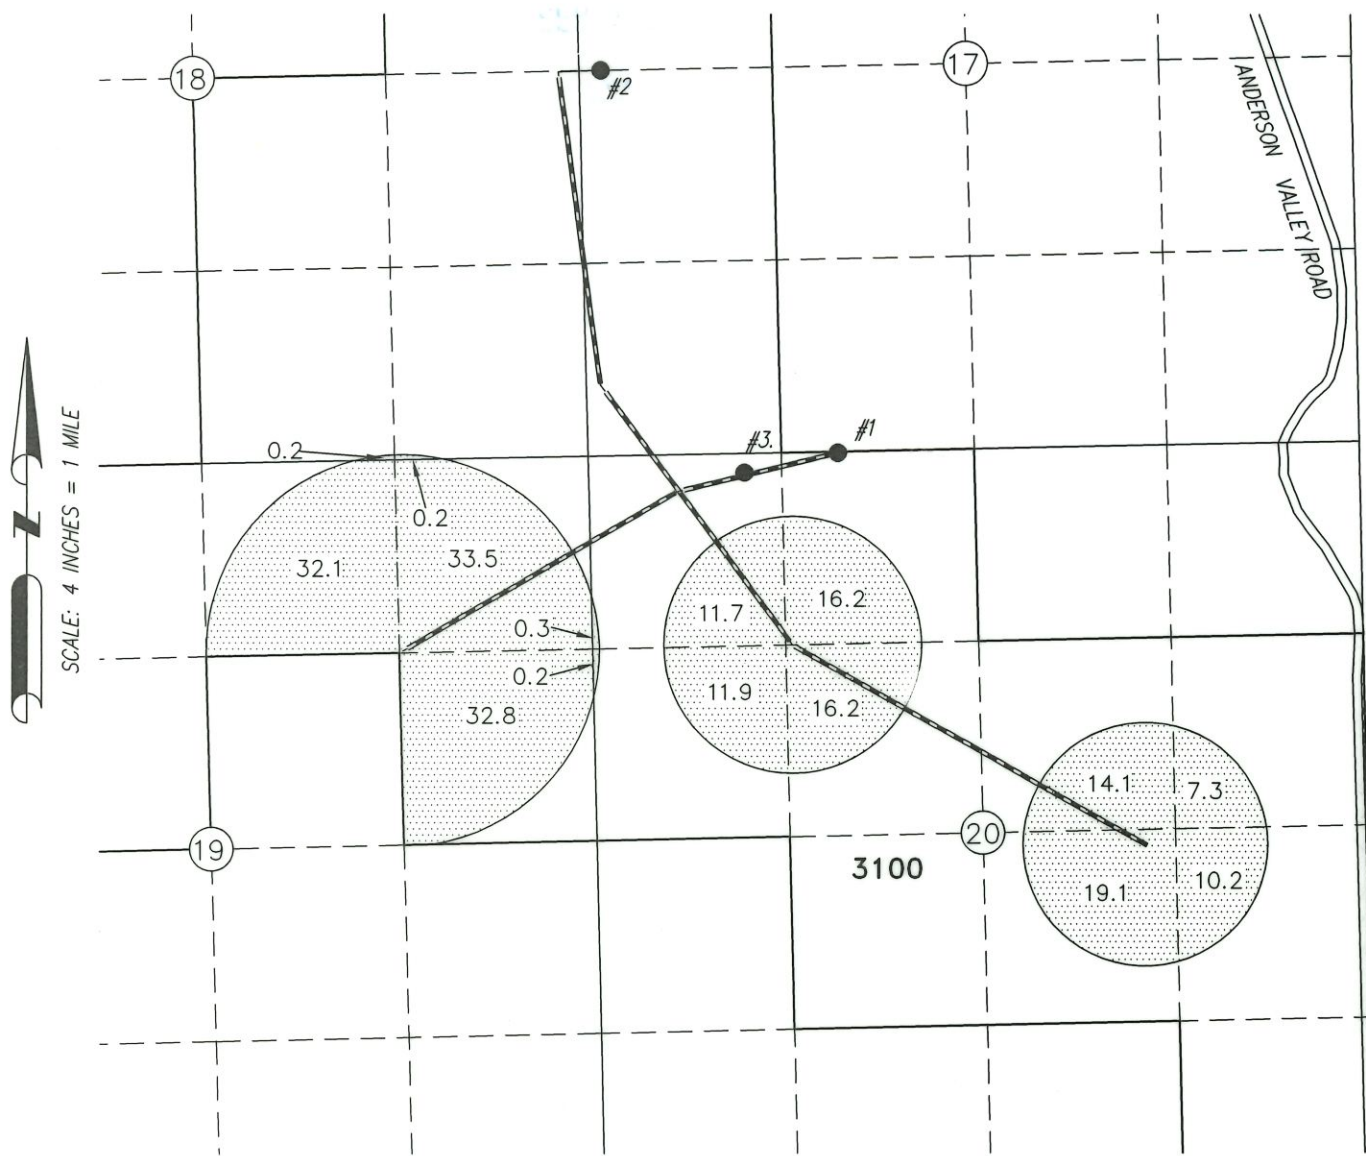

206.0 ACRES IR PER T-13942 FROM
G-17264 LAYERED WITH G-8593

CONVEYANCE

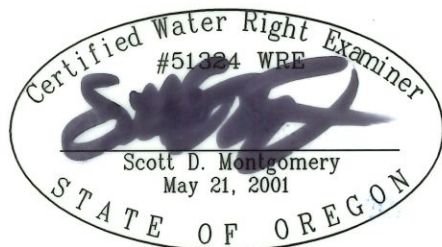

RENEWAL DATE: 12/31/2026

Received
SEP 09 2026
OWRD

WELL 1 (HARN 52719) 43.21845° -118.55715°

- LOCATED 10 FEET SOUTH AND 930 FEET WEST FROM
THE 1/4 CORNER BETWEEN SECTIONS 17 & 20.
FLOW METER IS LOCATED 4.5' SW FROM WELL.

WELL 2 (HARN 52795) 43.22566° -118.56396°

- LOCATED 0 FEET SOUTH AND 150 FEET EAST FROM THE
1/4 CORNER BETWEEN SECTIONS 17 & 18.
FLOW METER IS LOCATED 4' EAST FROM WELL.

WELL 3 (HARN 52796) 43.21812° -118.55954°

- LOCATED 130 FEET SOUTH AND 1570 FEET WEST FROM
THE 1/4 CORNER BETWEEN SECTIONS 17 & 20.
FLOW METER IS LOCATED 4.5' WEST FROM WELL.

THIS MAP IS FOR THE PURPOSE OF LOCATING A WATER RIGHT ONLY AND HAS NO
INTENT TO PROVIDE LEGAL DIMENSIONS OR THE LOCATION OF PROPERTY LINES.

PREPARED FOR:

ELDER RANCH, LLC
38131 SODHOUSE LANE
PRINCETON, OR 97721

PREPARED BY:



ALL POINTS ENGINEERING AND SURVEYING, INC.
P.O. BOX 767 TERREBONNE, OR 97760
(541) 548-5833 www.APEandS.com

CLAIM OF BENEFICIAL USE MAP



TO CHANGE PLACE OF USE AND POINTS OF APPROPRIATION

PER T-13942

FOR ELDER RANCH, LLC


TOWNSHIP 27 SOUTH, RANGE 34 EAST, SECTION 19, W.M.

TAX LOT: 3100

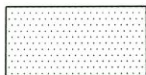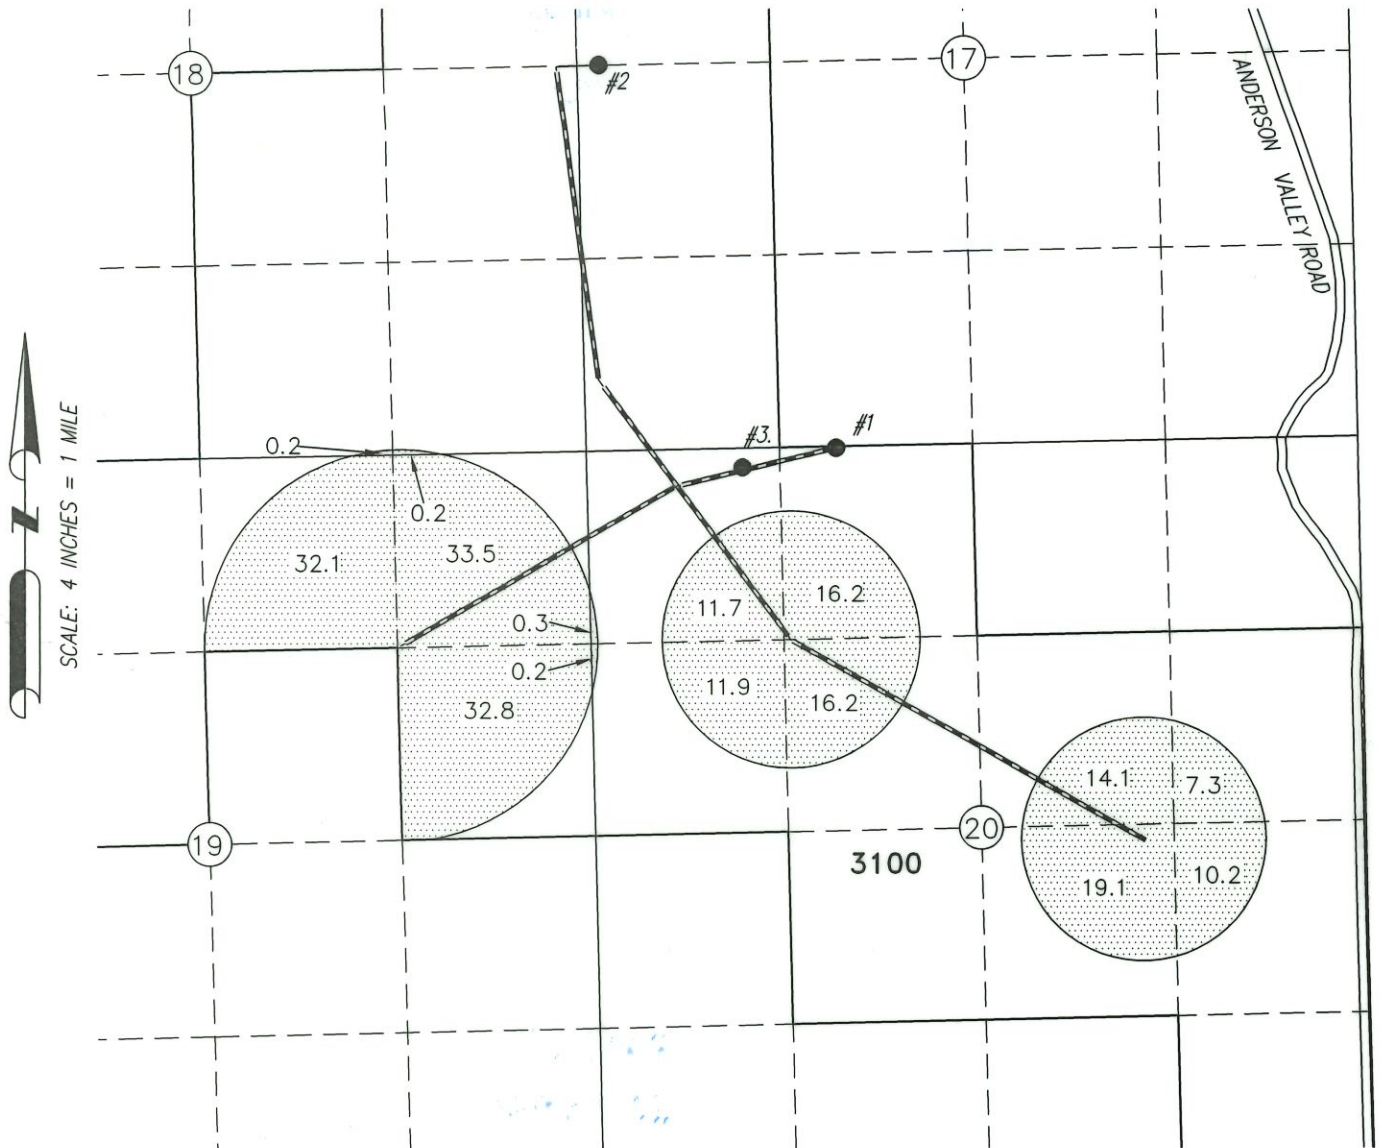

206.0 ACRES IR PER T-13942 FROM
G-8593 LAYERED WITH G-17264

CONVEYANCE

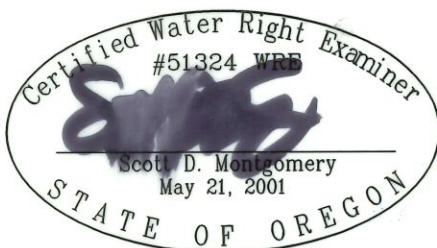

RENEWAL DATE: 12/31/2026

Received
SEP 09 2026
OWRD

WELL 1 (HARN 52719) 43.21845° -118.55715°

- LOCATED 10 FEET SOUTH AND 930 FEET WEST FROM THE 1/4 CORNER BETWEEN SECTIONS 17 & 20. FLOW METER IS LOCATED 4.5' SW FROM WELL.

WELL 2 (HARN 52795) 43.22566° -118.56396°

- LOCATED 0 FEET SOUTH AND 150 FEET EAST FROM THE 1/4 CORNER BETWEEN SECTIONS 17 & 18. FLOW METER IS LOCATED 4' EAST FROM WELL.

WELL 3 (HARN 52796) 43.21812° -118.55954°

- LOCATED 130 FEET SOUTH AND 1570 FEET WEST FROM THE 1/4 CORNER BETWEEN SECTIONS 17 & 20. FLOW METER IS LOCATED 4.5' WEST FROM WELL.

THIS MAP IS FOR THE PURPOSE OF LOCATING A WATER RIGHT ONLY AND HAS NO INTENT TO PROVIDE LEGAL DIMENSIONS OR THE LOCATION OF PROPERTY LINES.

PREPARED FOR:

ELDER RANCH, LLC
38131 SODHOUSE LANE
PRINCETON, OR 97721

PREPARED BY:



ALL POINTS ENGINEERING AND SURVEYING, INC.
P.O. BOX 767
(541) 548-5833
TERREBONNE, OR 97760
www.APEandS.com