

BEFORE THE OREGON WATER RESOURCES DEPARTMENT

IN THE MATTER OF THE PROPOSED CANCELLATION OF A	)	NOTICE OF PROPOSED
PORTION OF WATER RIGHT CERTIFICATE 10234, IN THE	)	CANCELLATION OF WATER
NAME OF JOHN BUCHANAN, FOR USE OF WATER FROM	)	RIGHTS
FISH AND DRY CREEKS, AND A PORTION OF WATER RIGHT	)	
CERTIFICATE 66170, IN THE NAME OF DARRELL L	)	
BIGELOW, FOR USE OF WATER FROM LONG BRANCH	)	
CREEK, BAKER COUNTY, OREGON	)	
	)	
	)	

TO: **Legal Owner, Baker County, Oregon tax lot 200, map 08S46:** Stacy Jane Romo, PO Box 895, Halfway, OR 97834

Occupant, Baker County, Oregon tax lot 200, map 08S46: Current Occupant, 40774 Buchanan Loop, Halfway, OR 97834

Summary: Pursuant to the provisions of Oregon Revised Statutes (ORS) 183.415 and ORS 540.631, you are hereby notified as the legal owner and/or occupant of certain real property in Section 12, Township 8 South, Range 46 East, Willamette Meridian, Baker County, Oregon, of the proposed cancellation of the following water rights: (1) a portion of the irrigation, domestic, and stock water right evidenced by Certificate 10234, in the name of John Buchanan; and (2) a portion of the irrigation and supplemental irrigation water right evidenced by Certificate 66170, in the name of Darrell L Bigelow. You are also notified of your right to file a protest and receive a contested case hearing on the proposed cancellations.

A. Jurisdiction and Authority

ORS 540.631 and 540.641 grant the Oregon Water Resources Commission (Commission) jurisdiction and authority to issue notices of proposed cancelation of perfected water rights, hold hearings on protests of such notices, and issue orders canceling perfected water rights that have been forfeited by nonuse. The Commission has delegated its authority with respect to cancellation of perfected water rights to the Oregon Water Resources Department (Department). OAR chapter 690, division 17.

B. Applicable Law

Oregon water law provides that if any portion of a water right undergoes five or more successive years of nonuse, that nonuse creates a rebuttable presumption of forfeiture. ORS 540.610; ORS 540.631.

A presumption of forfeiture may be rebutted by evidence submitted in a protest and by evidence you may submit in a contested case hearing. ORS 540.610(2); OAR 690-017-0600 and -0800. Water rights are also exempt from forfeiture under certain circumstances outlined in ORS 540.610(3), 540.610(4), and 540.612.

Other applicable law includes ORS 540.610 through ORS 540.670, OAR chapter 690 division 17 (governing water right cancellation), OAR 690-320-0070(1) (requiring proposed cancellation of supplemental irrigation water rights where the Department proposes cancellation of primary irrigation water rights for the same lands), ORS Chapter 183 and OAR 137-003-0501 through -0700 (governing contested case hearings) and OAR 690-002-0000 through -0235 (governing protests, hearings, and exceptions).

C. Proposed Cancellation

Findings of Fact

Water Rights Proposed to Be Canceled for Nonuse

1. The first water right for which cancellation is proposed is a portion of Water Right **Certificate 10234**, in the name of John Buchanan. The entirety of Certificate 10234 authorizes use of up to 1/40th cubic feet per second per acre from Fish Creek and Dry Creeks, tributaries of Pine Creek, for Tract Nos. 1 and 2, and Pine Creek for Tract No. 3, for irrigation, domestic and stock use at the following place of use:

Tract No. 1

33.0 acres in the NE $\frac{1}{4}$ NE $\frac{1}{4}$
13.5 acres in the SW $\frac{1}{4}$ NE $\frac{1}{4}$
20.0 acres in the SE $\frac{1}{4}$ NE $\frac{1}{4}$
Section 12, Township 8 South, Range 46 East, Willamette Meridian (W.M.).

Tract No. 2

15.0 acres in the SE $\frac{1}{4}$ SE $\frac{1}{4}$
Section 1, Township 8 South, Range 46 East, W.M.

Tract No. 3

5.3 acres in the SE $\frac{1}{4}$ SE $\frac{1}{4}$
12.0 acres in the SW $\frac{1}{4}$ SE $\frac{1}{4}$
Section 7, Township 8 South, Range 47 East, W.M.
2.0 acres in the NE $\frac{1}{4}$ NE $\frac{1}{4}$
6.0 acres in the NW $\frac{1}{4}$ NE $\frac{1}{4}$

Section 18, Township 8 South, Range 47 East, W.M.

The priority date is 1882 for Tract No. 1; 1887 for Tract No. 2; and 1900 for Tract No. 3.

A copy of Water Right Certificate 10234 is attached.

The portion of Certificate 10234 proposed to be canceled is:

6.0 acres in the SW $\frac{1}{4}$ NE $\frac{1}{4}$

Section 12, Township 8 South, Range 46 East, W.M.

The location of the portion of Certificate 10234 proposed to be cancelled is further defined on the Baker County tax plat map and Department online map-viewer map attached to this notice that were submitted to the Department with the affidavits asserting nonuse described below.

2. The second water right for which cancellation is proposed is a portion of Water Right **Certificate 66170**, in the name of Darrell L. Bigelow. The entirety of Certificate 66170 authorizes use of up to 1.96 cubic feet per second from Long Branch Creek, tributary to Pine Creek, for primary irrigation and supplemental irrigation use at the following place of use:

Primary Irrigation

3.6 acres in the NE $\frac{1}{4}$ NE $\frac{1}{4}$

0.2 acres in the SE $\frac{1}{4}$ NE $\frac{1}{4}$

Section 12, Township 8 South, Range 46 East, W.M.

Supplemental Irrigation

12.9 acres in the SE $\frac{1}{4}$ SE $\frac{1}{4}$

Section 1, Township 8 South, Range 46 East, W.M

33.0 acres in the NE $\frac{1}{4}$ NE $\frac{1}{4}$

9.3 acres in the SW $\frac{1}{4}$ NE $\frac{1}{4}$

19.3 acres in the SE $\frac{1}{4}$ NE $\frac{1}{4}$

Section 12, Township 8 South, Range 46 East, W.M. The place of use is further defined by the attached certificate map.

The priority date is October 2, 1985.

A copy of Water Right Certificate 66170 and its certificate map are attached.

The portion of Certificate 66170 proposed to be canceled is:

1.8 acres in the SW $\frac{1}{4}$ NE $\frac{1}{4}$

Section 12, Township 8 South, Range 46 East, W.M., being the portion of the 9.3 acres of supplemental irrigation Certificate 66170 authorizes in the SW $\frac{1}{4}$ NE $\frac{1}{4}$ of Section 12, Township 8 South, Range 46 East, W.M. that overlaps with the 6.0 acres of primary irrigation authorized by Certificate 10234 in the SW $\frac{1}{4}$ NE $\frac{1}{4}$ of Section 12, Township 8 South, Range 46 East, W.M. proposed for cancellation herein.

The Affidavits

3. It is asserted in an affidavit filed with the Department by Darryl R Peer on March 20, 2026, that the portion of Certificate 10234 proposed to be cancelled has been forfeited due to nonuse for irrigation, domestic, and stock use from 1984 through 2024, and that none of the lands to which the portion of Certificate 10234 proposed to be cancelled is appurtenant have been irrigated during that time.
4. It is asserted in an affidavit filed with the Department by Darrell B Martin on March 20, 2026, that the portion of Certificate 10234 proposed to be cancelled has been forfeited due to nonuse for irrigation, domestic, and stock use from 1983 through 2024, and that none of the lands to which the portion of Certificate 10234 proposed to be cancelled is appurtenant have been irrigated during that time.
5. It is asserted in an affidavit filed with the Department by George L Gover on March 20, 2026, that the portion of Certificate 10234 proposed to be cancelled has been forfeited due to nonuse for irrigation, domestic, and stock use from March 2006 through 2024, and that none of the lands to which the portion of Certificate 10234 proposed to be cancelled is appurtenant have been irrigated during that time.
6. It is asserted in an affidavit filed with the Department by Ronald R Still Jr on March 20, 2026, that the portion of Certificate 10234 proposed to be cancelled has been forfeited due to nonuse for irrigation, domestic, and stock use from 2003 through 2024, and that none of the lands to which the portion of Certificate 10234 proposed to be cancelled is appurtenant have been irrigated during that time.
7. It is asserted in an affidavit filed with the Department by Barbara J Dion on March 20, 2026, that the portion of Certificate 10234 proposed to be cancelled has been forfeited due to nonuse for irrigation, domestic, and stock use from May 2010 through December 2024, and that none of the lands to which the portion of Certificate 10234 proposed to be cancelled is appurtenant have been irrigated during that time.

8. Copies of the affidavits asserting nonuse are available from the Department upon request.

Location of Portions of Certificate 10234 and Certificate 66170 Proposed to be Cancelled

9. The portions of Certificates 10234 and 66170 proposed to be cancelled are located within Baker County, Oregon tax lot 200, map 08S46.
10. Records of the Baker County Assessor indicate that Stacy Jane Romo is the owner of Baker County, Oregon tax lot 200, map 08S46. Stacy Jane Romo's last address of record with the Baker County Assessor is PO Box 895, Halfway, OR 97834. Records of the Douglas County Assessor indicate that the physical address of Baker County, Oregon tax lot 200, map 08S46 is 40774 Buchanan Loop, Halfway, OR 97834.

Conclusion of Law

1. The information before the Department creates a rebuttable presumption that the portions of Certificates 10234 and 66170 proposed to be cancelled have been forfeited by nonuse. ORS 540.631; OAR 690-017-0400.
2. Based on the information currently before the Department, it does not appear that the presumption of forfeiture would be rebutted under ORS 540.610(2) or that the water rights proposed to be cancelled are exempt from forfeiture under ORS 540.610(3), 540.610(4), or 540.612.
3. Because the Department is proposing to cancel a portion of Certificate 10234 and the portion of Certificate 10234 proposed to be cancelled authorizes primary irrigation of certain lands, the Department must also propose to cancel the portion of Certificate 66170 that authorizes supplemental irrigation of those lands. OAR 690-320-0070(1).

Proposed Cancellation

The Department proposes to issue an order cancelling the portions of Certificates 10234 and 66170 described above.

Pursuant to ORS 536.077(4) and (5), ORS 540.641(2), OAR 690-017-0600(1) and OAR 690-002-0235(4), if no protest of this Notice of Proposed Cancellation is received by November 18, 2026, and the Department does not withdraw this Notice of Proposed Cancellation on or before December 21, 2026, this Notice of Proposed Cancellation is a final order without any further action by the Department on December 21, 2026.

D. Notice of Right to Request a Contested Case Hearing by Protesting the Proposed Cancellation and Right to File a Request for Party Status

The following sections explain how to: (1) file a protest in opposition to this Notice of Proposed Cancellation to request a contested case hearing on this Notice of Proposed Cancellation; and (2) file a request for party status to request to participate in any contested case proceeding in support of this Notice of Proposed Cancellation.

Protests

Under the provisions of ORS 540.641(2), ORS 536.077(1) and OAR 690-017-0600, as the owner or occupant of land to which the water rights proposed to be cancelled are appurtenant, you have the right to a contested case hearing on the matters asserted in this Notice of Proposed Cancellation. To request a contested case hearing, you must file a written protest setting forth the reasons why the water rights specified in this Notice should not be cancelled.

The information before the Department, if not countered by other evidence, establishes at least five successive years of nonuse of the water rights proposed to be cancelled. In your protest and at a hearing you may attempt to show either that water use has occurred during the asserted period of nonuse or that one or more statutorily established reasons excusing nonuse stated in ORS 540.610(2) and further defined in OAR 690-017-0800 or an exemption from forfeiture stated in ORS 540.610(3), 540.610(4), or 540.612 apply.

Protests and protest fees may be mailed or hand delivered to the Oregon Water Resources Department at 725 Summer Street NE, Suite A, Salem, OR 97301. If you submit a protest by U.S. mail, please consider mailing early to ensure the Department receives the protest by the deadline. Protests may be emailed to will.d.davidson@water.oregon.gov, but payment of Protest fees cannot be accepted electronically and must be received by the Department by mail or hand delivery prior to the deadline. Protests and protest fees must be received by the Water Resources Department no later than November 18, 2026.

Protests must meet the following requirements:

- Be in writing;
- Include the protestant's name, address, telephone number, and email address, if the protestant has an email address;
- Include the name, address, telephone number, and email address of the protestant's attorney, if the protestant is represented by an attorney;

- Include a description of the protestant's interest in the Notice of Proposed Cancellation, and, if the protestant claims to represent the public interest, a precise statement of the public interest represented;
- Include a detailed description of how the action proposed in the Notice of Proposed Cancellation would impair or be detrimental to the protestant's interest and/or the claimed public interest;
- Identify which of the Notice of Proposed Cancellation's recommended findings of fact and/or conclusions of law the protestant objects to;
- Include a written statement citing the reasons the protestant believes the water right has not been forfeited by nonuse;
- Where the protestant intends to rebut the presumption of forfeiture by claiming one or more of the grounds for rebuttal established in ORS 540.610(2) and further defined in OAR 690-017-0800, or an exemption from forfeiture established by ORS 540.610(3), 540.610(4) or 540.612, include a statement of the grounds claimed for rebuttal or exemption and appropriate supporting documentation;
- Where applicable, include documentary evidence in support of the rebuttal as described in OAR 690-017-0800(3);
- Raise all reasonably ascertainable issues and include all reasonable available arguments that support the protestant's position;
- Include any citation of legal authority to support the protest, if known;
- Explain how the issues raised in the protest are within the Department's jurisdiction; and
- Include a protest fee of \$1,425 required by ORS 536.077(1)(c)(G) and 536.050.

If you file a protest and the Department determines the presumption of forfeiture has not been rebutted or an exemption from forfeiture has not been established, the Department will provide a contested case hearing on the proposed cancellation at an appropriate time. You will be notified of the time and place of the hearing. You will also be given information on the procedures, right of representation and other rights of parties relating to the conduct of the hearing.

Requests for Party Status

Under the provisions of ORS 540.641(2), ORS 536.077(2) and OAR 690-017-0600, if this Notice of Proposed Cancellation is protested, any person who supports this Notice of Proposed Cancellation may file a request for party status to request to participate in any contested case proceeding on this Notice of Proposed Cancellation or for judicial review of a final order

resulting from this Notice of Proposed Cancellation. The individuals who filed the affidavits asserting nonuse upon which this Notice of Proposed Cancellation is based will be parties to any contested case proceeding on this Notice of Proposed Cancellation without the need to file requests for party status. Requests for party status and request for party status fees may be mailed or hand delivered to the Oregon Water Resources Department at 725 Summer Street NE, Suite A, Salem, OR 97301. If you submit a request for party status by U.S. mail, please consider mailing early to ensure the Department receives the request by the deadline. Requests for party status may be emailed to will.d.davidson@water.oregon.gov, but payment of request for party status fees cannot be accepted electronically and must be received by the Department by mail or hand delivery prior to the deadline. Requests for party status and request for party status fees must be received by the Water Resources Department no later than December 18, 2026.

Requests for party status must be in writing and include the following:

- Names, addresses, and email addresses (if any) of the requestor and any organization the requestor represents;
- Name, address, and email address of the requestor's attorney, if any;
- A statement of whether the request is for participation as a party or a limited party, and, if as a limited party, the precise area or areas in which participation is sought;
- If the requester seeks to protect a personal interest in the outcome of any contested case hearing on the Notice of Proposed Cancellation, a detailed statement of the requester's interest, economic or otherwise, and how such interest may be affected by the results of the hearing;
- If the requester seeks to represent a public interest in the results of any contested case hearing on the Notice of Proposed Cancellation, a detailed statement of such public interest, the manner in which such public interest will be affected by the results of the hearing, and the requester's qualifications to represent such public interest;
- A statement of the reasons why existing parties to the proceeding cannot adequately represent the private and/or public interest(s) the requester seeks to represent; and
- The request for party status fee of \$1,425 required by ORS 536.077(2)(b)(C) and ORS 536.050.

After the deadline for requests for party status, the Department will provide copies of any timely requests for party status, accept responses to requests for party status, and consider and rule on timely requests for party status as provided in OAR 690-002-0225.

E. Additional Notices

Notice of Right to Request Voluntary Cancellation: Holders of a water right may voluntarily relinquish their water right by filing a notarized authorization to cancel with the Water Resources Department. ORS 540.621. If you decide to authorize voluntary cancellation of the water rights or portion thereof appurtenant to your land, you do not need to file a protest. You should contact the Department or your local watermaster for the proper Affidavit of Voluntary Cancellation or Diminution of a Water Right Certificate form.

Notice of the Circumstances under which this Notice of Proposed Cancellation Will Become a Final Order: If no protest of this Notice of Proposed Cancellation is timely received and the Department does not withdraw this Notice of Proposed Cancellation for reconsideration within 33 days after the close of the period for submitting a protest, this Notice of Proposed Cancellation will become a final order on the date that is 33 days after the close of the period for submitting a protest, with no further action required by the Department. If a protest or protests are timely received, but later: (1) all timely-filed protests are withdrawn and the withdrawals are not based on a settlement agreement requiring changes to this Notice of Proposed Cancellation; (2) all protestants fail to appear at a scheduled hearing; or (3) all protestants notify the Department or the administrative law judge that the protestants will not appear at a scheduled hearing, the protestants will have waived any right to a hearing, and the Department or the administrative law judge will issue an order dismissing the protests and notifying the parties that this Notice of Proposed Cancellation has become a final order. OAR 690-002-0235; OAR 137-003-0672. The Department designates the relevant portions of its file on this matter, including all materials that you have submitted relating to this matter, as the record for the purpose of proving a prima facie case upon default. OAR 137-003-0672.

Notice of Right to be Represented by an Attorney: You may be represented by an attorney at any contested case hearing on this Notice of Proposed Cancellation. Parties are sometimes, but not always, represented by attorneys in cancellation hearings, and the Department may be represented by an attorney. Generally, partnerships, corporations, associations, governmental subdivisions, or public or private organizations must be represented by an attorney. OAR 137-003-0550. However, consistent with OAR 690-002-0020 and OAR 137-003-0555, an “authorized representative” as defined at OAR 137-003-0555(1)(b) may represent a partnership, corporation, association, governmental subdivision or public or private organization if the Department determines that the appearance of a person by an authorized representative will not hinder the orderly and timely development of the record.

Notice to Active Duty Servicemembers: Active duty Servicemembers have a right to stay these proceedings under the federal Servicemembers Civil Relief Act. For more information, contact the Oregon State Bar at 800-452-8260, the Oregon Military Department at 971-355-4127, or the nearest United States Armed Forces Legal Assistance Office through

<http://legalassistance.law.af.mil>. The Oregon Military Department does not have a toll-free telephone number.

DATED September 16, 2026

A handwritten signature in black ink that reads "Katherine Ratcliffe". The signature is written in a cursive, flowing style.

Katherine Ratcliffe, Administrator
Water Right Services Division
for Ivan Gall, Director
Oregon Water Resources Department

If you have questions about this Notice of Proposed Cancellation or how to file a protest or a request for party status, or if you have previously filed a protest or a request for party status and you would like to know the status, please contact Will Davidson at 503-507-2749 or will.davidson@water.oregon.gov.

If you have questions about the Department or any of its programs, please contact our Water Resources Customer Service Group at 503-986-0900.

STATE OF OREGON

COUNTY OF BAKER

CERTIFICATE OF WATER RIGHT

This is to Certify, That JOHN BUCHANAN

of Halfway, State of Oregon has a right to the use of

the waters of Fish Creek and Dry Creek, tributaries of Pine Creek, for Tract Nos. 1 and 2; and Pine Creek for Tract No. 3, for the purpose of Irrigation of 66.5 acres, domestic & stock use for Tr. No. 1; Irr. of 15 acs., dom. & stock use for Tract No. 2, and Irr. 25.3 acs. & Dom. use for Tr. No. 3. and that said right has been confirmed by decree of the Circuit Court of the State of Oregon for Baker County, and the said decree entered of record at Salem, in the Order Record of the STATE ENGINEER, in Volume 11, at page 235; that the priority of the right thereby confirmed dates from 1882 for Tract No. 1; 1887 for Tract No. 2, and 1900 for Tract No. 3;

that the amount of water to which such right is entitled, for the purposes aforesaid, is limited to an amount actually beneficially used for said purposes, and shall not exceed one-fortieth of a cubic foot per second per acre, measured at the point of diversion, and a total limitation of one acre-foot per acre during July, one acre-foot per acre during August, and one-half acre-foot per acre during September, of each year.

A description of the lands irrigated under such right, and to which the water is appurtenant (or, if for other purposes, the place where such water is put to beneficial use), is as follows:

TRACT No. 1

33.0 acres in NE $\frac{1}{4}$ NE $\frac{1}{4}$
13.5 acres in SE $\frac{1}{4}$ NE $\frac{1}{4}$
20.0 acres in SE $\frac{1}{4}$ NE $\frac{1}{4}$,
Section 12,
Township 8 South, Range 46 East, W.M.

TRACT No. 2

15.0 acres in SE $\frac{1}{4}$ SE $\frac{1}{4}$.
Section 1,
Township 8 South, Range 46 East, W.M.

TRACT No. 3

5.3 acres in SE $\frac{1}{4}$ SE $\frac{1}{4}$
12.0 acres in SW $\frac{1}{4}$ SE $\frac{1}{4}$
Section 7,
2.0 acres in NE $\frac{1}{4}$ NE $\frac{1}{4}$
6.0 acres in NW $\frac{1}{4}$ NE $\frac{1}{4}$
Section 18,
Township 8 South, Range 47 East, W.M.

AND said right shall be subject to all other conditions and limitations contained in said Decree.

The right to the use of the water for irrigation purposes is restricted to the lands or place of use herein described.

WITNESS the signature of the State Engineer,

affixed this 18th day

of October, 1913.

CHAS. E. STRICKLIN

State Engineer.

STATE OF OREGON
COUNTY OF BAKER
CERTIFICATE OF WATER RIGHT

THIS CERTIFICATE ISSUED TO

DARRELL L. BIGELOW
ROUTE 1 BOX 82
HALFWAY, OREGON 97834

confirms the right to use the waters of LONG BRANCH CREEK, a tributary of PINE CREEK, for the purpose of PRIMARY IRRIGATION OF 3.8 ACRES AND SUPPLEMENTAL IRRIGATION OF 74.5 ACRES.

The right has been perfected under Permit 49591. The date of priority is OCTOBER 2, 1985. The right is limited to not more than 1.96 CUBIC FEET PER SECOND or its equivalent in case of rotation, measured at the point of diversion from the source.

The point of diversion is located as follows:

NE 1/4 SW 1/4, SECTION 6, T 8 S, R 47 E, W.M.; 2500 FEET NORTH AND 2120 FEET EAST FROM THE SW CORNER OF SECTION 6.

The amount of water used for irrigation, together with the amount secured under any other right existing for the same lands, shall be limited to ONE-FORTIETH of one cubic foot per second per acre, or its equivalent for each acre irrigated and shall be further limited to a diversion of not to exceed 4.5 acre-feet per acre for each acre irrigated during the irrigation season of each year.

This right is limited to any deficiency in the available supply of any prior right existing for the same land.

The right shall conform to such reasonable rotation system as may be ordered by the proper state officer.

A description of the place of use under the right, and to which such right is appurtenant, is as follows:

<u>PRIMARY</u>	<u>SUPPLEMENTAL</u>
NE 1/4 NE 1/4 3.6 ACRES	SE 1/4 SE 1/4 12.9 ACRES SECTION 1
SE 1/4 NE 1/4 0.2 ACRE SECTION 12	NE 1/4 NE 1/4 33.0 ACRES SW 1/4 NE 1/4 9.3 ACRES SE 1/4 NE 1/4 19.3 ACRES SECTION 12

TOWNSHIP 8 SOUTH, RANGE 46 EAST, W.M.

The right to the use of the water for the above purpose is restricted to beneficial use on the lands or place of use described. The right is subject to minimum flows established by the Water Resources Commission with an effective date prior to this right.


WITNESS the signature of the Water Resources Director, affixed
JUNE 21, 1991.

/s/ WILLIAM H. YOUNG
William H. Young

Recorded in State Record of Water Right Certificates numbered 66170.
68584.VC

T.8S., R.47E., W.M.

T. 8 S., R. 46 E., W.M.

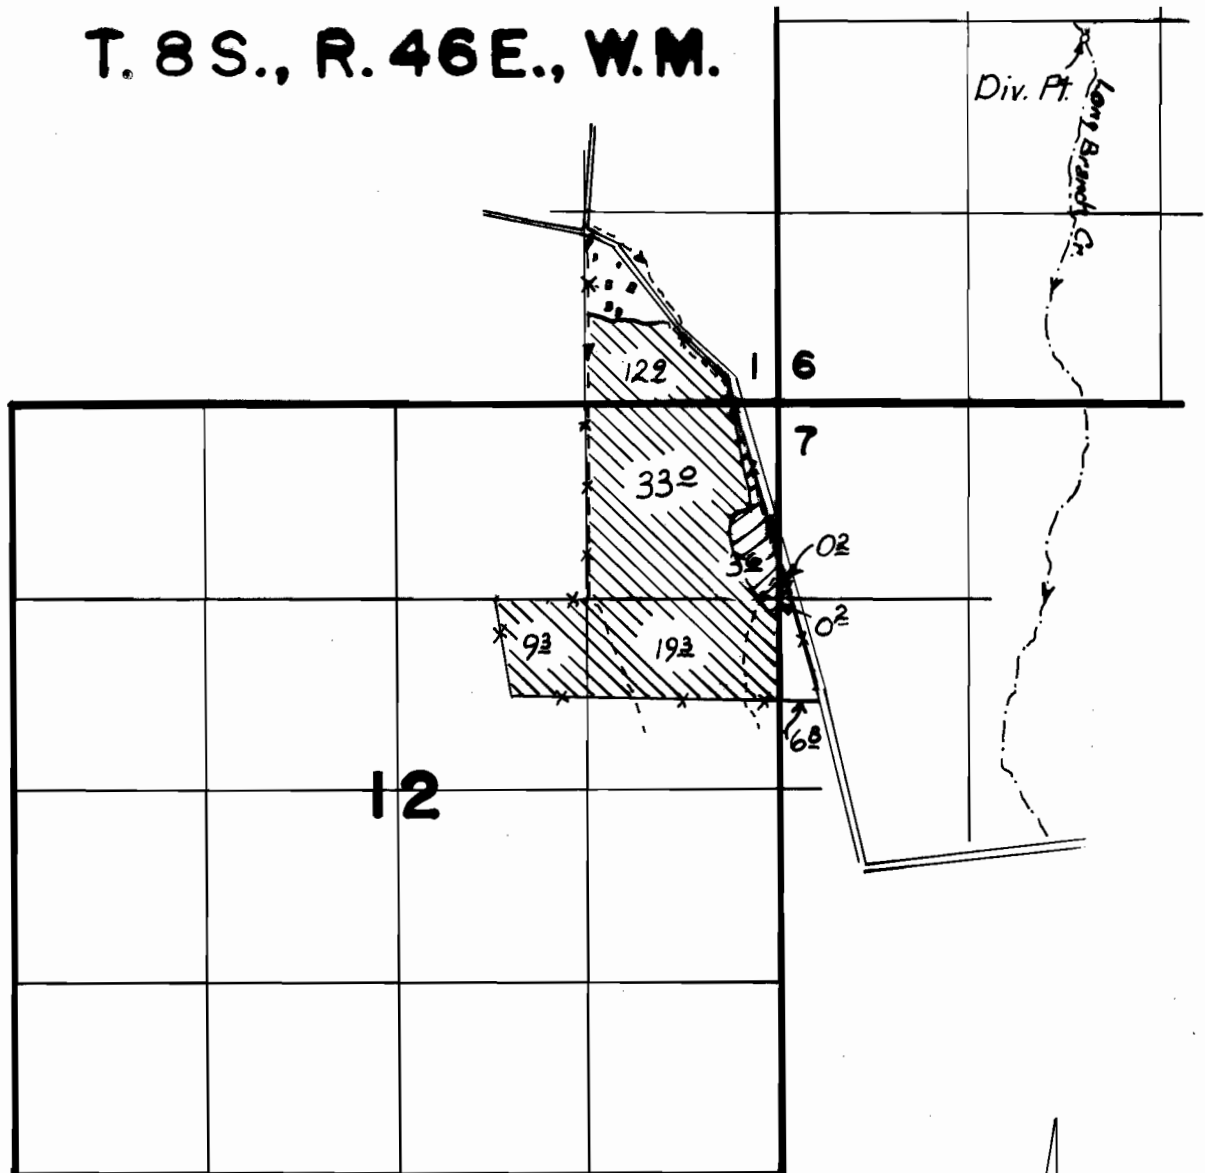

Location of div. pt. is 2500' N. & 2120' E. from the
SW cor. of sec. 6, T. 8 S., R. 47 E.

FINAL PROOF SURVEY

UNDER

Scale 1" = 1320'

Application No. ~~68584~~ Permit No. 49591.....
IN NAME OF

DARRELL L. BIGELOW


Surveyed 8-24 1988, by Kenn Kemp

Primary



Supplemental



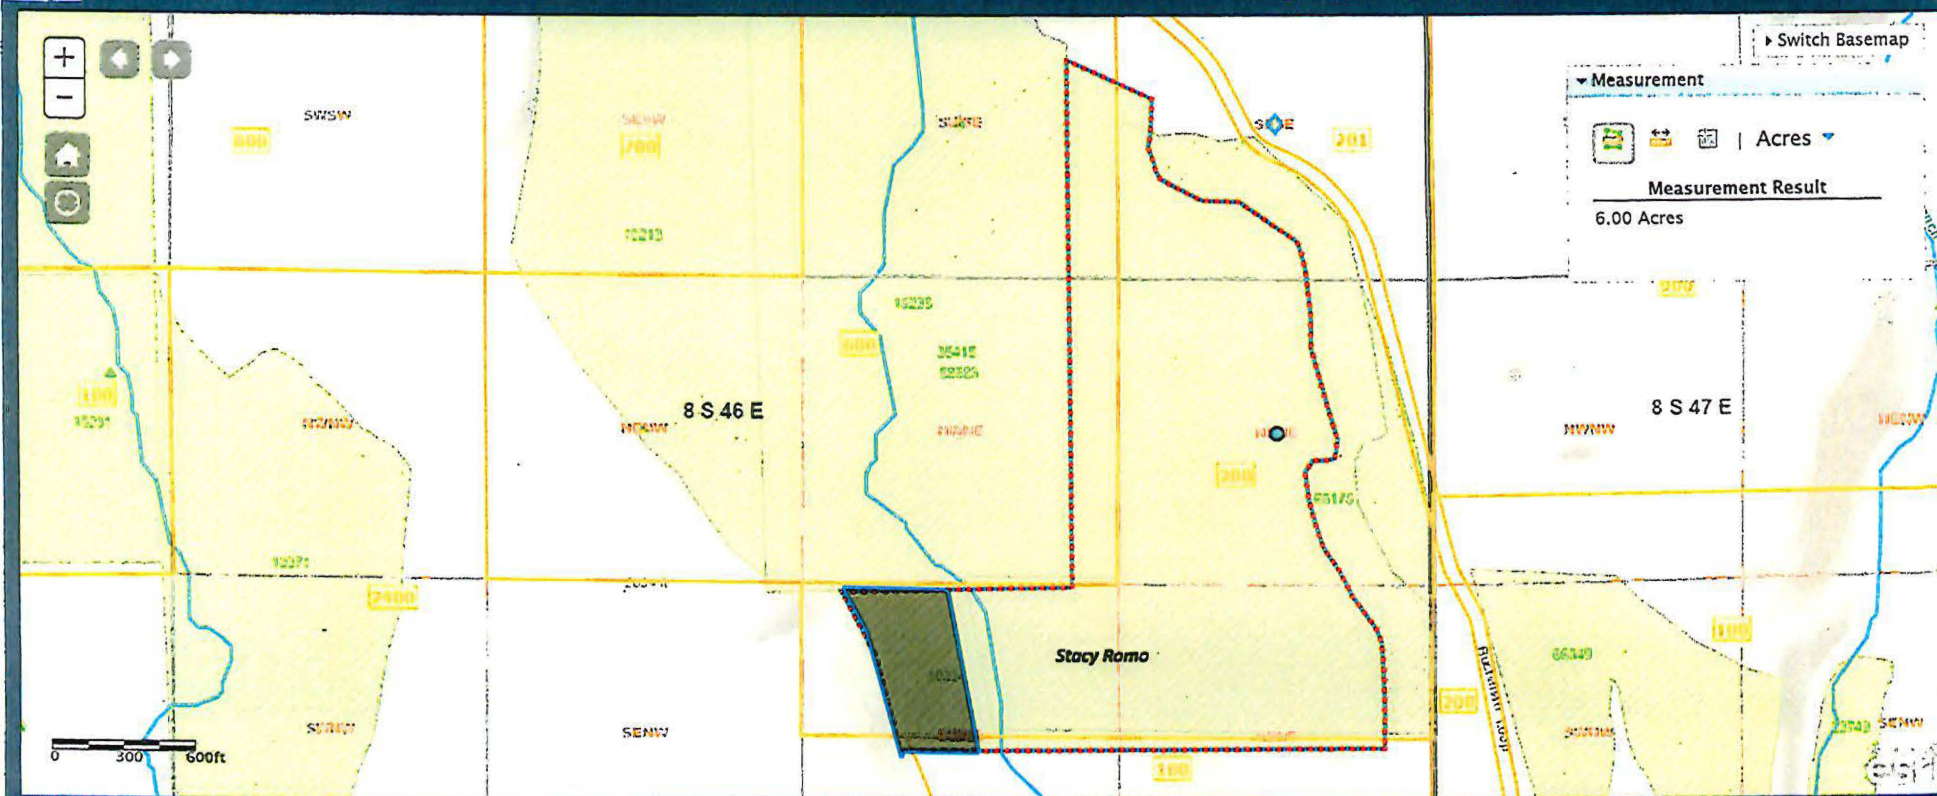

POD POU

#	ID (select)	WRIS	Zoom	Water Right	Water Type	First Name	Last Name	Company	Use Desc.	Priority Date	Supp.	Application	Permit	Certificate	Transfer	Claim
1	15000	Details	Map View	Cert:10234 OR * I*	SW	JOHN	BUCHANAN		IRRIGATION, LIVESTOCK AND D...	12/31/1882 -				10234		

Received
 MAR 20 2026
 OWRD

THIS MAP WAS PREPARED FOR
ASSESSMENT PURPOSE ONLY

0 1,000 2,000 3,000 4,000 Feet

T.8S. R.46E. W.M.
BAKER COUNTY

1" = 2000'

08S46E
& INDEX

Cancelled
800A1
4200

Stacy Roma


C 10234

6 Acres

See next

Page

Received
MAR 20 2017
OWRD

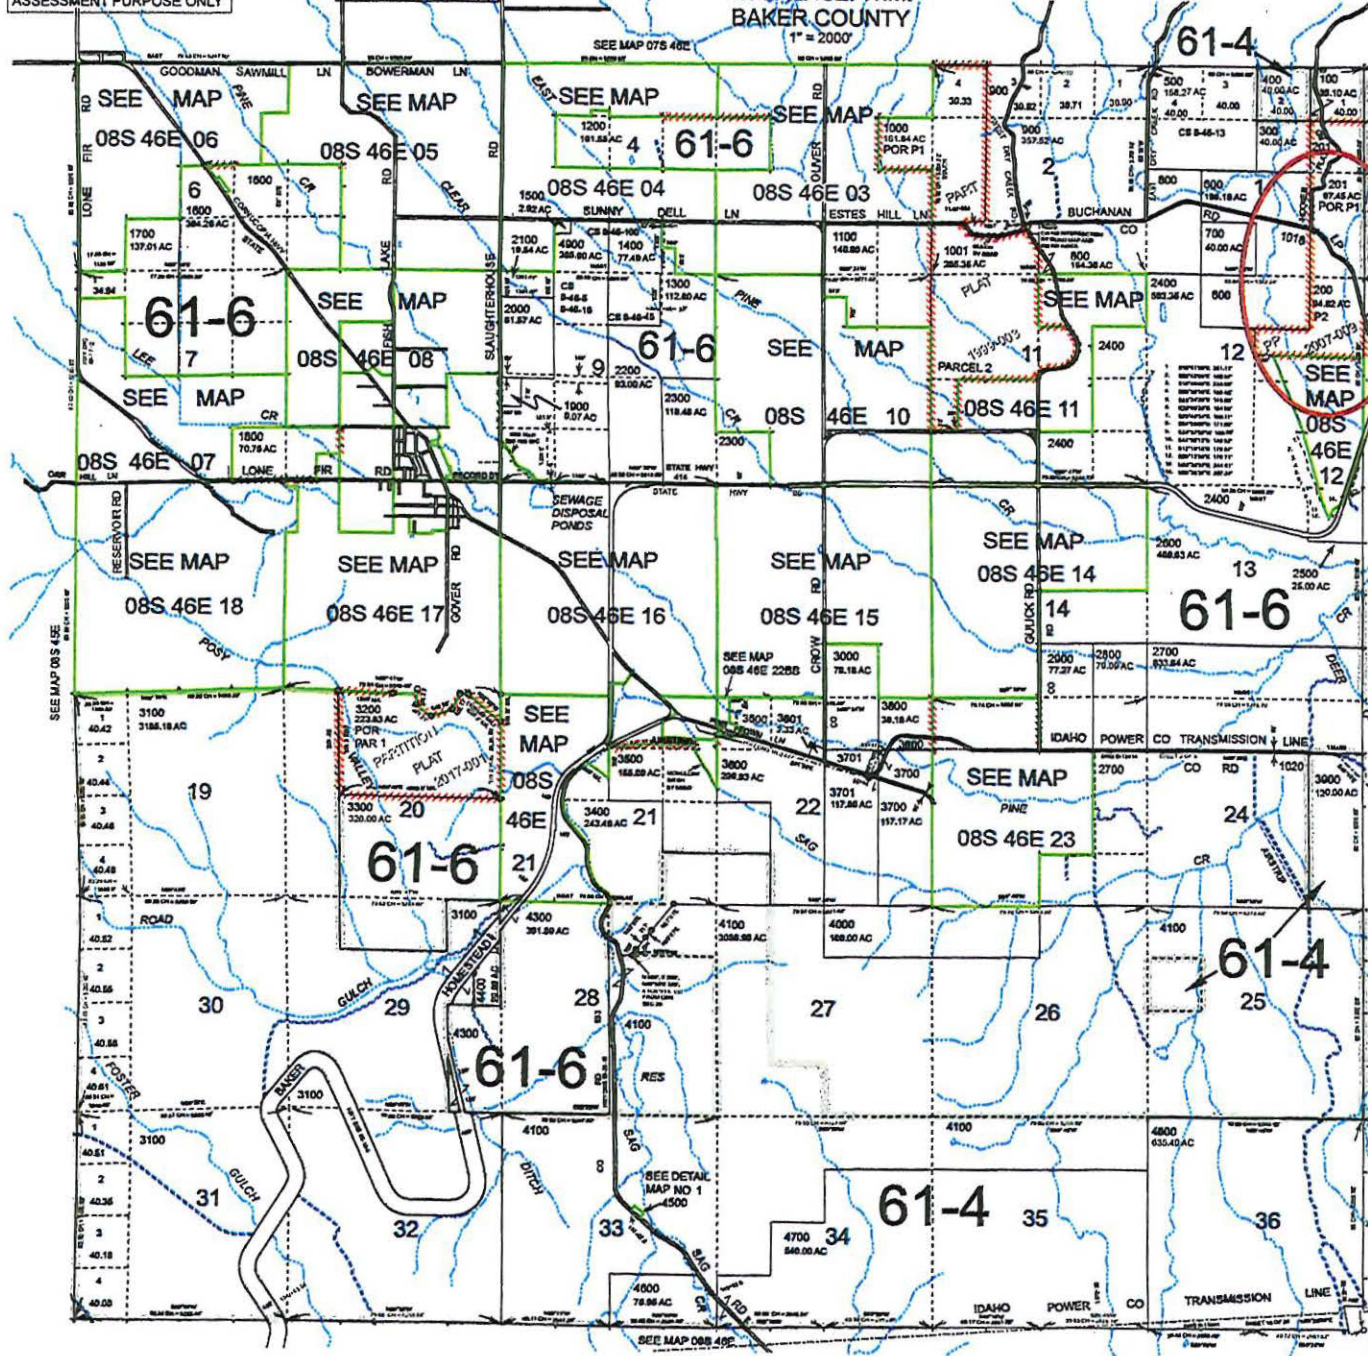

Revised: MA
03/15/2023

& INDEX
08S46E

100 3,000 4,000 Feet

T.8S. R.46E. W.M.
BAKER COUNTY

1" = 2000'

08S46E
& INDEX


Cancelled
800A1
4200

Area of Non-use

6 acres

Stacy Romo

C10234

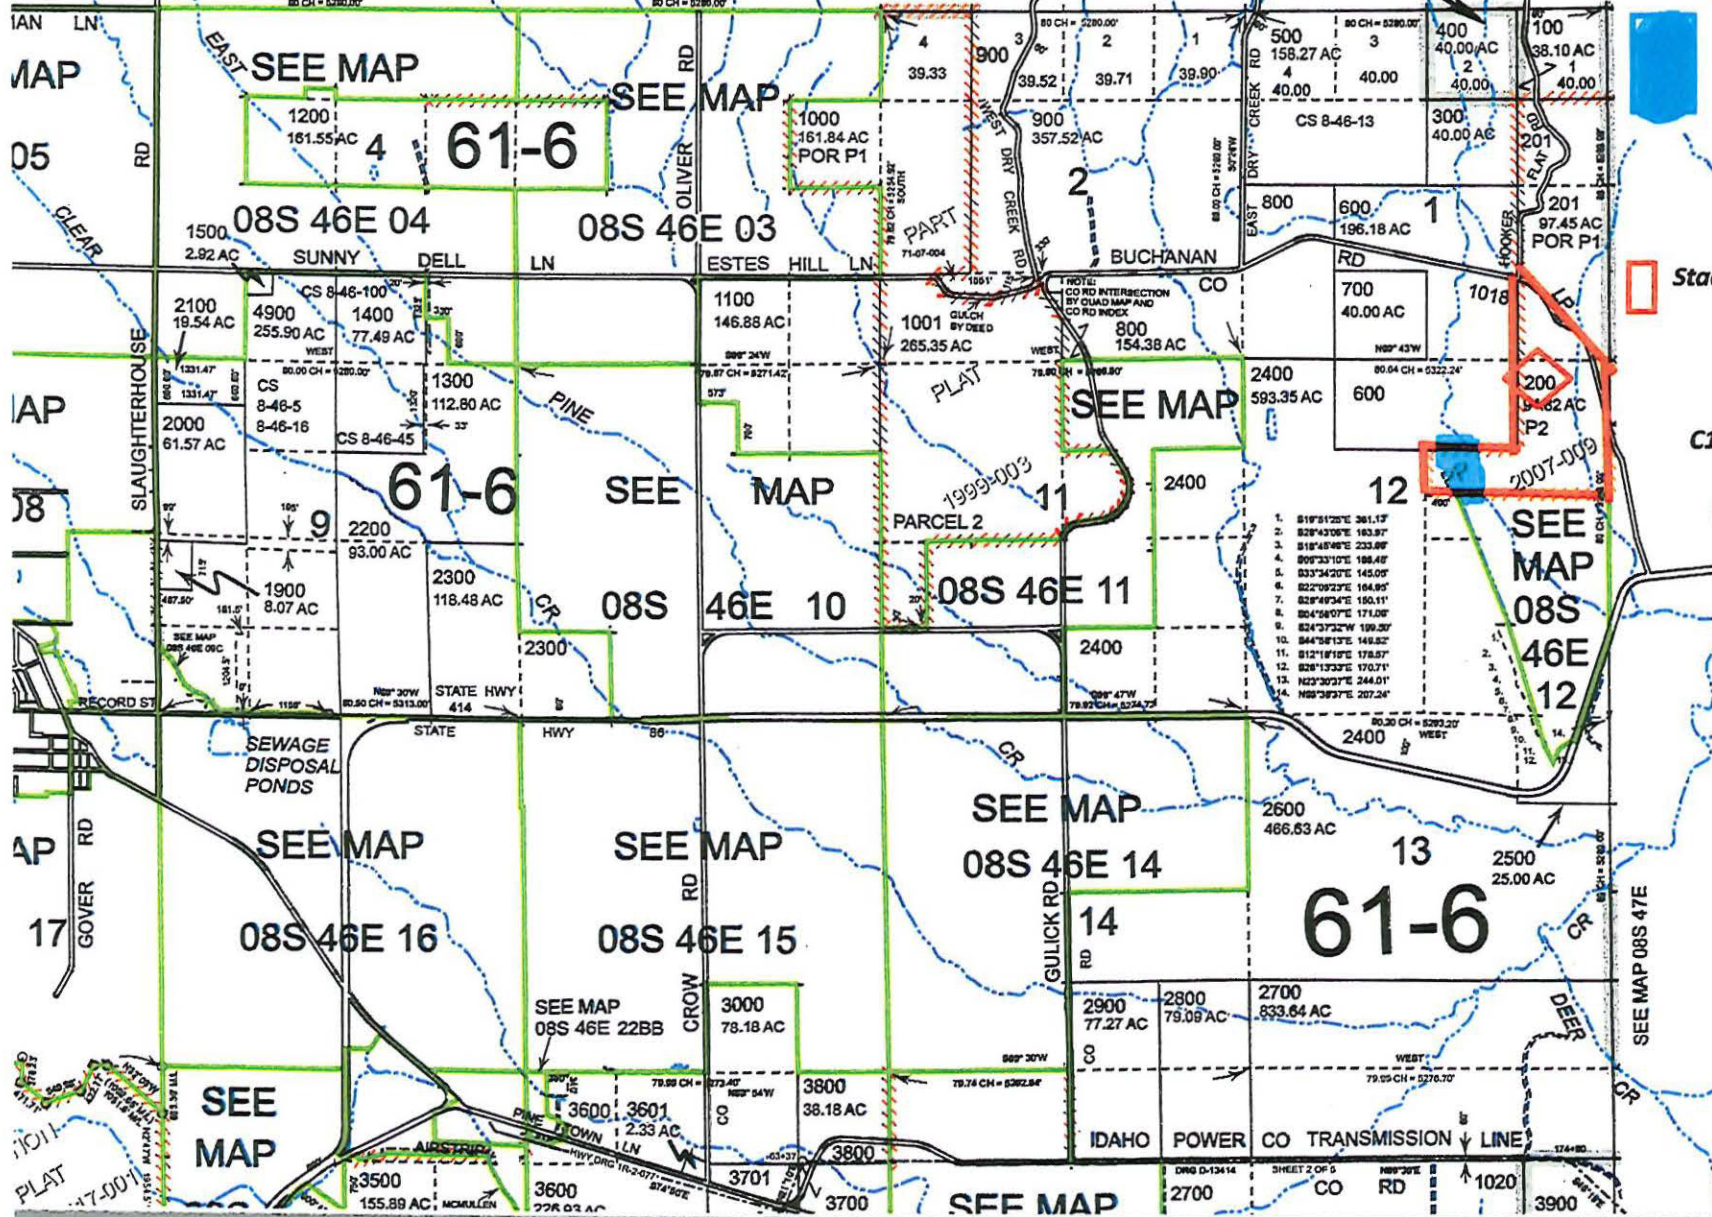

MAR 20 2026

OWRD

Received

CERTIFICATE OF MAILING/SERVICE

I certify that on September 17, 2026, I served this Notice of Proposed Cancellation of Water Rights, including the attached water right certificates, certificate map, and other maps, by certified mail, return receipt requested, regular mail, postage prepaid, and email upon the persons listed below:

Certified mail, article #: 9589 0710 5270 3706 8582 86

Stacy Jane Romo
PO Box 895
Halfway, OR 97834

Certified mail, article #: 9589 0710 5270 3706 8583 09

Current Occupant
40774 Buchanan Loop
Halfway, OR 97834

Regular mail:

Darrell B Martin
39208 Pine Town Lane
Halfway, OR 97834

Email:

Barbara J Dion
bjdion@outlook.com

Ronald R Still Jr
still@pinetel.com

George L Gover
george.gover@yahoo.com

Darryl R Peer
darrylpeer@gmail.com

*/s/ Will Davidson*_____

Will Davidson
Oregon Water Resources Department