


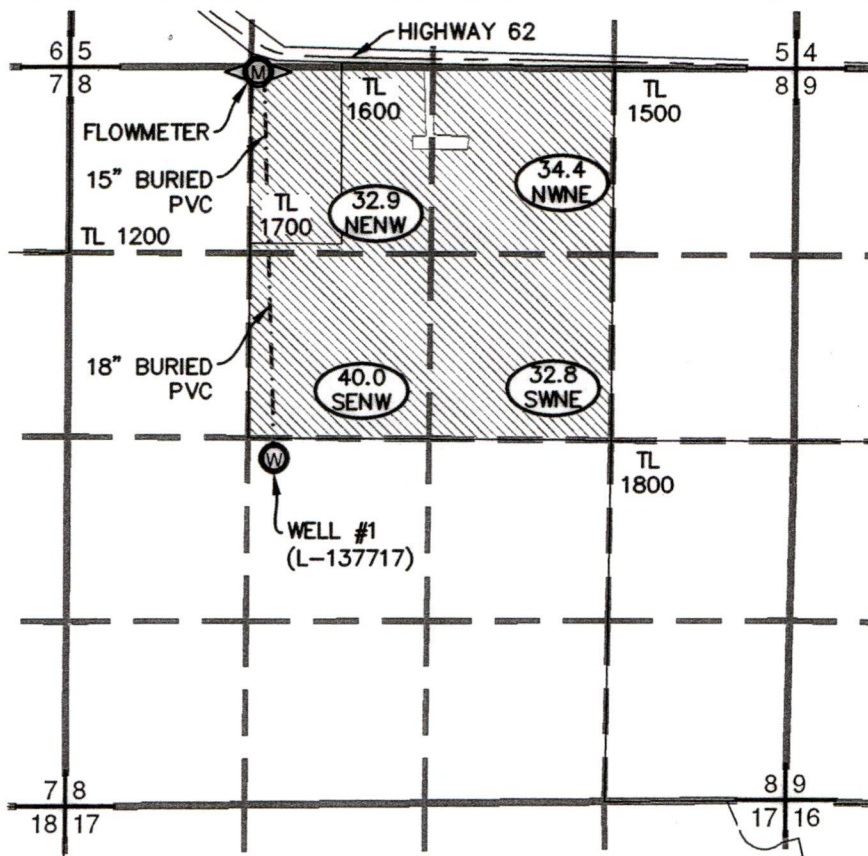

LEGEND	
	SECTION LINE
	1/4 1/4 LINE
	TAX LOT LINE
	ROAD
	BURIED PIPE
	SECTION CORNER
	TAX LOT NUMBER
	WELL
	FLOWMETER
	SUPPLEMENTAL IRRIGATION UNDER TRANSFER T-13351
	SUPPLEMENTAL IRRIGATION ACRES
	1/4 1/4 SECTION

NOTES:


1. THIS MAP WAS PREPARED FROM FIELD MEASUREMENTS, NAIP 2026 AERIAL PHOTOGRAPHY, KLAMATH COUNTY TAX MAPS, AND OREGON GLO MAPS.

2. THE PURPOSE OF THIS MAP IS TO IDENTIFY THE LOCATION OF THE WATER RIGHT ONLY, AND IS NOT INTENDED TO PROVIDE DIMENSIONS OR LOCATION OF PROPERTY LINES.


3. DATE OF PRIORITY FOR THIS WATER RIGHT IS MARCH 9, 1990.

WELL LOCATION:

WELL #1 (L-137717): 2807' SOUTH & 1528' EAST FROM THE EAST CORNER NORTHWEST CORNER OF SECTION 8
(WGS 84 DATUM - LATITUDE: 42.72609°; LONGITUDE: -122.02984°).

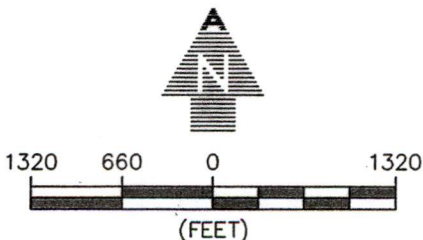

Received
SEP 17 2026
OWRD

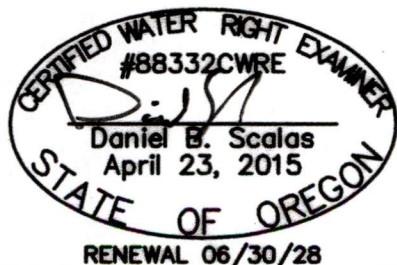

AL ADKINS
ENGINEERING & SURVEYING

o / 541.884.4666
w / AdkinsEngineering.com

1435 ESPLANADE AVENUE, KLAMATH FALLS, OR 97601

SERVING S. OREGON & N. CALIFORNIA

ENGINEERING • SURVEYING • PLANNING • TESTING

4206-01

CLAIM OF BENEFICIAL USE AND FINAL PROOF MAP

FOR
ROBINSON BEST LLC
T33S, R7.5E, SEC. 8, WM
KLAMATH COUNTY, OREGON
TRANSFER T-13351

8/31/2026