



Oregon Water Resources Department
725 Summer Street NE, Suite A
Salem, Oregon 97301
(503) 986-0900
www.oregon.gov/OWRD

E-RECEIVED
9/21/2026
OWRD

Ownership Update for Certificated Rights Only

NO FEES ARE REQUIRED TO SUBMIT THIS FORM

NOTICE: A certificate of water right typically stays with the land. To track water right ownership, the Department requests that this form be submitted to the Department. **To update multiple rights, a separate form is required for each right.** If you have any questions about this form, please contact your local watermaster, or call the Water Resources Department at (503) 986-0900.

Note: Use the [assignment](#) form to change ownership on pending applications, permits, transfers, groundwater registrations, or limited licenses.

Current Landowner Information				
Name:	Albrecht Family Farms LLC			
Mailing Address:	P.O. Box 741 CRANE ORE 97721			
City:	CRANE	State:	OR	Zip: 97721
Phone:	541-990-5604	Email:	albrechtFarms@yahoo.com	

Property Information				
County:	HARNEY	Township:	27	Range: 33 Section: 3
Tax Lot #:	1400			
Street Address of Water Right:	41360 Saddlehouse LN. Princeton OR.			
Water Right Information				
Application:	G-11871			
Permit:	G-11059			
Certificate:	92312			
Are all the lands associated with this water right owned by the requestor? ☒ Yes ☐ No				
(If no, include a map showing the portion of the water right involved)				


Signature and Date	
Name of individual completing form:	Curt Blackburn
Phone or email:	541-573-7206 Date: 9/15/26
Signature of requestor:	

The Department does not change names on water right certificates. This form will be placed in the file for future reference only. If mailed, the Department will not provide acknowledgment of receipt.

This form can be mailed to the address above or sent by email to wrd_dl_customerservice@water.oregon.gov

E-RECEIVED
9/21/2026
OWRD

T. 27 S., R. 33 E., W.M.
HARNEY CO., ORE.

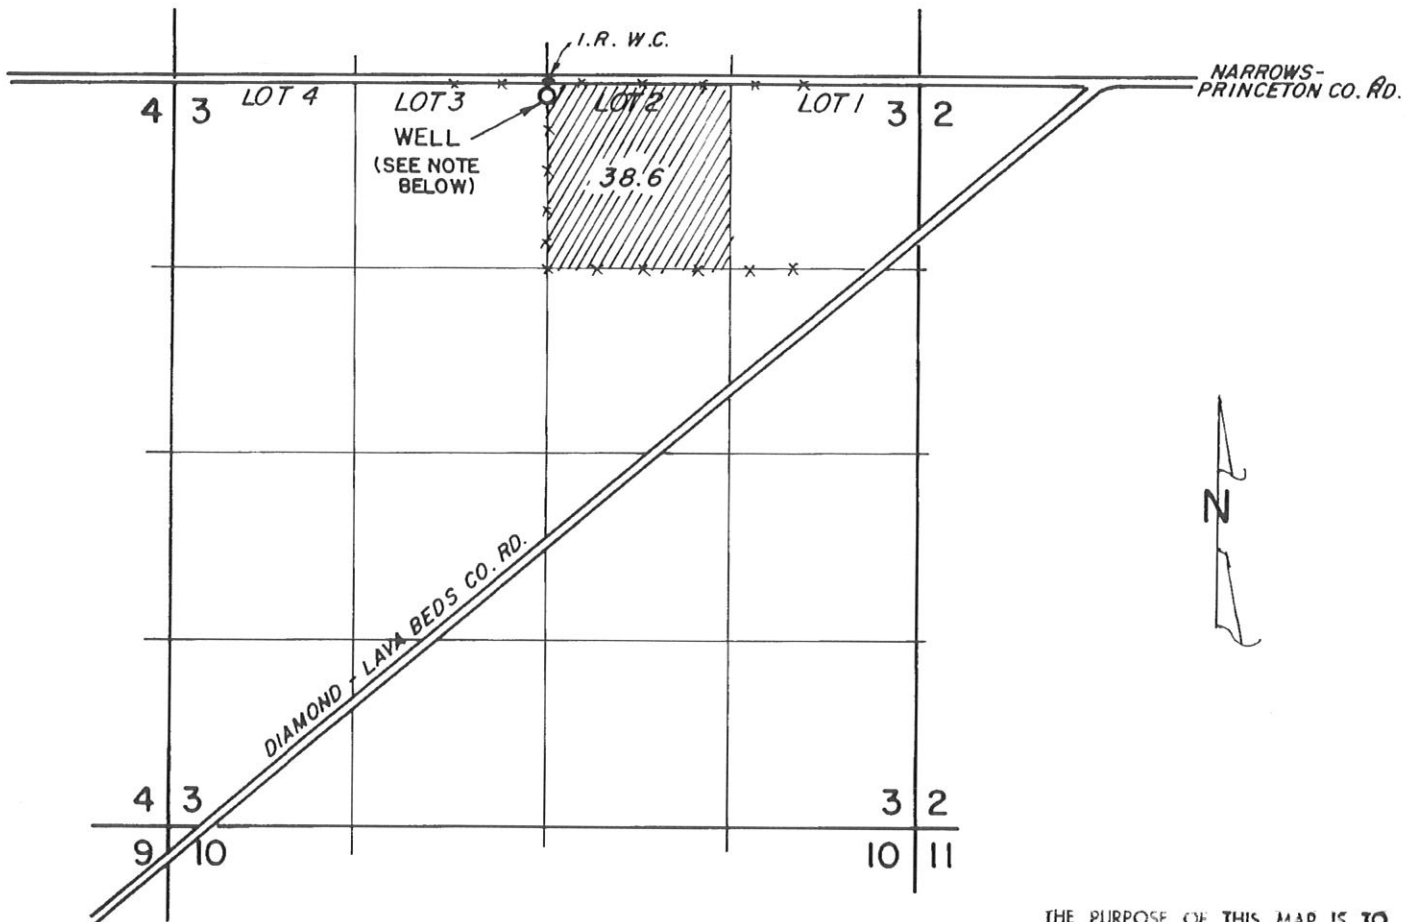

NOTE: WELL IS 94' S. & 19' ^E W. OF N1/4 COR. OF SEC. 3

THE PURPOSE OF THIS MAP IS TO IDENTIFY THE LOCATION OF THE WATER RIGHT. IT IS NOT INTENDED TO PROVIDE INFORMATION RELATIVE TO THE LOCATION OF PROPERTY OWNERSHIP.

	GORDON & JEAN ALDERTON		PRINCETON, OREGON	
	<u>FINAL PROOF SURVEY MAP</u>			
	UNDER APPLICATION NO. G-11871 PERMIT NO. G-11059			
	Scale: 1" = 1320'	Date: MAY 6, 1991	Job: 1119	
	Dsn: -	 M. A. PALMER & SONS, INC. ENGINEERING & SURVEYING 254 N. Alder - Box 61 Burns, Oregon 97720	Sht. No.	
Drn: CORK	of 1			
Ckd: " "				

* Map revised by OWRD to correctly show measured distance MS/WPD 1-24-17

STATE OF OREGON

COUNTY OF HARNEY

CERTIFICATE OF WATER RIGHT

E-RECEIVED

9/21/2026

OWRD

THIS CERTIFICATE ISSUED TO

GORDON ALDERTON
JEAN PEAT ALDERTON
HC 72 BOX 140
PRINCETON OR 97721

confirms the right to the use of water perfected under the terms of Permit G-11059. The amount of water used to which this right is entitled is limited to the amount used beneficially, and shall not exceed the amount specified, or its equivalent in the case of rotation, measured at the point of diversion from the source. The specific limits and conditions of the use are listed below.

APPLICATION FILE NUMBER: G-11871

SOURCE OF WATER: ONE WELL IN THE MALHEUR LAKE BASIN

PURPOSE or USE: IRRIGATION OF 38.6 ACRES

MAXIMUM RATE: 0.48 CUBIC FOOT PER SECOND

DATE OF PRIORITY: NOVEMBER 17, 1988

The well is located as follows:

Twp	Rng	Mer	Sec	Q-Q	GLot	Measured Distances
27 S	33 E	WM	3	NW NE	2	94 FEET SOUTH AND 19 FEET EAST FROM N1/4 CORNER, SECTION 3

The amount of water used for irrigation, together with the amount secured under any other right existing for the same lands, shall be limited to ONE-EIGHTIETH of one cubic foot per second per acre, or its equivalent for each acre irrigated and shall be further limited to a diversion of not to exceed 3.0 acre-feet per acre for each acre irrigated during the irrigation season of each year.

A description of the place of use is as follows:

Twp	Rng	Mer	Sec	Q-Q	GLot	Acres
27 S	33 E	WM	3	NW NE	2	38.6

NOTICE OF RIGHT TO PETITION FOR RECONSIDERATION OR JUDICIAL REVIEW

This is an order in other than a contested case. This order is subject to judicial review under ORS 183.484 and ORS 536.075. Any petition for judicial review must be filed within the 60-day time period specified by ORS 183.484(2). Pursuant to ORS 183.484, ORS 536.075 and OAR 137-004-0080, you may petition for judicial review and petition the Director for reconsideration of this order. A petition for reconsideration may be granted or denied by the Director, and if no action is taken within 60 days following the date the petition was filed, the petition shall be deemed denied. In addition, under ORS 537.260 any person with an application, permit or water right certificate subsequent in priority may jointly or severally contest the issuance of the certificate within three months after issuance of the certificate.

The well shall be maintained in accordance with the General Standards for the Construction and Maintenance of Water Wells in Oregon. The works shall be equipped with a usable access port, and may also include an air line and pressure gauge adequate to determine the water level elevation in the well at all times.

When required by the Department, the water user shall install and maintain a weir, meter, or other suitable measuring device, and shall keep a complete record of the amount of ground water withdrawn.

The Director may require water level or pump test results every ten years.

Failure to comply with any of the provisions of this right may result in action including, but not limited to, restrictions on the use, civil penalties, or cancellation of the right.

This right is for the beneficial use of water without waste. The water user is advised that new regulations may require the use of best practical technologies or conservation practices to achieve this end.

By law, the land use associated with this water use must be in compliance with statewide land-use goals and any local acknowledged land-use plan.

The use granted herein may be made only at times when sufficient water is available to satisfy all prior water rights.

The right to the use of the water for the above purpose is restricted to beneficial use on the place of use described.

Issued MAR 10 2017



Dwight French
Water Right Services Division Administrator, for
Thomas M. Byler, Director
Oregon Water Resources Department