


Received
SEP 18 2026

Claim of Beneficial Use Transfer T-14478

A Water Right held by Princess Properties LLC,
Polk County

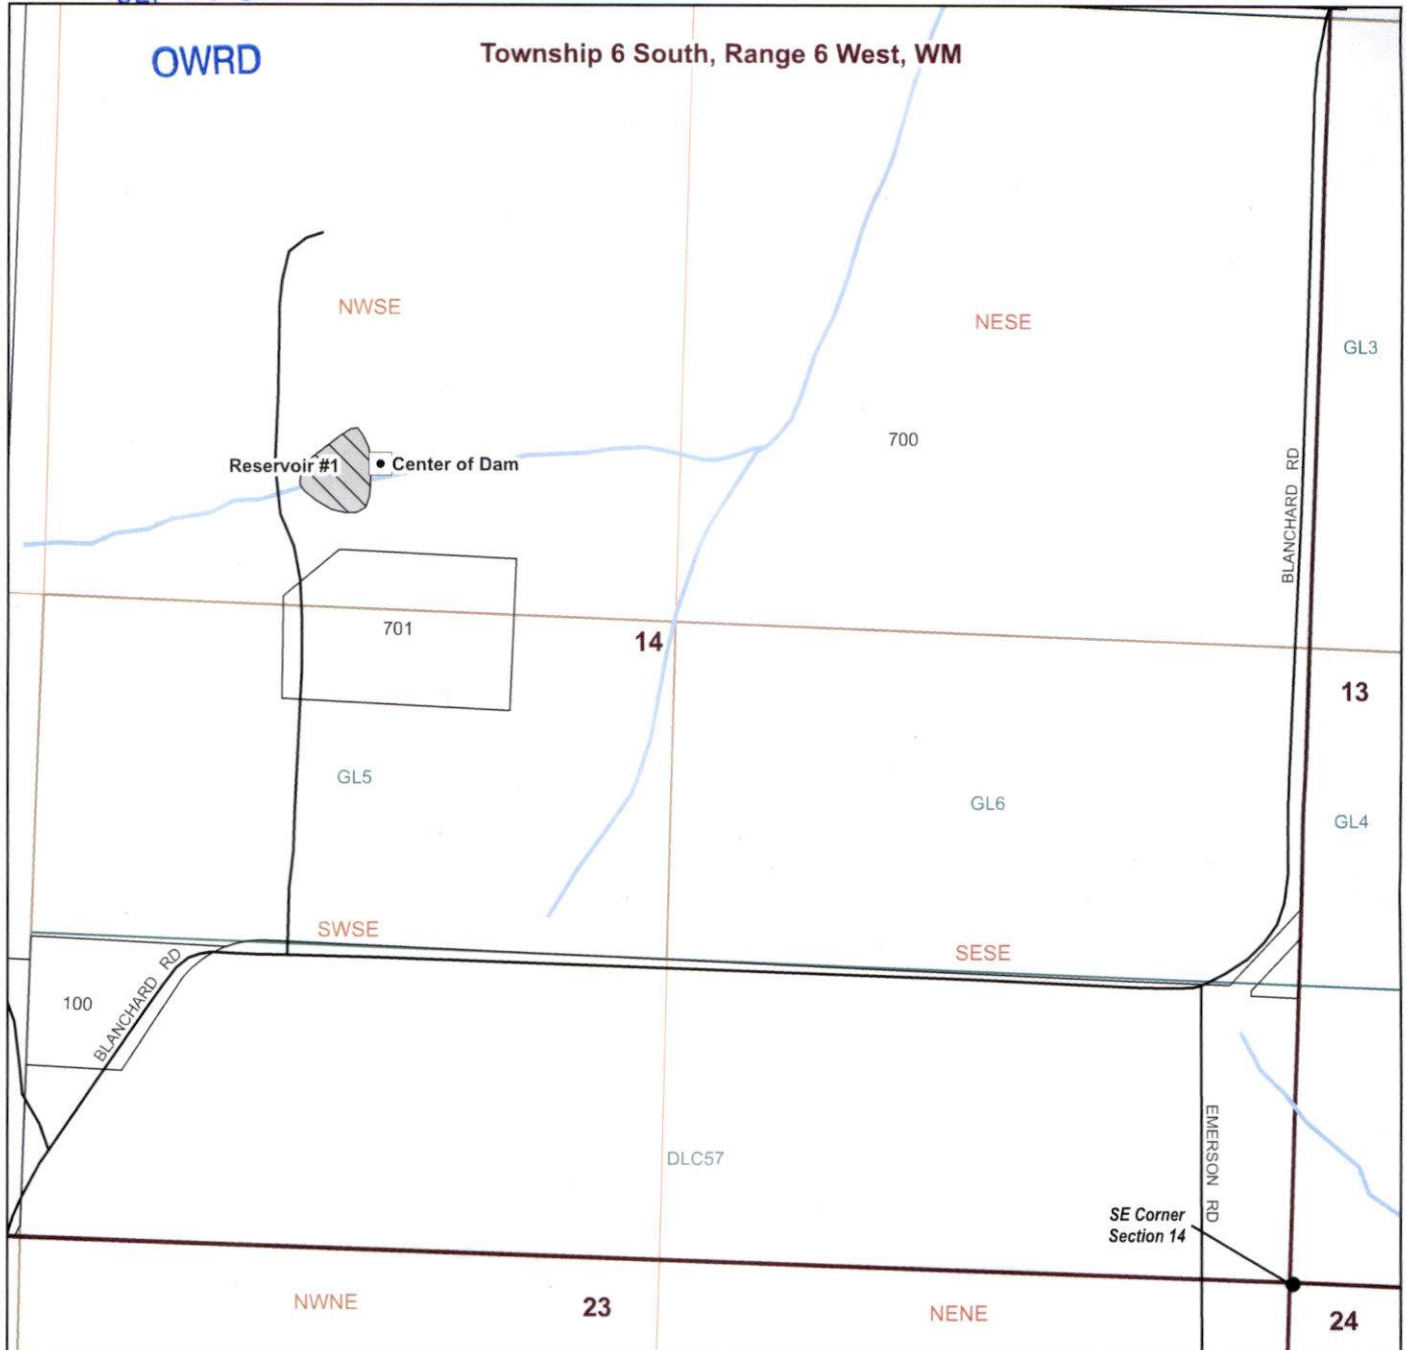


LEGEND

- Place of Use (POU)
- Point of Diversion (POD)
- Taxlots
- Section
- QQ
- DLC/Glots
- Watercourse

POD Location Description

Center of Dam

Located 1667 feet North and 1945 feet West from the
SE corner of Section 14 (NWSE), Township 6 South,
Range 6 West, W.M. (WGS84: 45.04754512,
-123.38489668)

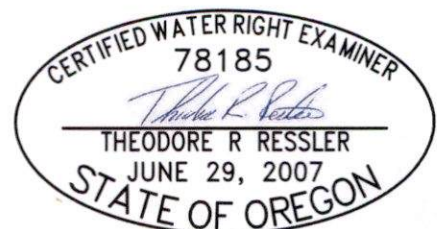

RENEWES: 12-31-2026



Scale
0 200 400 ft
1-inch = 400 feet

Date: 7/9/2026
Data Sources: OWRD, USGS, ODOT, Polk County
Project CRS: EPSG:2269 - NAD83 / Oregon North (ft)
Disclaimer: This map is not intended to provide legal dimensions or
property ownership lines.

