
Claim of Beneficial Use Map

Transfer T-14089

A Water Right held by Hubbard Family LLC
Township 15 South, Range 4 West, Section 8 (W.M.)
Benton and Lane County

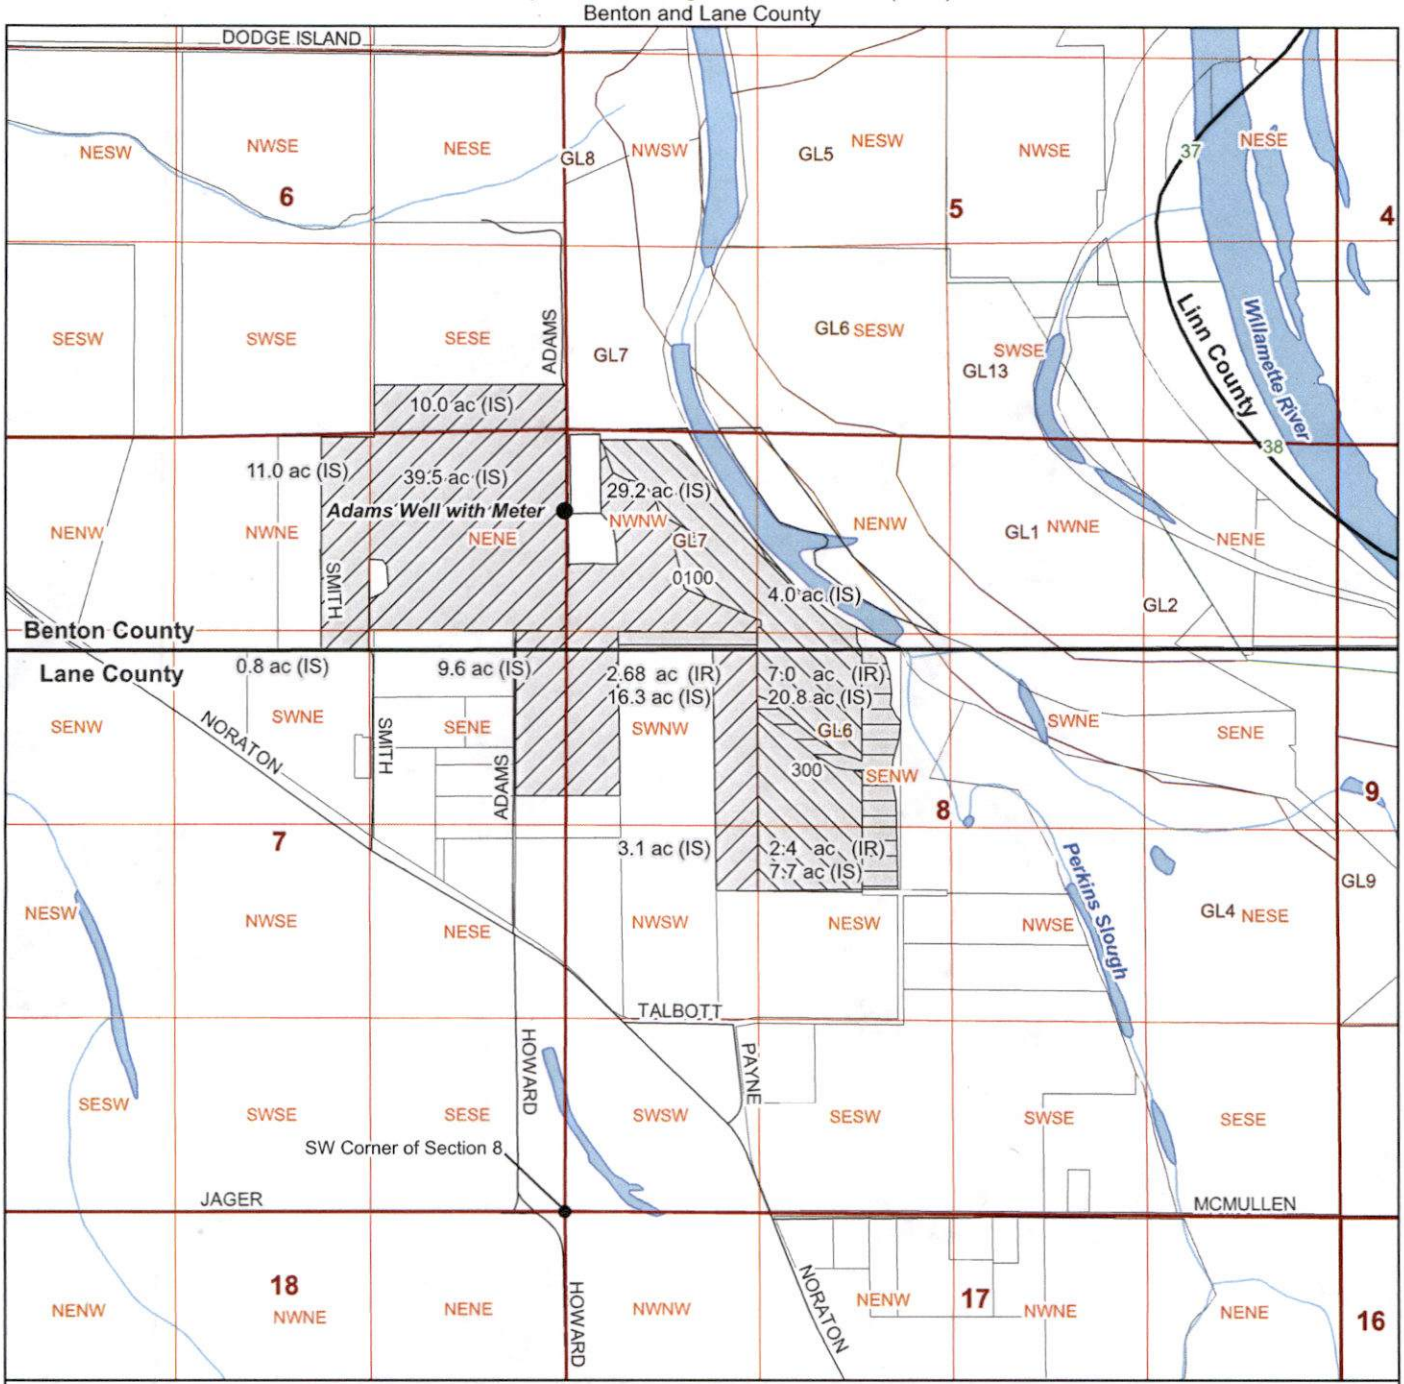

LEGEND

- Point of Appropriation (POA)
- Place of Use (POU) IR
- POU IS (IR under 17111)
- POU IS (IR under 14153)
- Tax Lots
- Roads
- Streams

N

Scale
0 660 1,320 ft
1-inch = 1320 feet

POA Location Description

Adams Well (BENT 7623): 4,785 feet north and 10 feet west from SW corner of Section 8 (NWNW), Township 15 South, Range 4 West (WM) (WGS84; 44.286387, -123.209352)

Received
SEP 18 2026
OWRD

CERTIFIED WATER RIGHT EXAMINER
78185
THEODORE R RESSLER
JUNE 29, 2007
STATE OF OREGON
RENEWS: 12-31-2026

Date: 8/11/2026
Data Sources: Benton County, Lane County, OWRD, USGS, BLM
Project CRS: EPSG: 2992 - NAD 83 / Oregon GIC Lambic (ft)
Disclaimer: This map is not intended to provide legal dimensions or property ownership lines.

summit WATER RESOURCES

\1_SWR_Maps\Hubbard.qgz