


CLAIM OF BENEFICIAL USE MAP

TO CHANGE PLACE OF USE AND ADD A POINT OF APPROPRIATION PER T-13517 FOR TODD TITUS

SECTION 35, TOWNSHIP 25 SOUTH, RANGE 34 EAST, W.M.
TAX LOTS: 2800

SECTION 5, TOWNSHIP 26 SOUTH, RANGE 34 EAST, W.M.
TAX LOTS: 200 & 402

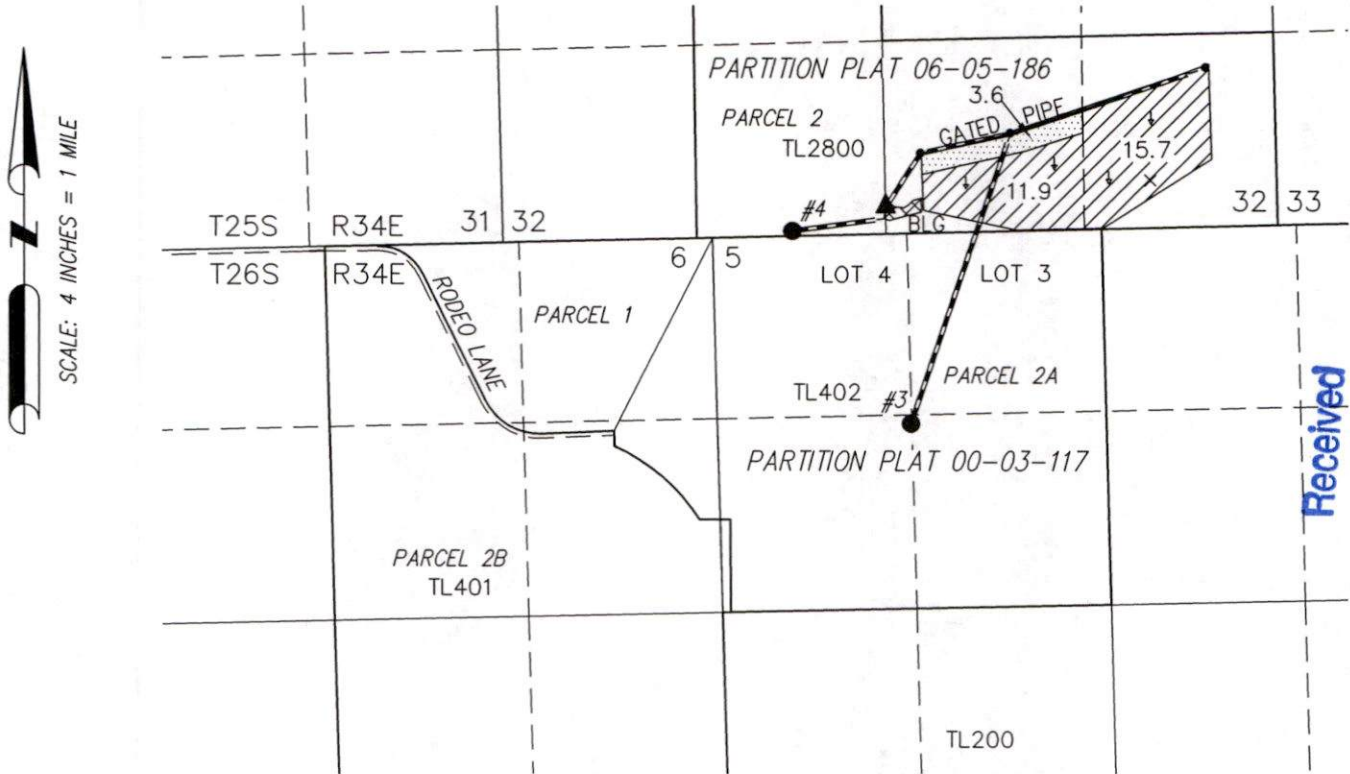

PIPED CONVEYANCE




3.6 ACRES IR FROM WELLS 3 & 4 (G-29), AS SHOWN.



27.6 ACRES IR FROM WELLS 3 & 4 (G-7543), AS SHOWN.



BLG
SYSTEM BULGE ± 1.0 ACRE-FT

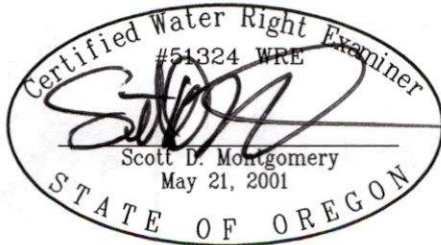

RENEWAL DATE: 12/31/2026

- POA 3 (HARN 1411) 43.34509° -118.55893°
LOCATED 1260 FEET NORTH AND 1320 FEET EAST FROM
THE W 1/4 CORNER OF SECTION 5.
FLOW METER IS LOCATED 6' WEST FROM WELL.
- POA 4 (HARN 53212) 43.34865° -118.56211°
LOCATED 30 FEET NORTH AND 550 FEET EAST FROM
THE NW CORNER OF SECTION 5.
FLOW METER IS LOCATED 6' EAST FROM WELL.

▲ SUMP - WET WELL

• PIPE TEE

THIS MAP IS FOR THE PURPOSE OF LOCATING A WATER
RIGHT ONLY AND HAS NO INTENT TO PROVIDE LEGAL
DIMENSIONS OR THE LOCATION OF PROPERTY LINES.

PREPARED FOR:

TODD TITUS
43431 RODEO LANE
BURNS, OR 97720

PREPARED BY:



ALL POINTS ENGINEERING AND SURVEYING, INC.
P.O. BOX 767 TERREBONNE, OR 97760
(541) 548-5833 www.APEandS.com