

LEGEND

LINE TYPES

- TAX LOT BOUNDARY: ————
- OLD PROPERTY LINE: - - - - -
- ROAD RIGHT-OF-WAY: ————
- VACATED RIGHT-OF-WAY: - - - - -
- RAILROAD: ————
- RAILROAD RIGHT-OF-WAY: ————
- STREAM, LAKE, ETC. TAX LOT BOUNDARY: ————
- STREAM, LAKE, ETC. NON-BOUNDARY: - - - - -
- SUBDIVISION BOUNDARY: \ / \ / \ / \ /
- PARTITION PLAT BDY.: \ / \ / \ / \ /
- TAX CODE BOUNDARY: ○ ○ ○ ○ ○
- EASEMENT: - - - - -

SYMBOL TYPES


- D.L.C. (Dotted Line Corner): ⊙
- CONTROL POINTS: ▲
- SURVEY MONUMENTS: •
- G.L.O. CORNERS: ⊕
- SECTION: 3x3 grid
- 1/4 SEC: 1x1 grid
- 1/16 SEC: 4x4 grid

NUMBERS

TAX CODE NO. 000 00 00 0

ACREAGE - ALL ACREAGES EXCLUDE ANY PORTION THAT MAY LIE WITHIN THE INDICATED PUBLIC RIGHT OF WAYS.

TICK MARKS - WHEN A TICK MARK IS INDICATED ON THE EXTENSION OF A LINE, THEN THE DIMENSION GOES TO THE TICK MARK. GENERALLY THIS IS USED WHEN DIMENSIONS GO INTO PUBLIC RIGHT OF WAYS.

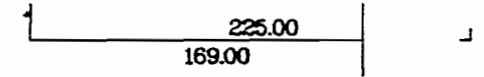

ARROWS ARE USED WITH DIMENSIONS IN AREAS OF GREATER COMPLEXITY.


NOTICE: This map was created for Assessor's Office use ONLY.



JUL 23 2007

SCALE 1" = 200' or 1:2400

ot file created: March 05, 1998

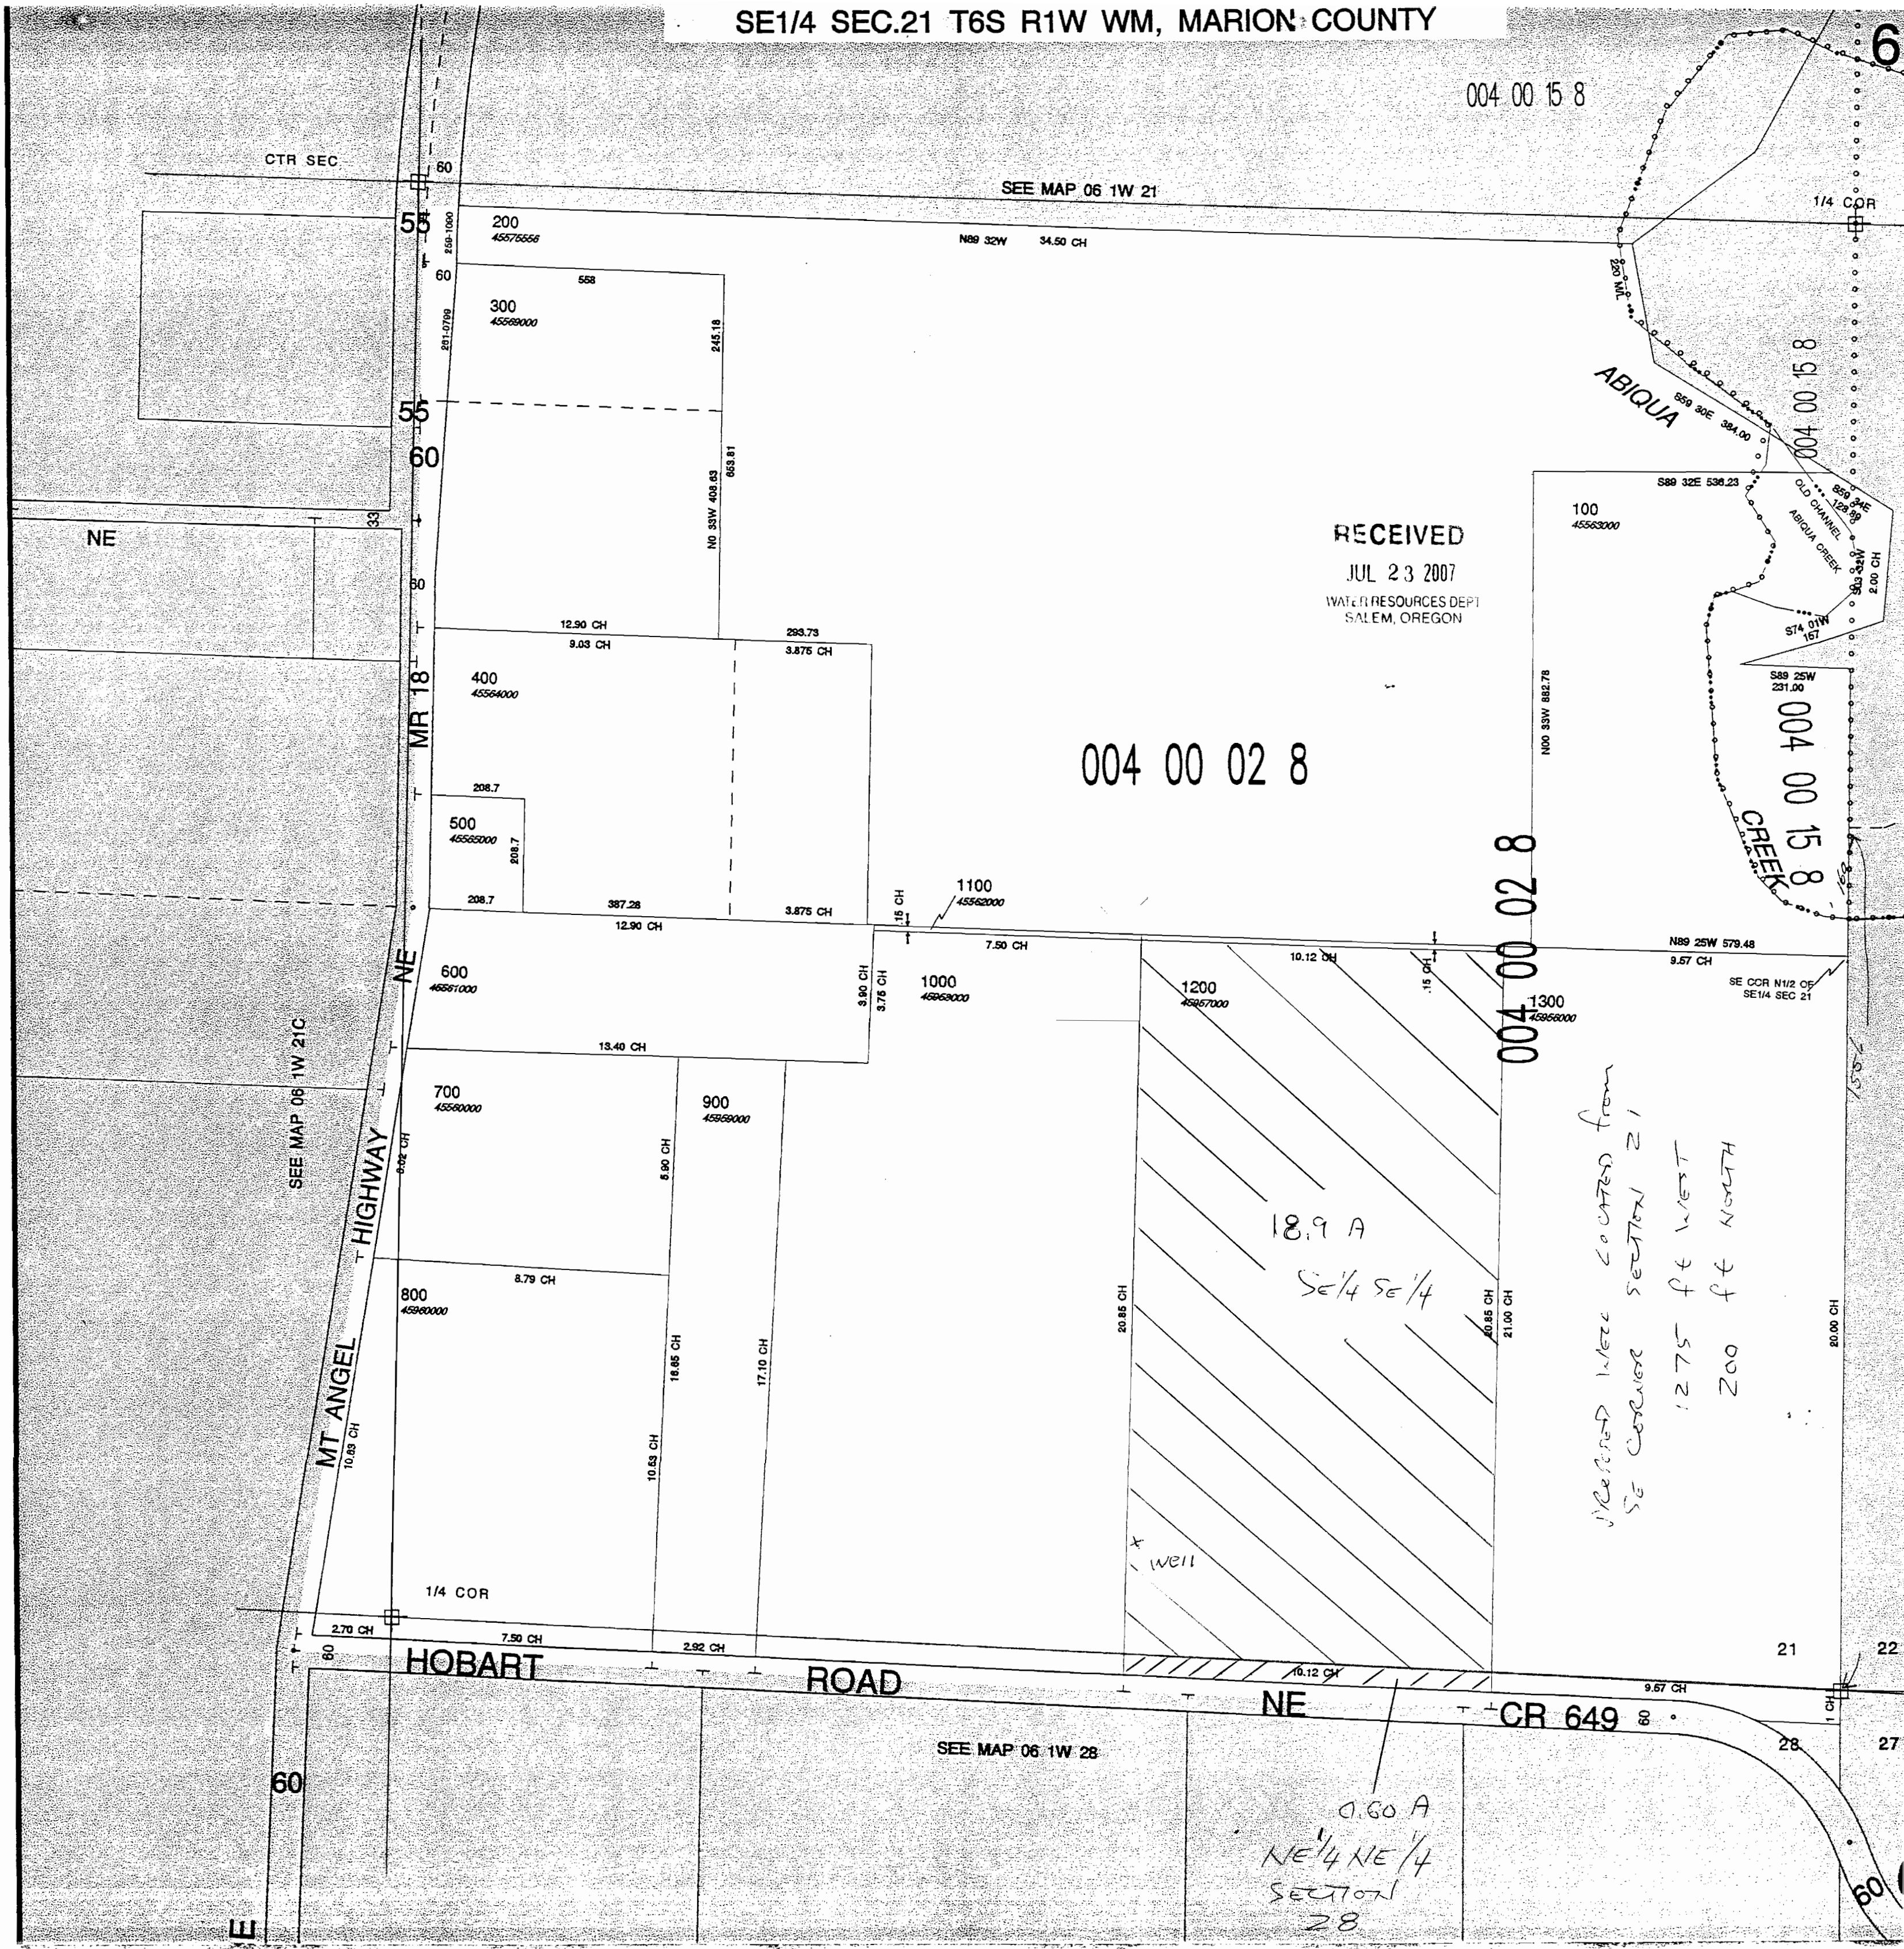

RECEIVED JUL 23 2007 WATER RESOURCES DEPT SALEM, OREGON

004 00 02 8

004 00 02 8

18.9 A SE 1/4 SE 1/4
Noted well located from SE corner SECTION 21
1275 ft WEST
200 ft NORTH

0.60 A NE 1/4 NE 1/4 SECTION 28