


Claim of Beneficial Use Map

Sections 7 & 18, T4S, R3W, & Section 12, T4S, R4W,
Yamhill County
Transfer T-13275 (Cert. 15091)



1 IN = 1320 FT
0 660 1320

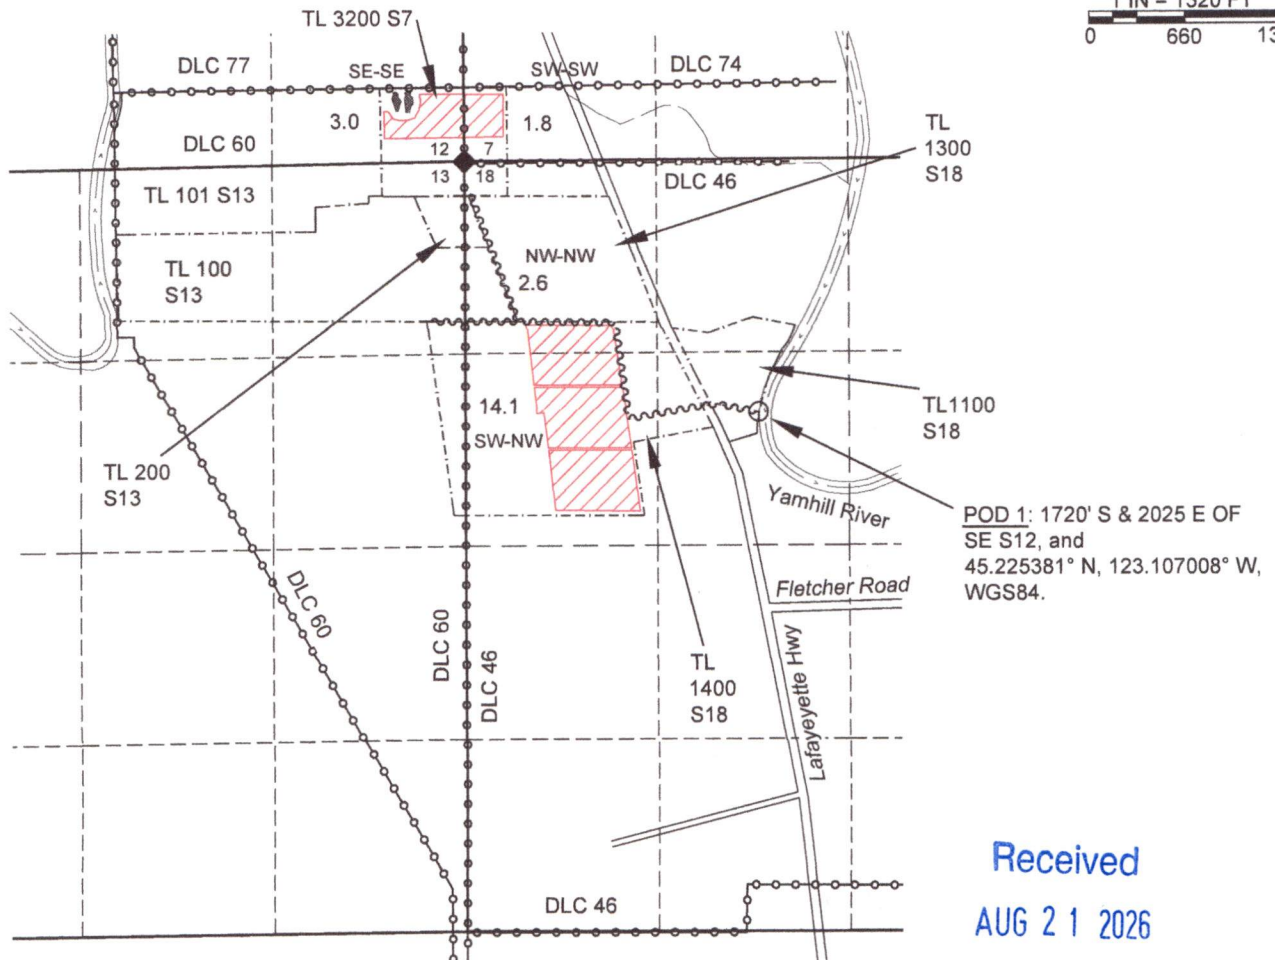

Received
AUG 21 2026
OWRD

NOTES:

- THIS MAP IS NOT INTENDED TO PROVIDE LEGAL DIMENSIONS OR LOCATIONS OF PROPERTY OWNERSHIP LINES.
- THIS MAP IS BASED ON A SCALED TAX ASSESSOR MAP. PROPERTY BOUNDARIES, DONATION LAND CLAIM (DLC) LINES ARE BASED ON THE ASSESSOR MAP.
- STREAM BOUNDARIES, AND IRRIGATION AREAS ARE BASED ON AERIAL PHOTO INTERPRETATION AND LANDOWNER INPUT FOR TO LANDS.



Exp. 30 JUN 2028

LEGEND



SECTION CORNER



IRRIGATION



STREAM OR SURFACE DRAINAGE




TAX LOT LINE




SECTION LINE



QUARTER-QUARTER LINE

 

DLC LINES

 

CONVEYANCE PIPELINES

MAP BY:
ASPEN RURAL LAND CONSULTING
ERIC URSTADT, PE, PLS
971-250-1520
Jun 2026
WVL-Hoff3F

A-2/4


Claim of Beneficial Use Map

Sections 7 & 18, T4S, R3W, & Section 12, T4S, R4W,
Yamhill County

Transfer T-13275 (Cert. 35059)



1 IN = 1320 FT
0 660 1320

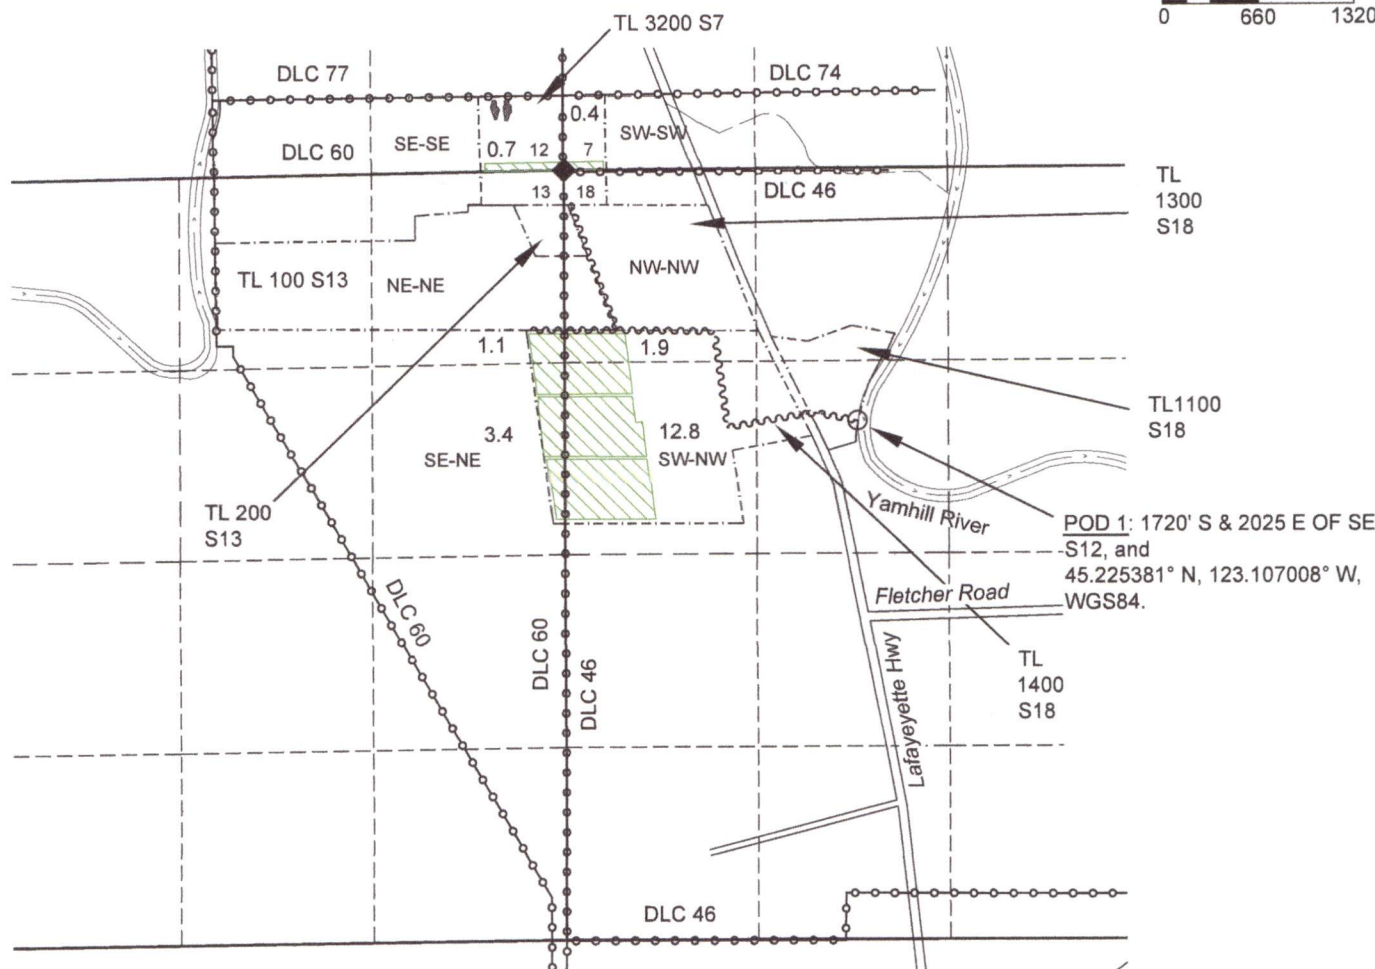

NOTES:

- THIS MAP IS NOT INTENDED TO PROVIDE LEGAL DIMENSIONS OR LOCATIONS OF PROPERTY OWNERSHIP LINES.
- THIS MAP IS BASED ON A SCALED TAX ASSESSOR MAP. PROPERTY BOUNDARIES, DONATION LAND CLAIM (DLC) LINES ARE BASED ON THE ASSESSOR MAP.
- STREAM BOUNDARIES, AND IRRIGATION AREAS ARE BASED ON AERIAL PHOTO INTERPRETATION AND LANDOWNER INPUT FOR TO LANDS.


LEGEND

- ◆ SECTION CORNER
- ▨ IRRIGATION
- STREAM OR SURFACE DRAINAGE
- TAX LOT LINE
- SECTION LINE
- QUARTER-QUARTER LINE
- DLC LINES
- CONVEYANCE PIPELINES

Received

AUG 21 2026

OWRD

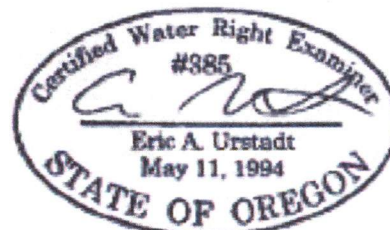

Exp. 30 JUN 2028

MAP BY:
**ASPEN RURAL LAND
CONSULTING**


ERIC URSTADT, PE, PLS
971-250-1520
Jun 2026
WVL-Hoff3F

Claim of Beneficial Use Map

Sections 7 & 18, T4S, R3W, & Section 12, T4S, R4W,
Yamhill County
Transfer T-13275 (Cert. 47564)



1 IN = 1320 FT
0 660 1320

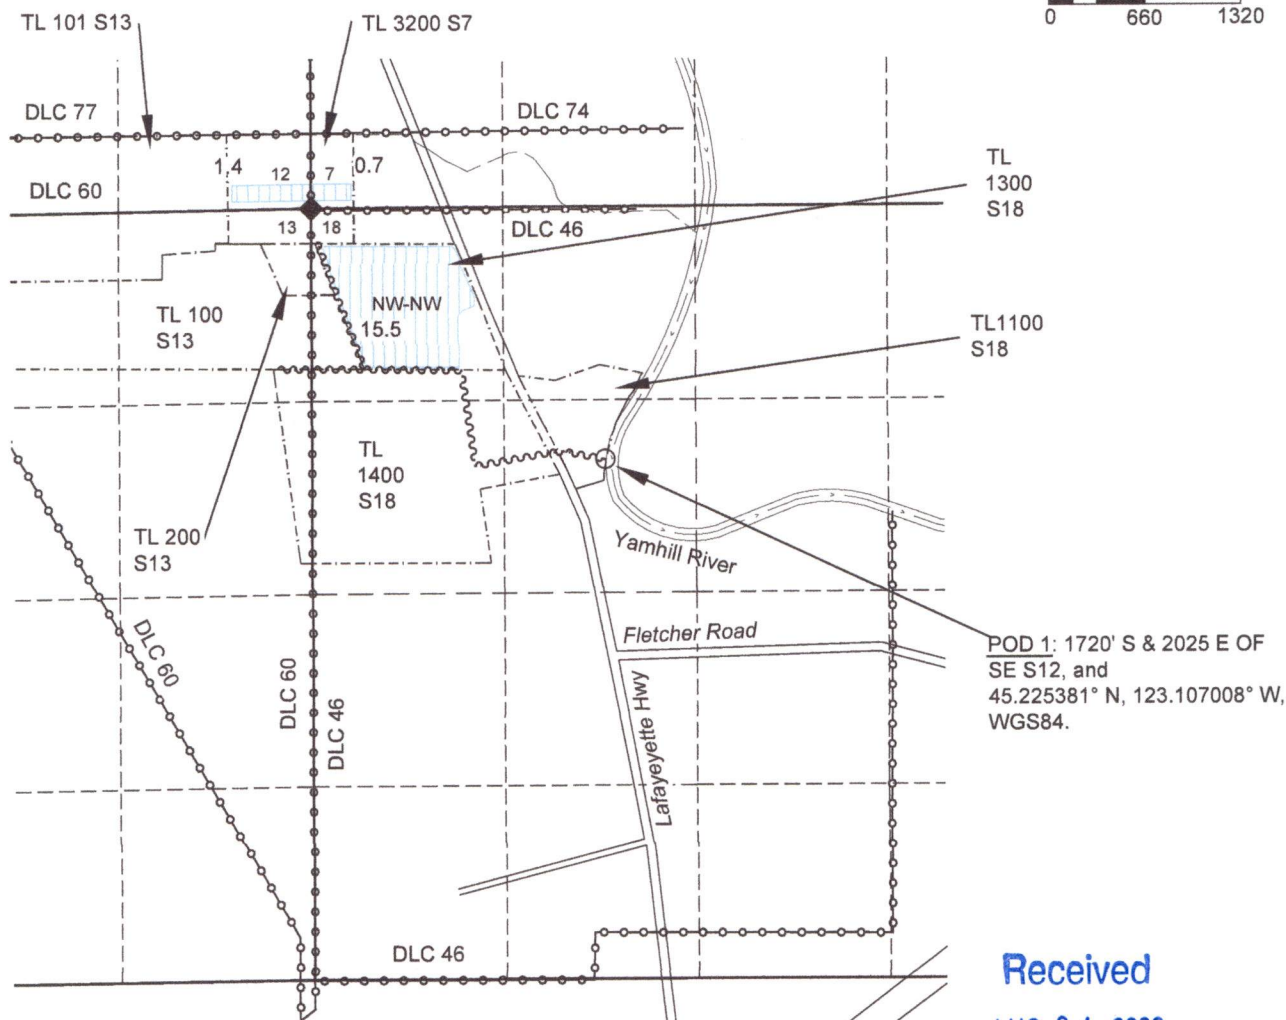

NOTES:


- THIS MAP IS NOT INTENDED TO PROVIDE LEGAL DIMENSIONS OR LOCATIONS OF PROPERTY OWNERSHIP LINES.
- THIS MAP IS BASED ON A SCALED TAX ASSESSOR MAP. PROPERTY BOUNDARIES, DONATION LAND CLAIM (DLC) LINES ARE BASED ON THE ASSESSOR MAP.
- STREAM BOUNDARIES, AND IRRIGATION AREAS ARE BASED ON AERIAL PHOTO INTERPRETATION AND LANDOWNER INPUT FOR TO LANDS.

LEGEND

- ◆ SECTION CORNER
- ▨ IRRIGATION
- > — > — > — STREAM OR SURFACE DRAINAGE
- TAX LOT LINE
- SECTION LINE
- QUARTER-QUARTER LINE
- ○ ○ ○ ○ DLC LINES
- ~~~~~ CONVEYANCE PIPELINES.

Received
AUG 21 2026

OWRD

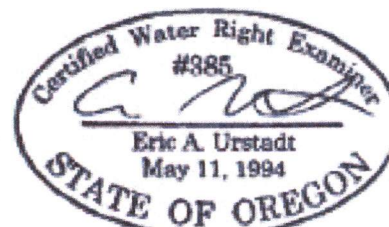

Exp. 30 JUN 2028

MAP BY:
ASPEN RURAL LAND CONSULTING
ERIC URSTADT, PE, PLS
971-250-1520
Jun 2026
WVL-Hoff3F