

CLAIM OF BENEFICIAL USE MAP

T-14149

SECTION 26, 27, & 34, TOWNSHIP 36 SOUTH, RANGE 4 WEST, W.M.
JACKSON COUNTY, OREGON

LEGEND




REFERENCE CORNER (RC), SE. COR. SEC. 27,
T.36S., R.4W., W.M.




POINT OF DIVERSION (POV)

POD#1: 1210 FT. N. & 130 FT. W.
FROM RC. ODFW APPROVED FISH SCREEN AT
SAME LOCATION (42.40765, -123.15119
WGS84)

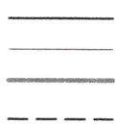

IRRIGATION MAINLINE
TAXLOT BOUNDARIES
DONATION LAND CLAIM
1/16 SECTION LINES (AS PROJECTED)

PLACE OF USE (POU) IRRIGATION:

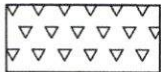

PRIORITY DATE: 1855


PRIORITY DATE: 12/31/1969



UNTIL JULY 1 FROM JULY 1

POU PER QUARTER-QUARTER

PRIORITY DATE: 1855				PRIORITY DATE: 12/31/1969			
T. 36 S., R. 4 W.				T. 36 S., R. 4 W.			
Sec.	Q-Q	GL / DLC	Acres	Until July 1			
26	(SW-SW)	DLC 37	0.2	34	(NE-NE)	DLC 41	12.5
	(SW-NE)	DLC 41	1.1		(NW-NE)	DLC 41	13.1
	(NE-SW)	DLC 41	1.5		(SW-NE)	DLC 41	15.0
	(NW-SE)	DLC 41	20.8		(SE-NE)	DLC 41	12.0
	(NW-SE)	GL 13	0.3	From July 1			
27	(SW-SE)	DLC 41	16.7	34	(NE-NE)	DLC 41	10.0
	(SE-SE)	DLC 41	10.3		(SE-NE)	DLC 41	12.0
	(SE-SE)	DLC 37	0.4				
34	(NE-NE)	DLC 41	7.7				

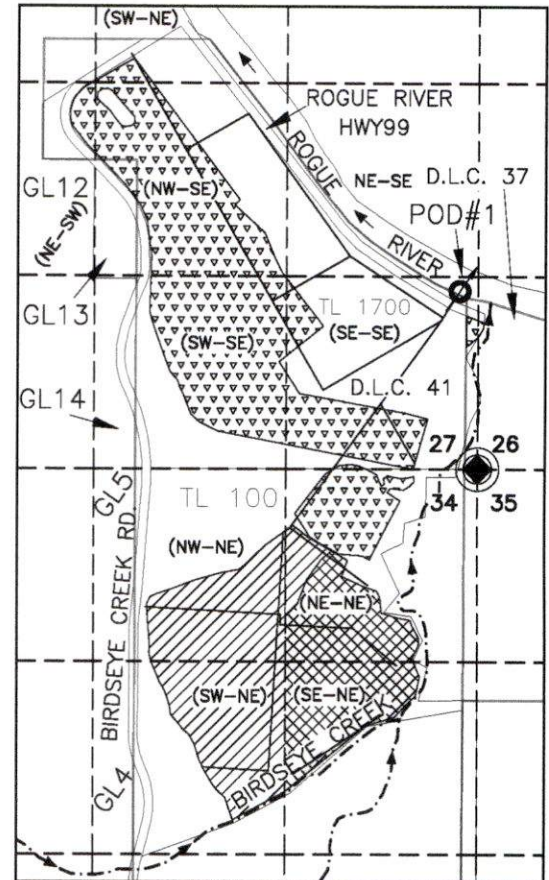

NORTH
1"=1320'

Received
SEP 14 2026
OWRD



EXPIRES 06/30/2028

DISCLAIMER: THIS MAP WAS PREPARED FOR THE
PURPOSE OF IDENTIFYING THE LOCATION OF
WATER RIGHT ONLY AND IS NOT INTENDED TO
PROVIDE LEGAL DESCRIPTIONS OR LOCATIONS OF
PROPERTY LINES.



P.O. Box 995
Coos Bay, OR 97420
(541) 297-1880
vancampconsulting@gmail.com

Prepared For:

Del Rio Vineyards
P.O. Box 906
Gold Hill, OR 97525

Project:

T-14149 Claim of
Beneficial Use

Date:

July 31, 2026