

CLAIM OF BENEFICIAL USE MAP

TO ADD TWO POINTS OF APPROPRIATION AND PLACE OF USE
FOR PERMIT APPLICATION G-12716

SECTION 31, TOWNSHIP 29 SOUTH, RANGE 18 EAST
TAX LOT 400

Received

SEP 03 2026


OWRD

Received

SEP 17 2026

OWRD

SCALE: 4 INCHES = 1 MILE

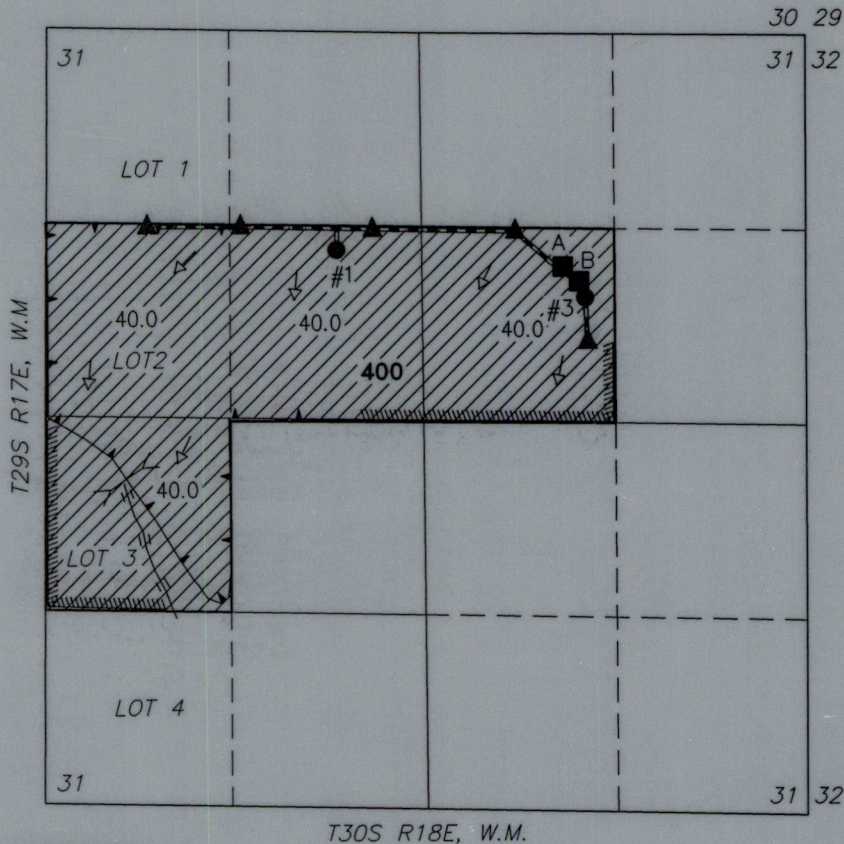

→ DIRECTED SHEET FLOW

--- 10" MAINLINE

▲ 10" ELBOW RISER SPILLOUT

● WELL #1 (LAKE 1464) 43.01583° -120.63510°
LOCATED 1546' SOUTH & 1514' EAST FROM THE NW CORNER
OF SECTION 31. FLOWMETER LOCATED 6' N FROM WELL.

● WELL #3 (LAKE 52820) 43.014925° -120.62873°
LOCATED 1755' SOUTH & 1700' WEST FROM THE NE CORNER
OF SECTION 31. FLOWMETER LOCATED 6' N FROM WELL.

■ SYSTEM BULGE A
0.25 ACRE-FT DUGOUT POND LOCATED 100 LF SW FROM WELL


■ SYSTEM BULGE B
0.25 ACRE-FT DUGOUT POND LOCATED 270 LF NW FROM WELL

>< 36" CULVERT
== DITCH

12' WIDE LEVEE
SMALL BERM



160.0 ACRES 'IR' FROM PERMIT
G-17254, AS SHOWN.

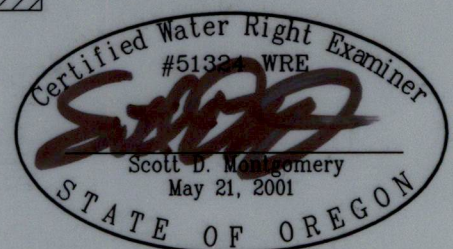

THIS MAP IS FOR THE PURPOSE OF LOCATING A WATER RIGHT ONLY AND HAS NO
INTENT TO PROVIDE LEGAL DIMENSIONS OR THE LOCATION OF PROPERTY LINES

RENEWAL DATE: 12/31/2026

PREPARED FOR:

CHAYLON SHUFFIELD
P.O. BOX 31
SUMMER LAKE, OR 97640

PREPARED BY:



ALL POINTS ENGINEERING AND SURVEYING, INC.
P.O. BOX 767
(541) 548-5833
TERREBONNE, OR 97760
www.APEandS.com