


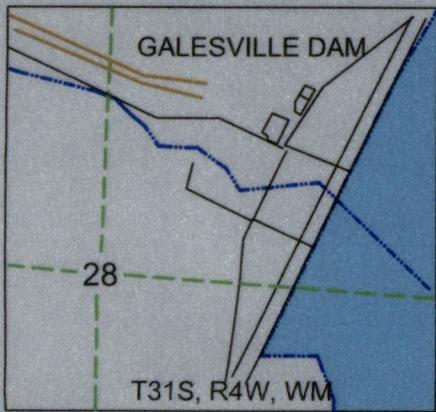

CLAIM of BENEFICIAL USE


FOR: DAVID & BLANCA HELBOCK
 BY: NATHAN REED, PE, CWRE
 T26S, R6W, W.M. SECTION 32
 TRANSFER #: T-13891

DATE OF SURVEY: SEPTEMBER 18, 2026



SCALE: 1" = 400'


Received
 SEP 24 2026

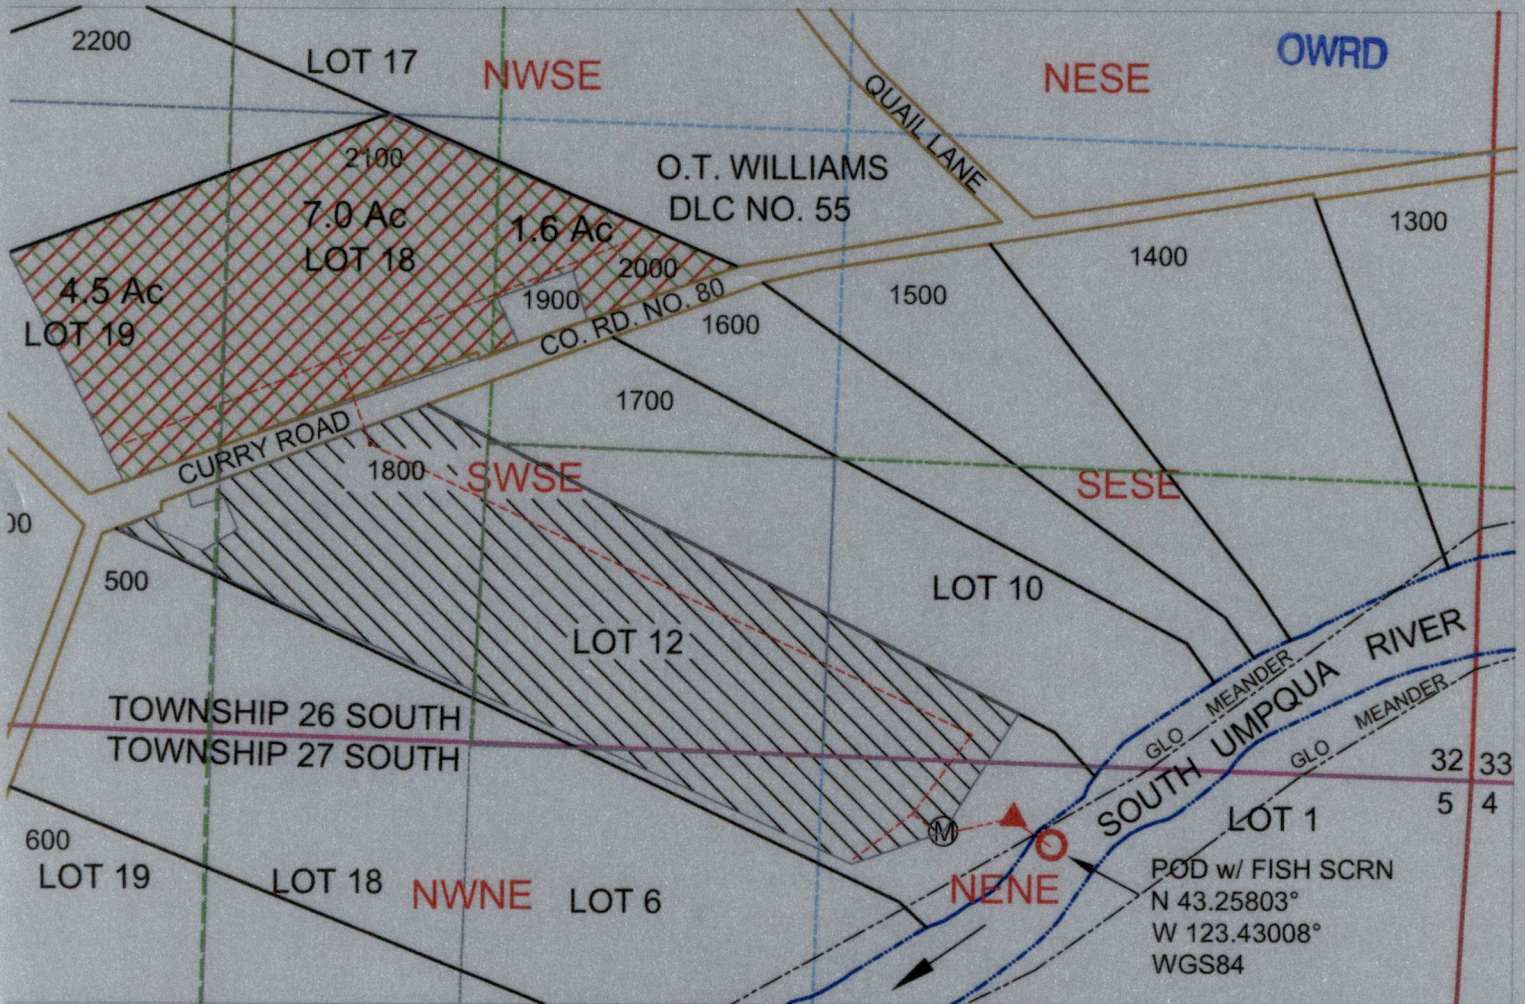

POD IS LOCATED 100 FEET SOUTH & 850 FEET WEST FROM THE NE1/4 CORNER, SECTION 5 AS PROJECTED IN LOT 6.

LEGEND

- | | | | |
|--|--------|--|---------------------|
| | WATER | | SECTION |
| | POD | | QUARTER |
| | PUMP | | SIXTEENTH |
| | METER | | DLC |
| | PIPE | | GLOT |
| | PARCEL | | PRIMARY |
| | | | Priority 4-26-1972 |
| | | | STORED SUPPLEMENTAL |
| | | | Priority 7-14-1993 |
| | | | CERT 98987 |
| | | | Priority 2-10-2016 |

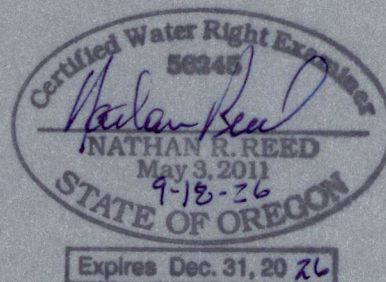

MAP PREPARED FOR:
 DAVID & BLANCA HELBOCK
 1806 CURRY ROAD
 ROSEBURG, OR 97471

MAP PREPARED BY:
 NATHAN REED PE, CWRE
 157 WEST BODIE STREET
 ROSEBURG, OR 97471

THE PURPOSE OF THIS MAP IS TO IDENTIFY THE LOCATION OF THE WATER RIGHT. IT IS NOT INTENDED TO PROVIDE INFORMATION RELATIVE TO THE LOCATION OF PROPERTY OWNERSHIP BOUNDARY LINES.