


Claim of Beneficial Use - Birky Transfer T-14211

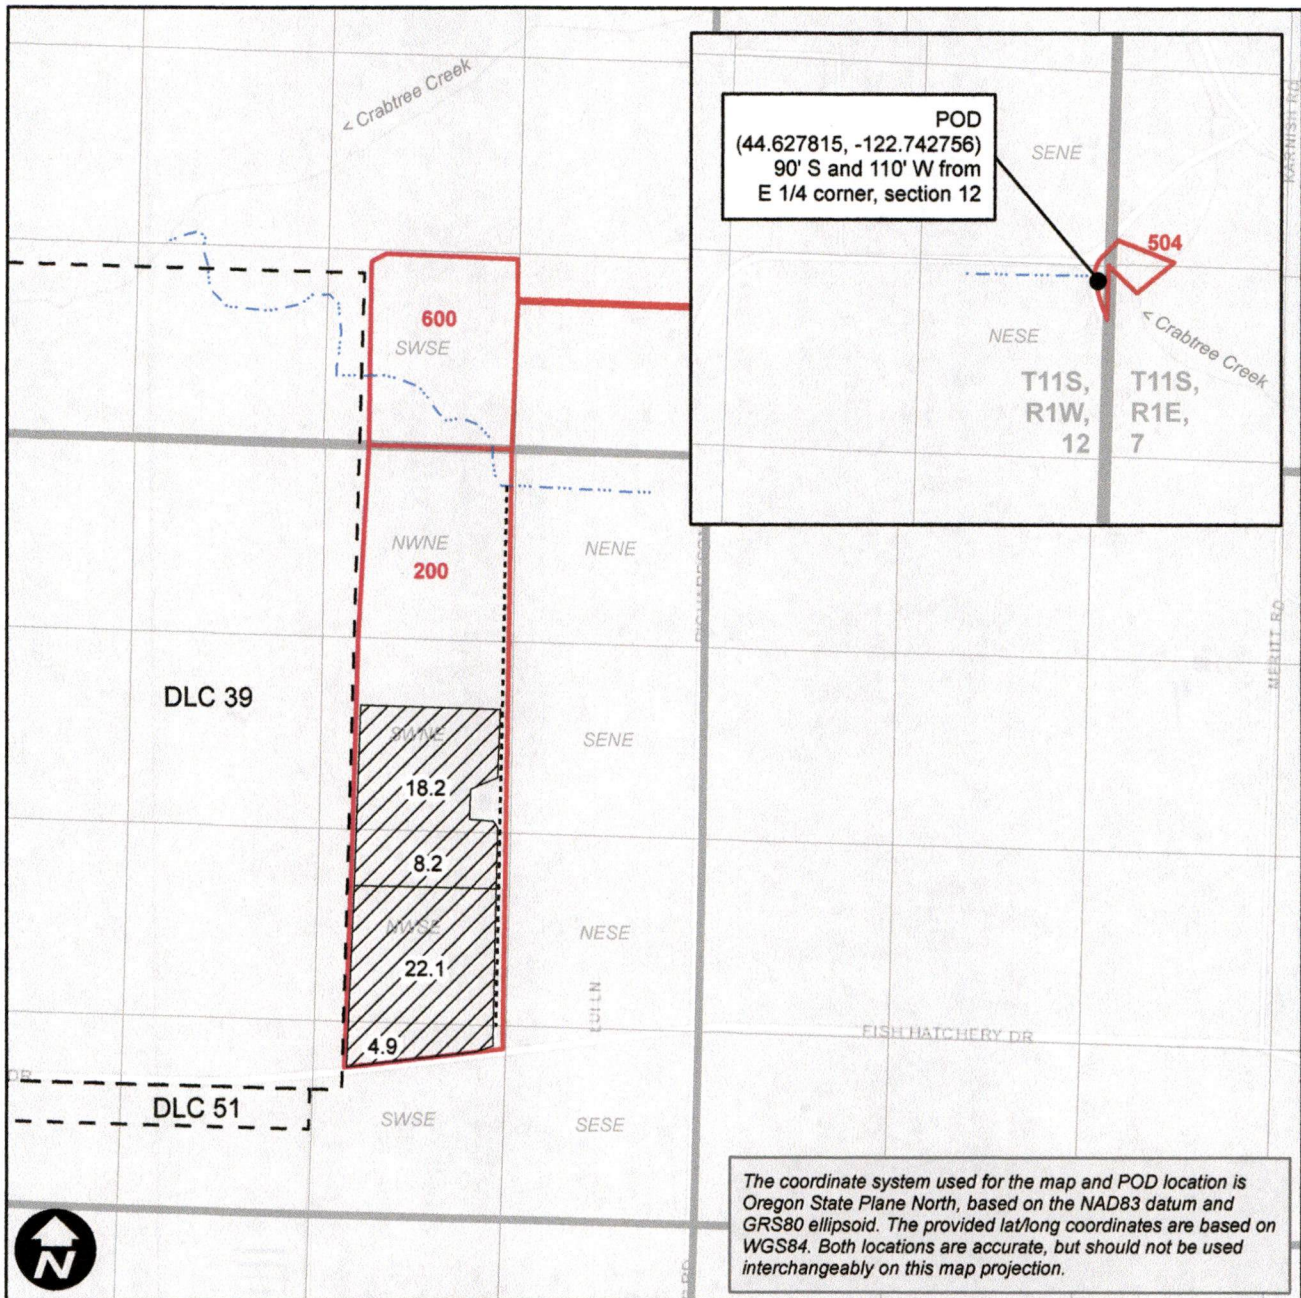

0 660 1,320 2,640 Feet

This map is not intended to provide legal dimensions or locations of property ownership lines.

Legend

- T-14211 IR POU
 Irrigation Ditch
 Taxlots
 Mainline
 DLC

Received by OWRD

SEP 25 2026

Salem, OR

