


Claim of Beneficial Use - Oak Park Farms, Inc./Coon Application S-88592, Permit S-55256

Township 12S, Range 4W, Section 32, W.M.

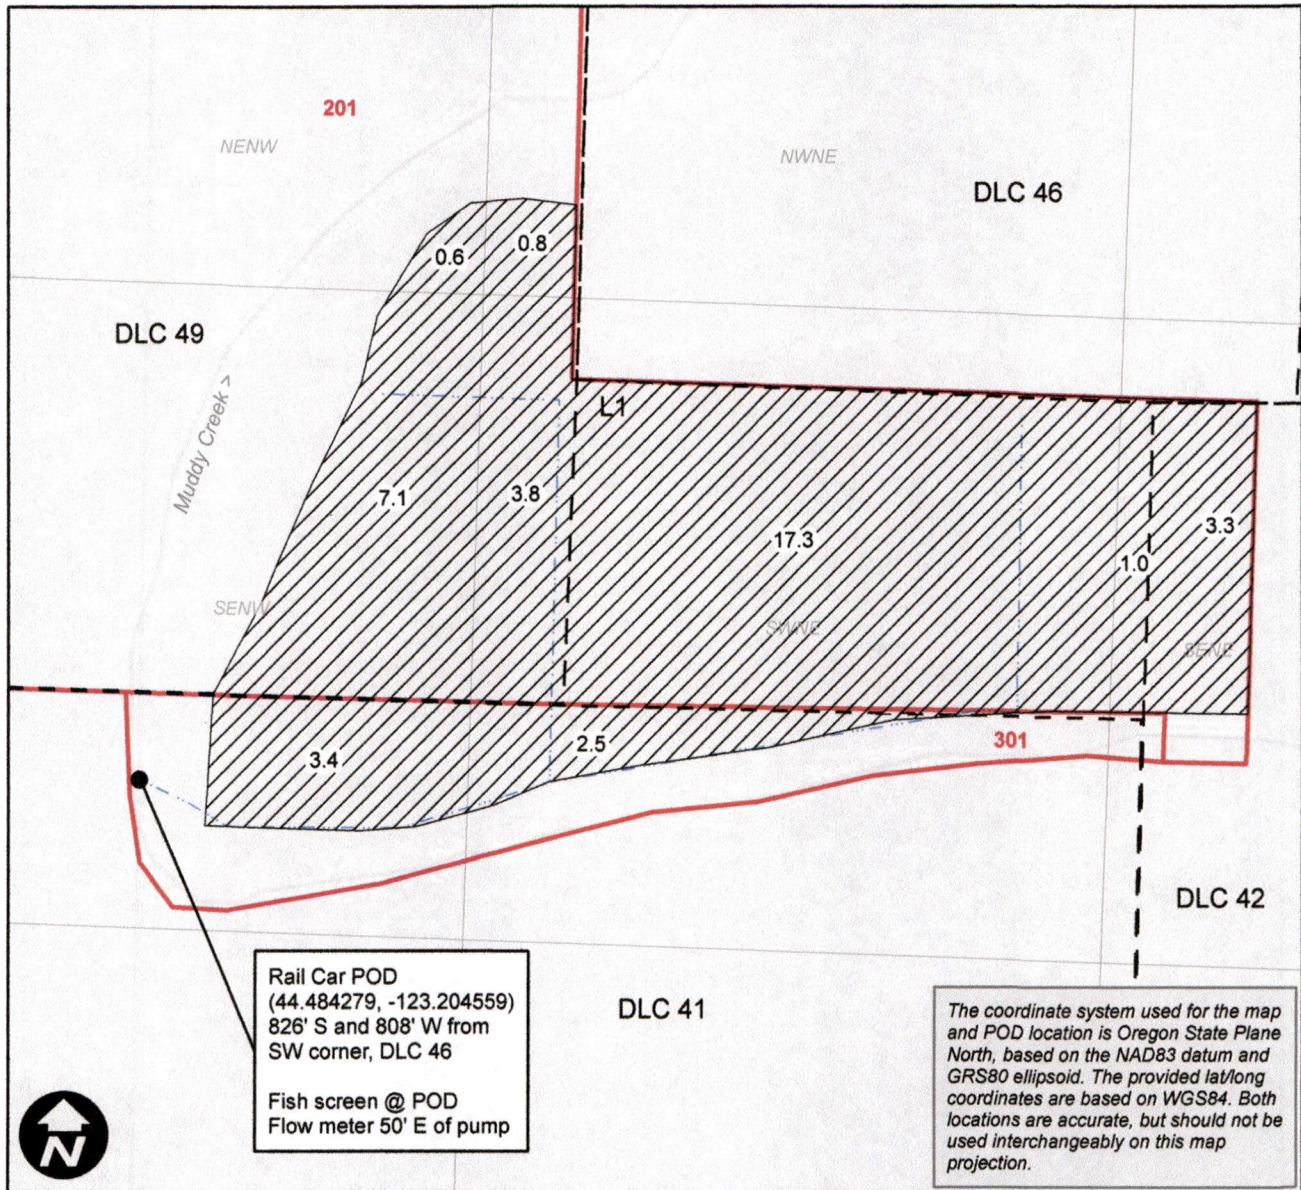

0 200 400 800 Feet

This map is not intended to provide legal dimensions or locations of property ownership lines.

Legend

- IR POU
- DLC
- Mainline
- Taxlot



Received by OWRD

SEP 25 2026

Salem, OR

EXPIRES: 12/31/26