

Frank Barnett
10,000 Acre Rd.
Monmouth, Oregon
97361


13-12

Application No. R-81321
Permit No.

IMPORTANT
This Map for Assessment
and Taxation Purposes
ONLY

SEC. 6 T.10S. R.4W. W.M.
POLK COUNTY
SCALE 1" = 400'

10 4 6

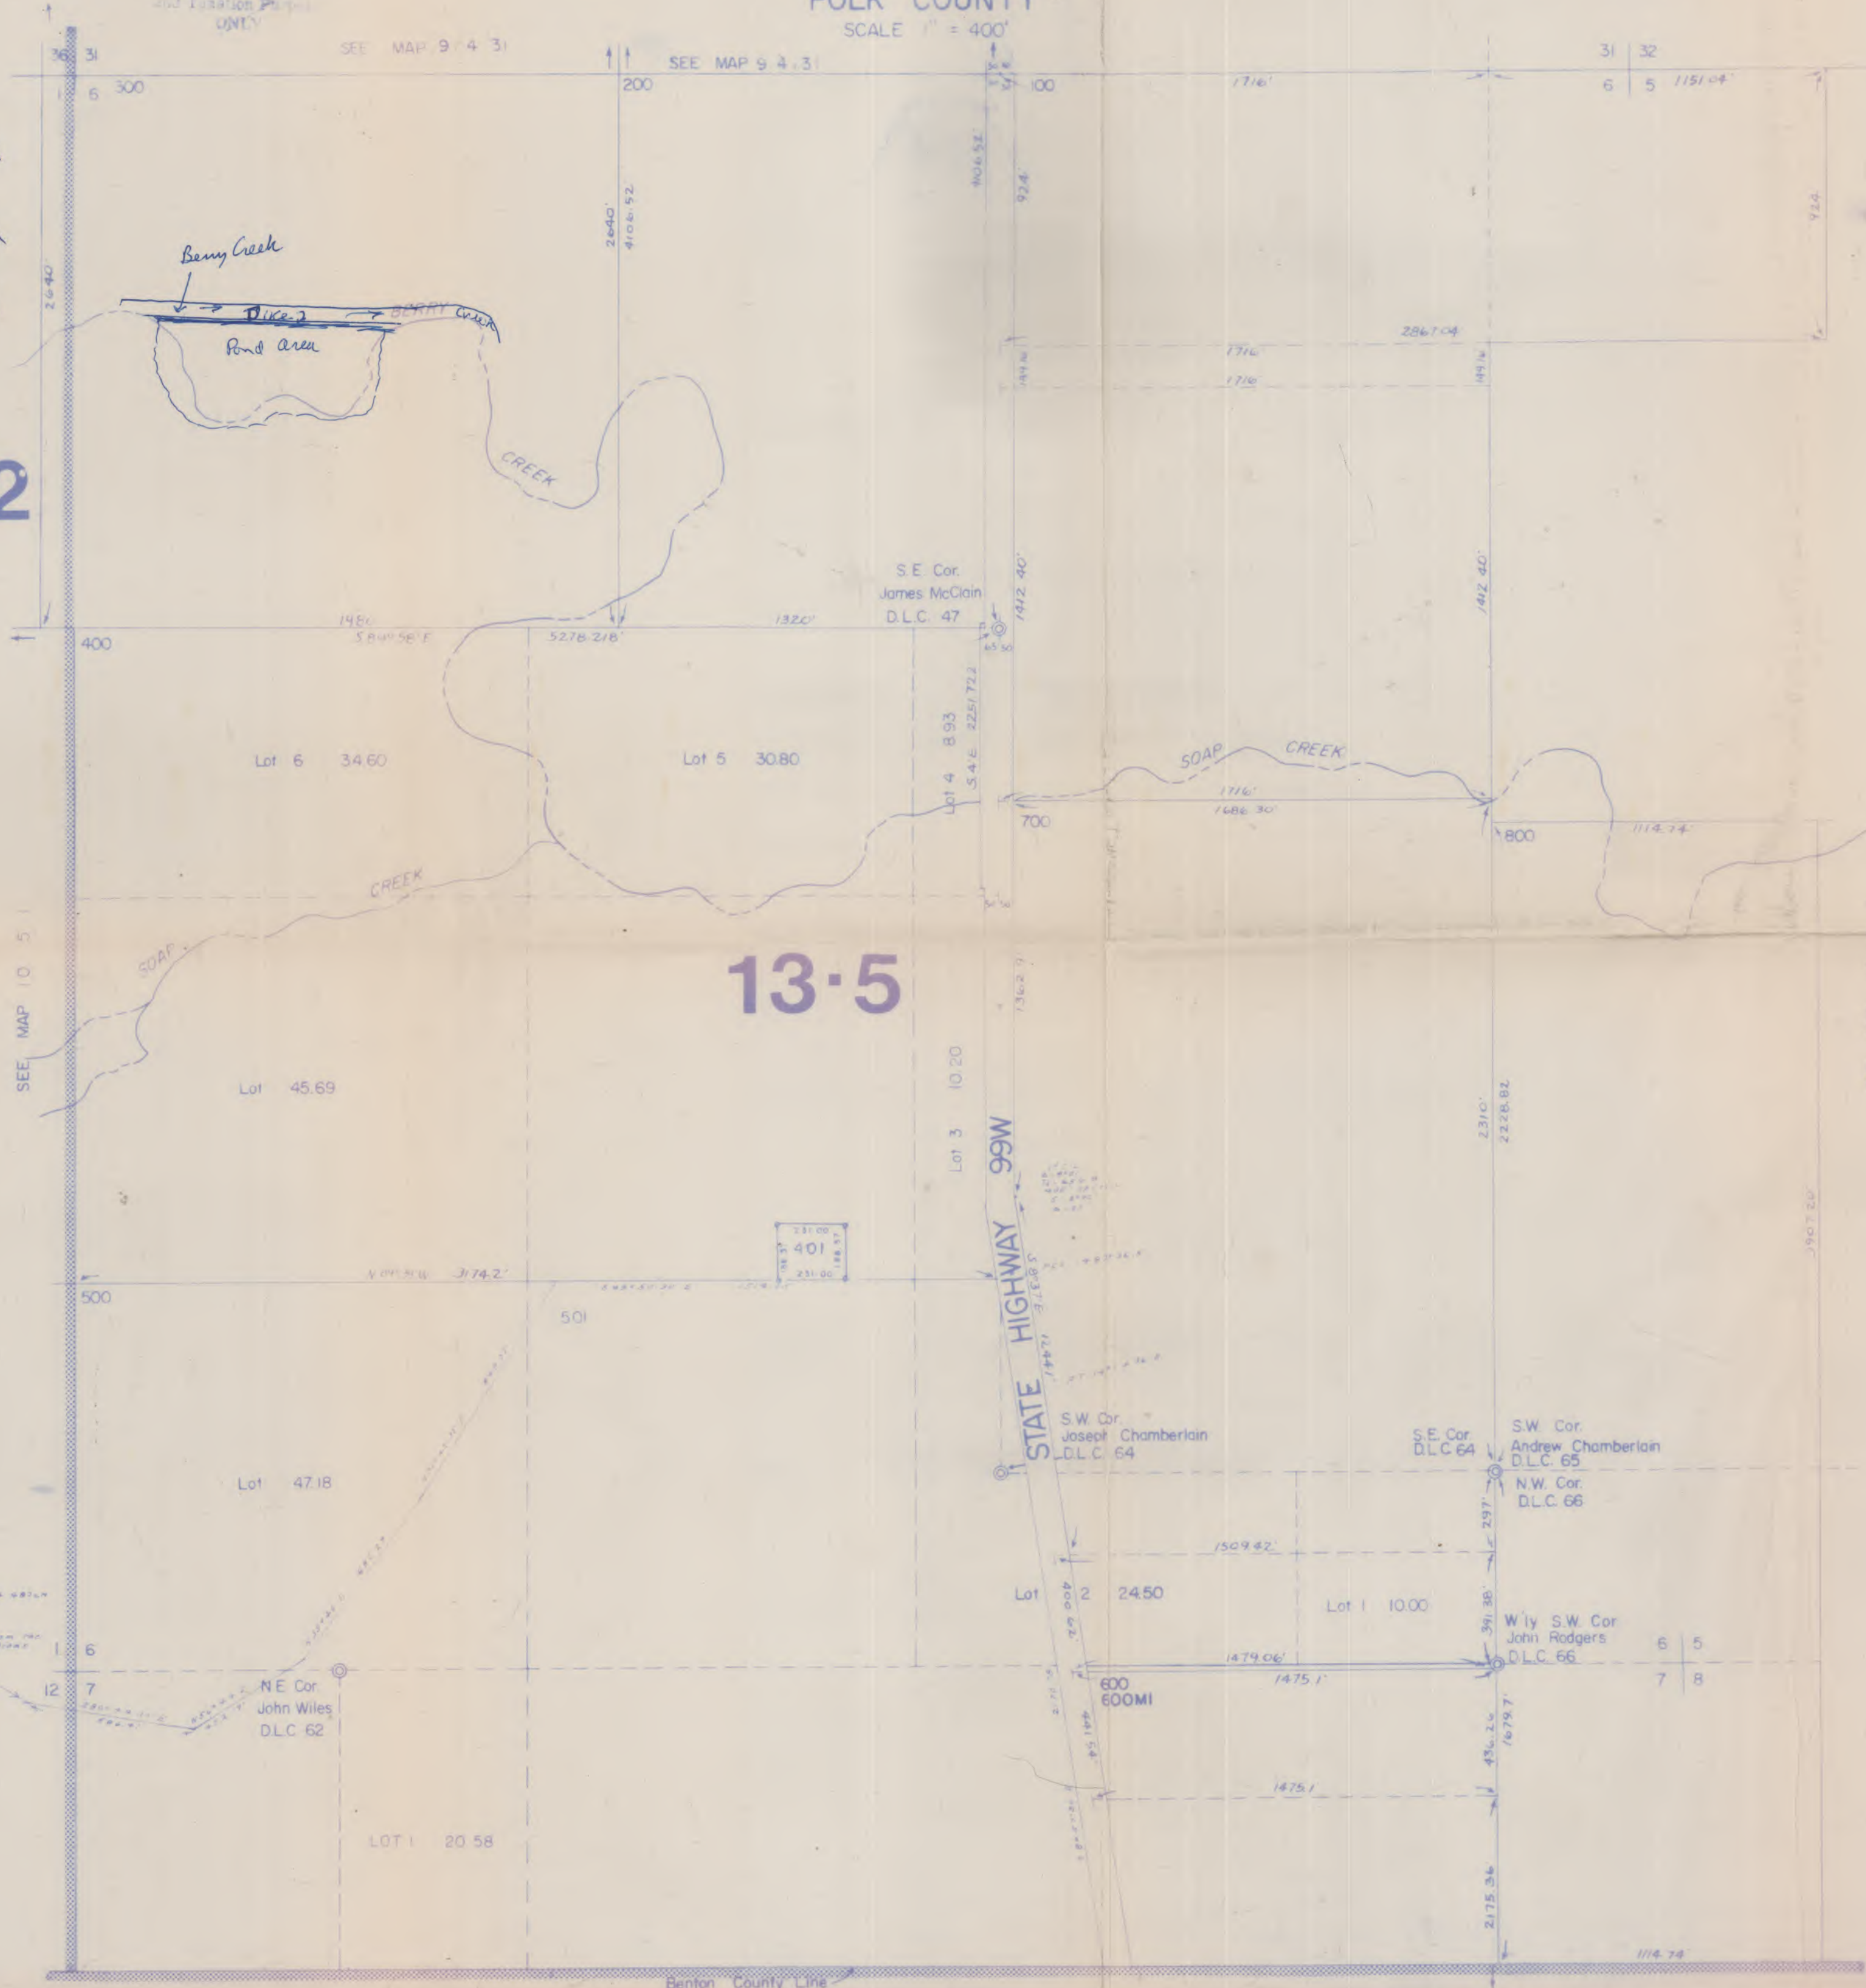

10 4 6

This is a map from the Polk County
ASCS office 1990 flight.

Linda M. Jones 12-30-94
Program Assistant
CFSA (ASCS)

T9 R5 SEC 6 + 1

Unofficial measurement is about 9 acres