

**MAP SHOWING APPROXIMATE BEARINGS AND
DISTANCES TO PROPERTY CORNERS FOR
Tax Lot 401, Map No. 34-07**

RECEIVED


FEB 03 2003

WATER RESOURCES DEPT.
SALEM, OREGON

SCALE:
1" = 300'

C1/4 Corner

E1/4 Corner

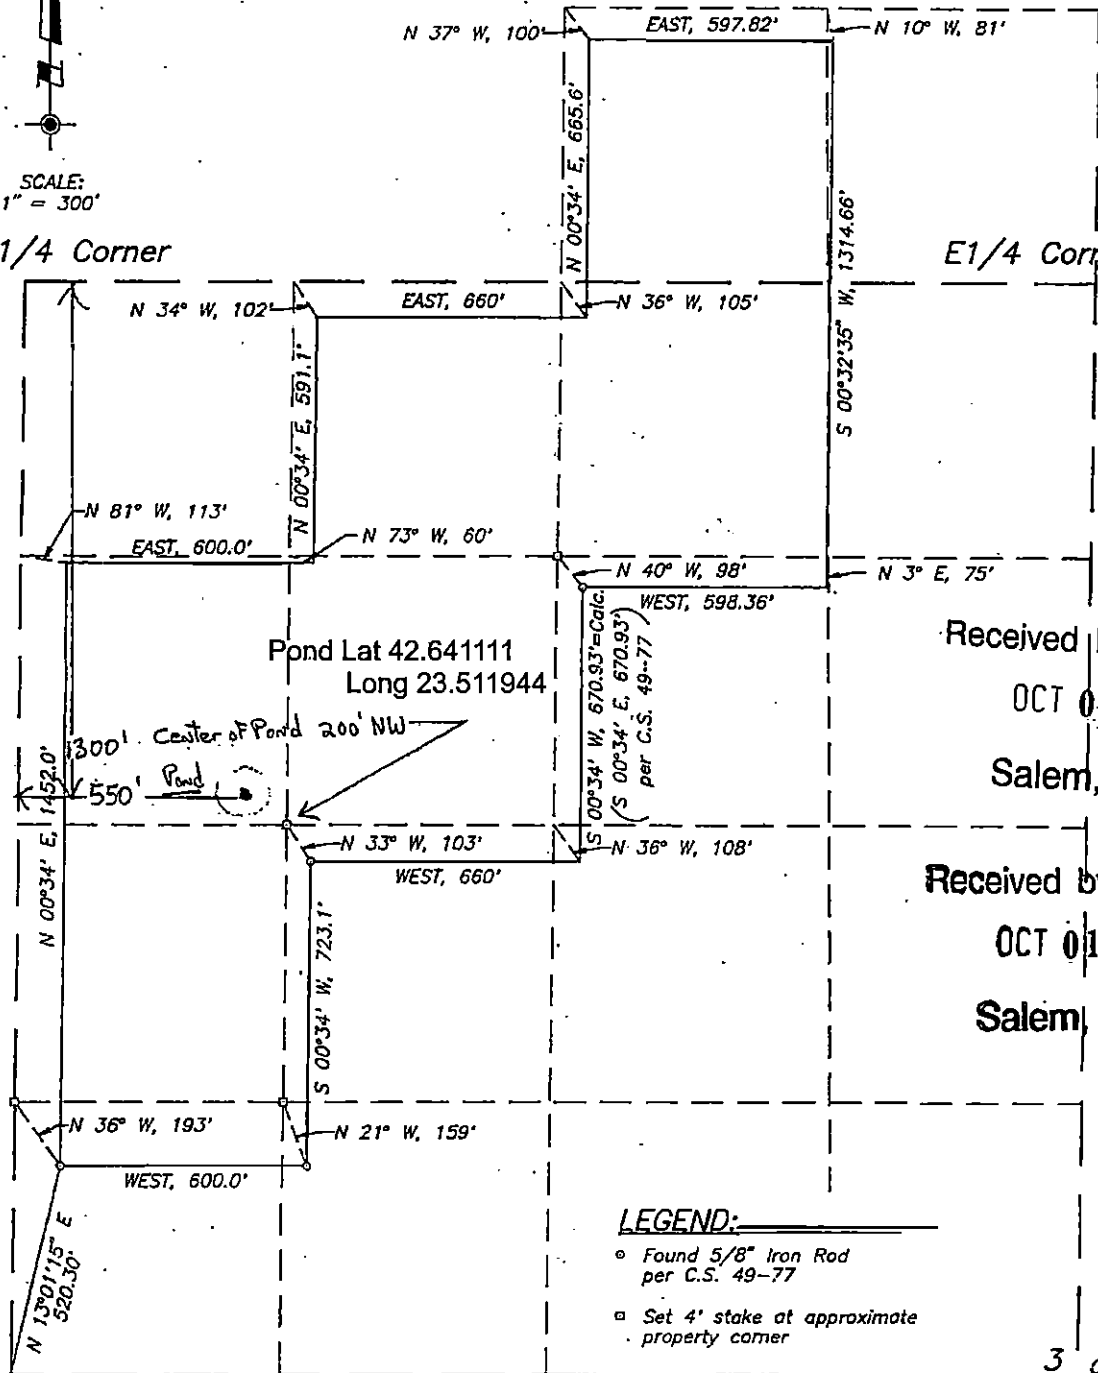

Received by OWRD

OCT 01 2026

Salem, OR

Received by OWRD

OCT 01 2026

Salem, OR

LEGEND:

- Found 5/8" Iron Rod
per C.S. 49-77
- Set 4' stake at approximate
property corner

S1/4 Corner

Section Corner

Note: All dimensions are based upon
Survey No. 49-77.
The bearings and distances to the property
corners are approximate only and are subject
to any error disclosed by an actual on site survey.

PREPARED FOR:
Loy Yokum

Date: June 14, 2000
Drawing No: 80-11.17
p5 \yokum\yokum.dwg

PREPARED BY:
WICKS ENGINEERING & SURVEYING
311 N.E. "D" Street
Grants Pass, Oregon 97526
Tel. (541) 479-3436

App # R-85452
Permit #