
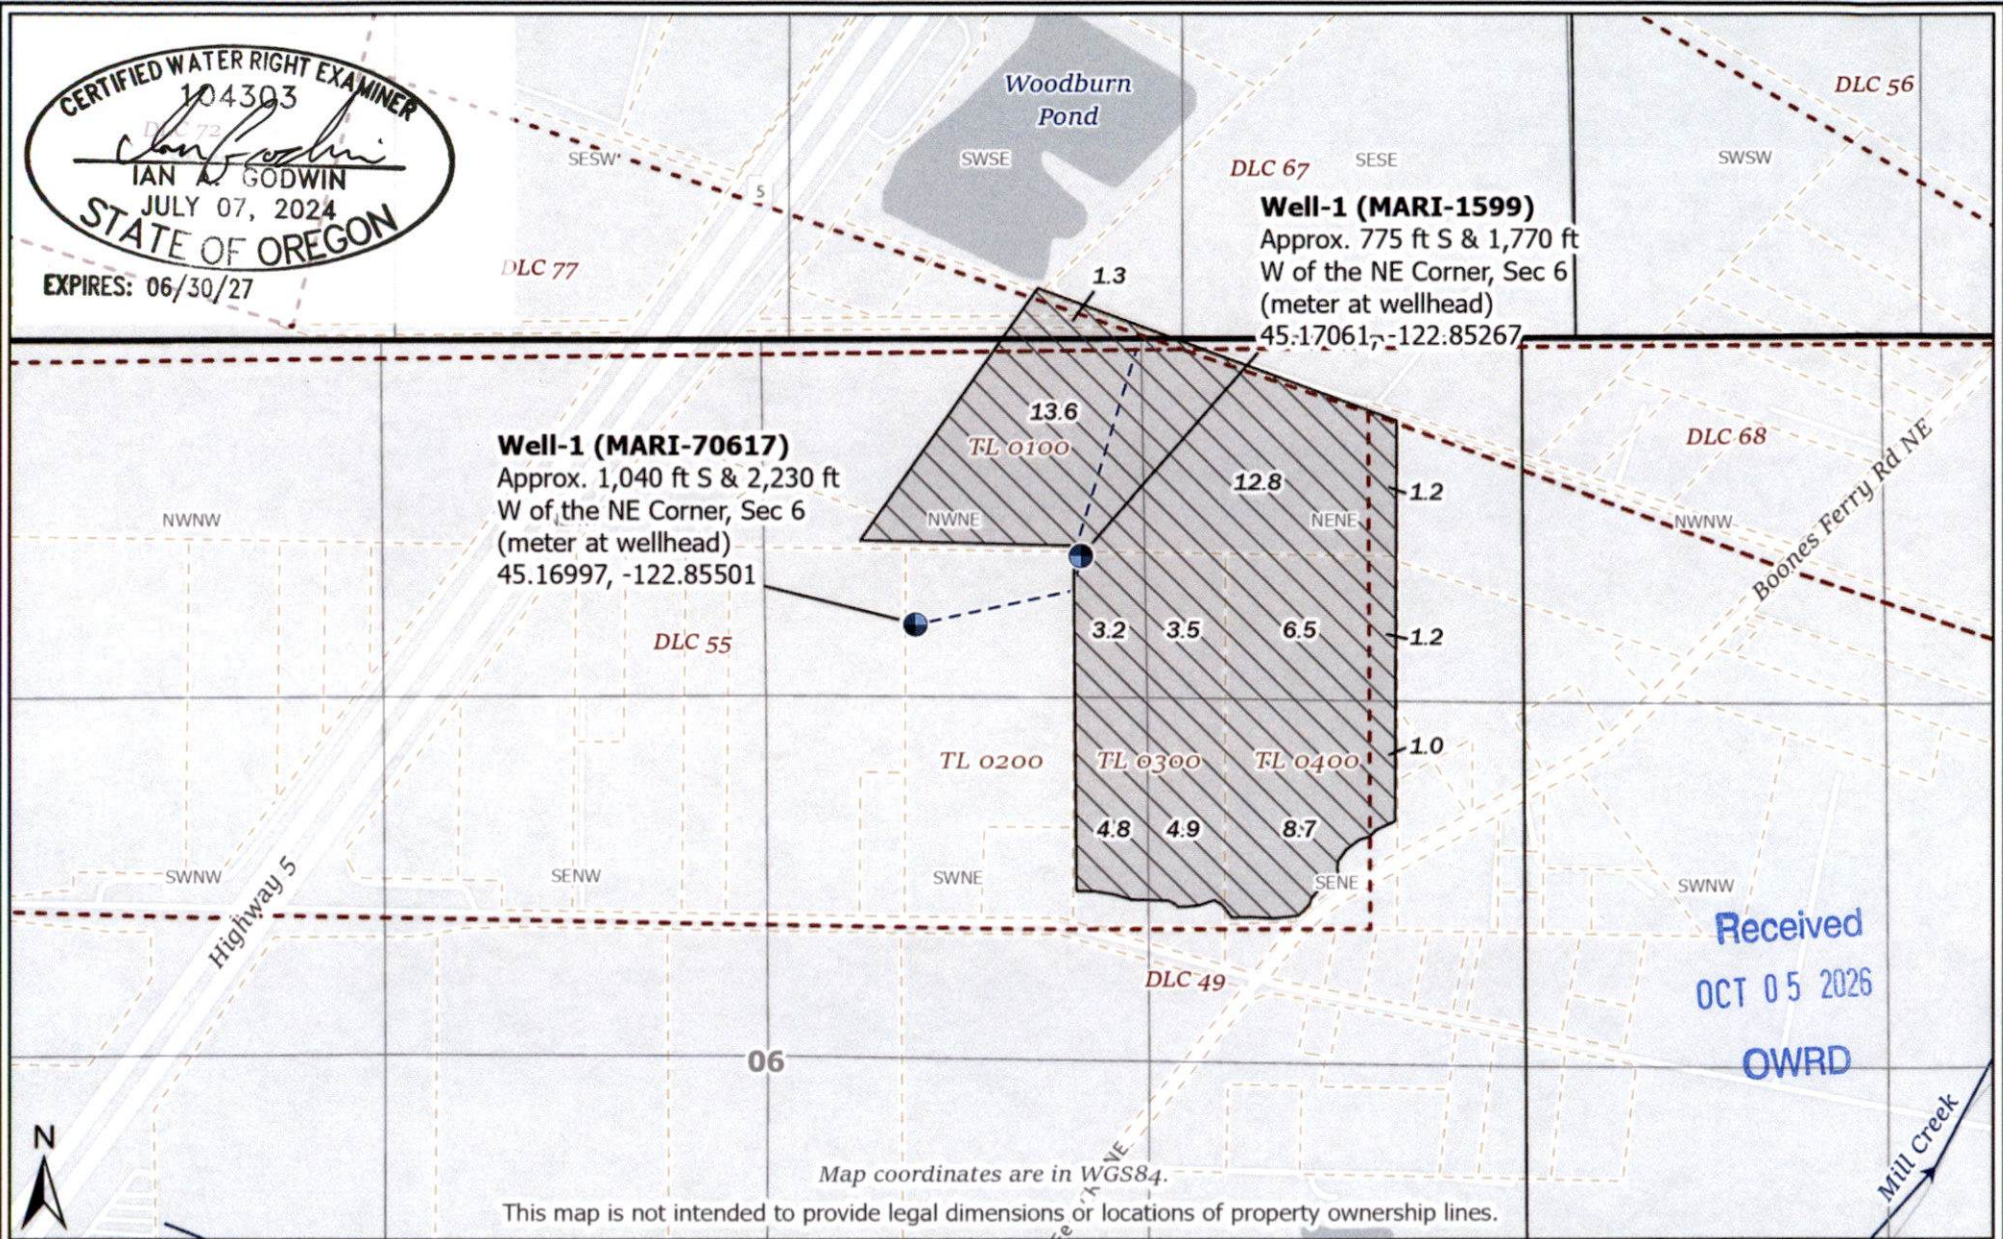


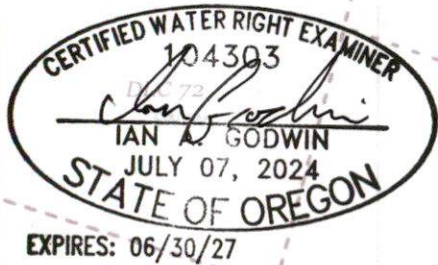


This map is not intended to provide legal dimensions or locations of property ownership lines.

CwM-H2O 
Complete Water Management

311 B Avenue, Suite P
Lake Oswego, Oregon 97034
(503) 954-1326

ATTACHMENT 1
T-14137 Claim of Beneficial Use Map
T4S, R1W, Sec 31 & T5S, R1W, Sec 6

1	DATE	AUTH	DRAFT
No.	Date	By	Revisions

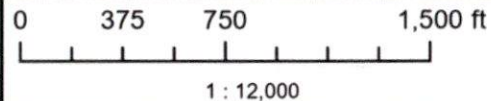

Proj#: 2120001.2
Bountiful Farms CoBU
Bountiful Farms Nursery
17280 Boones Ferry Rd NE
Woodburn, OR 97071

-  Well-2 (MARI-70617)
-  Well-1 (MARI-1599)
-  T-14137 POU
-  Taxlot Boundaries
-  DLC Boundaries
-  Approx. Conveyance