


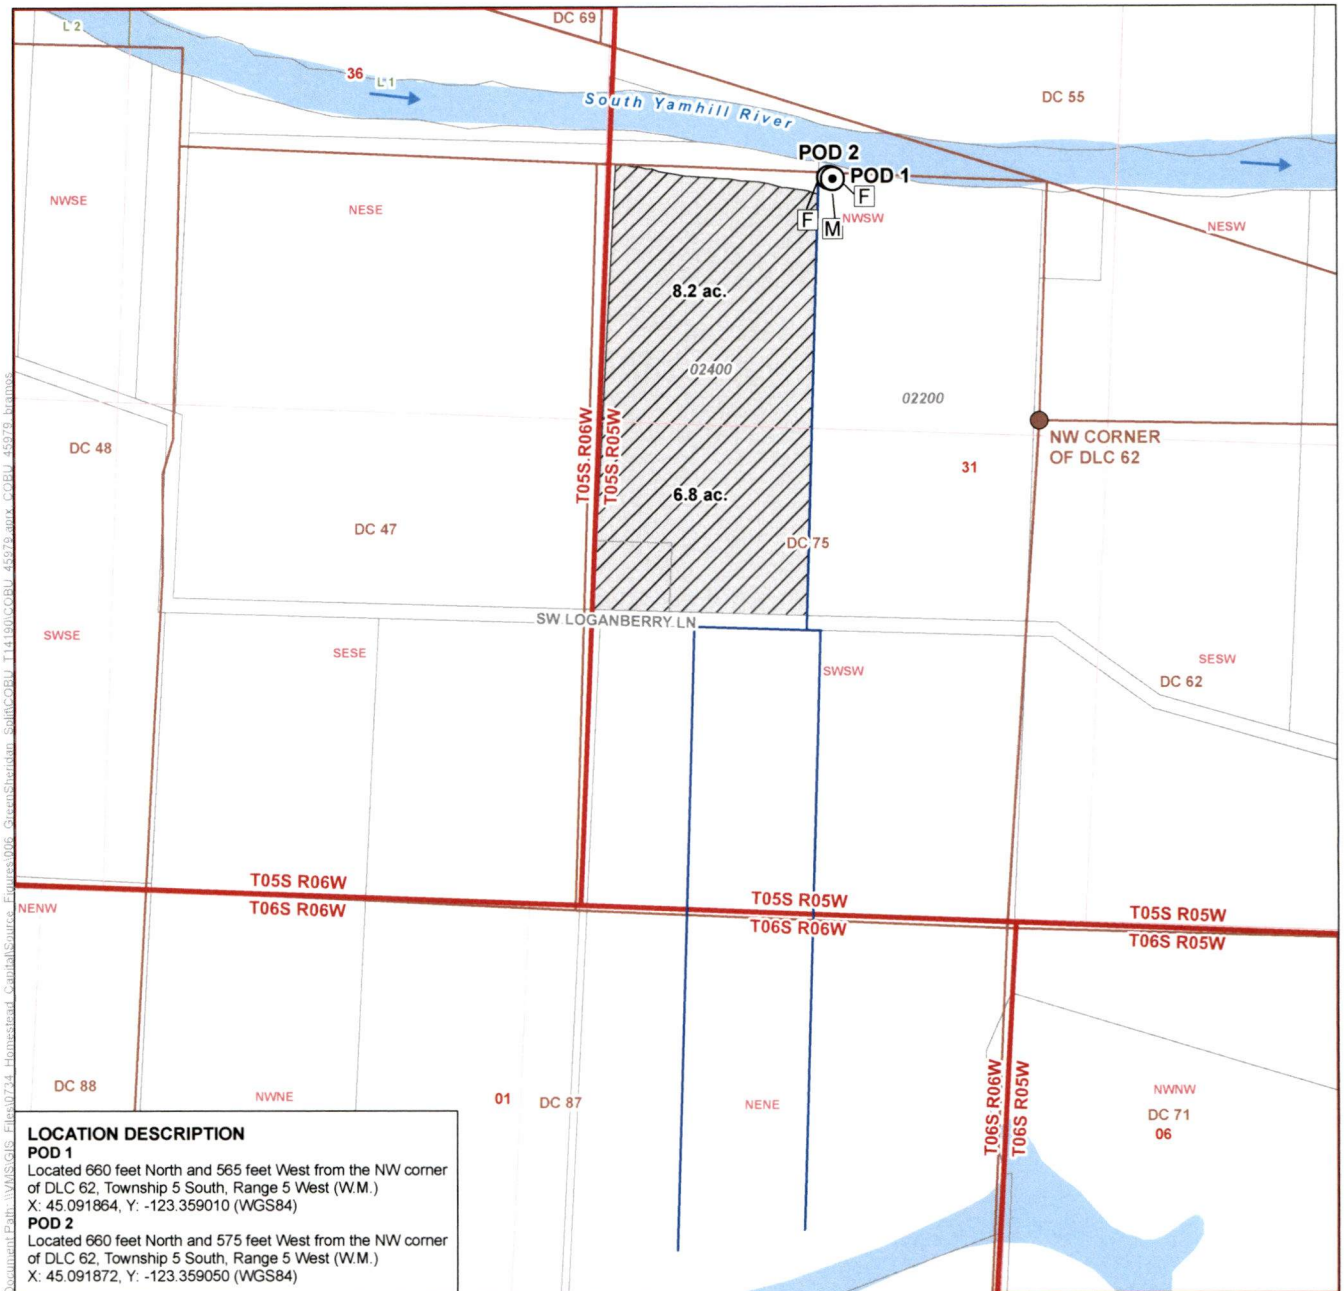

#### LEGEND

- ⊙ Authorized Point of Diversion (POD)
- [F] Fish Screen
- [M] Meter
- Mainline


#### Place of Use (POU)

- [Hatched Box] Authorized Place of Use, POD 1 & POD 2 – 15.0 Acres Irrigation

#### All Other Features

- [Thin Line] Tax Lot
- [Thick Line] Donation Land Survey (DLC)
- [Green Line] Government Lot (GL)
- [Blue Line] Watercourse
- [Blue Area] Waterbody

#### CERTIFIED WATER RIGHTS EXAMINER STAMP

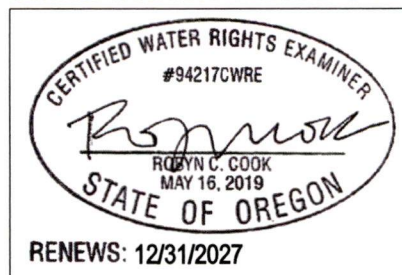

## Claim of Beneficial Use Map Green Sheridan IV, LLC Transfer T-14190

**Certificate 45979 (Application 46441)**

Township 5/6 North, Range 5/6 West (W.M.)

Received


OCT 05 2026


OWRD

#### DISCLAIMER

This map was prepared for the purpose of identifying the location of a water right only and it is not intended to provide legal dimensions or location of property ownership lines.

Date: September 23, 2026  
 Data Sources: BLM, ESRI, OWRD, USGS

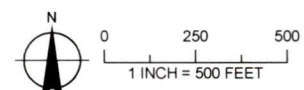

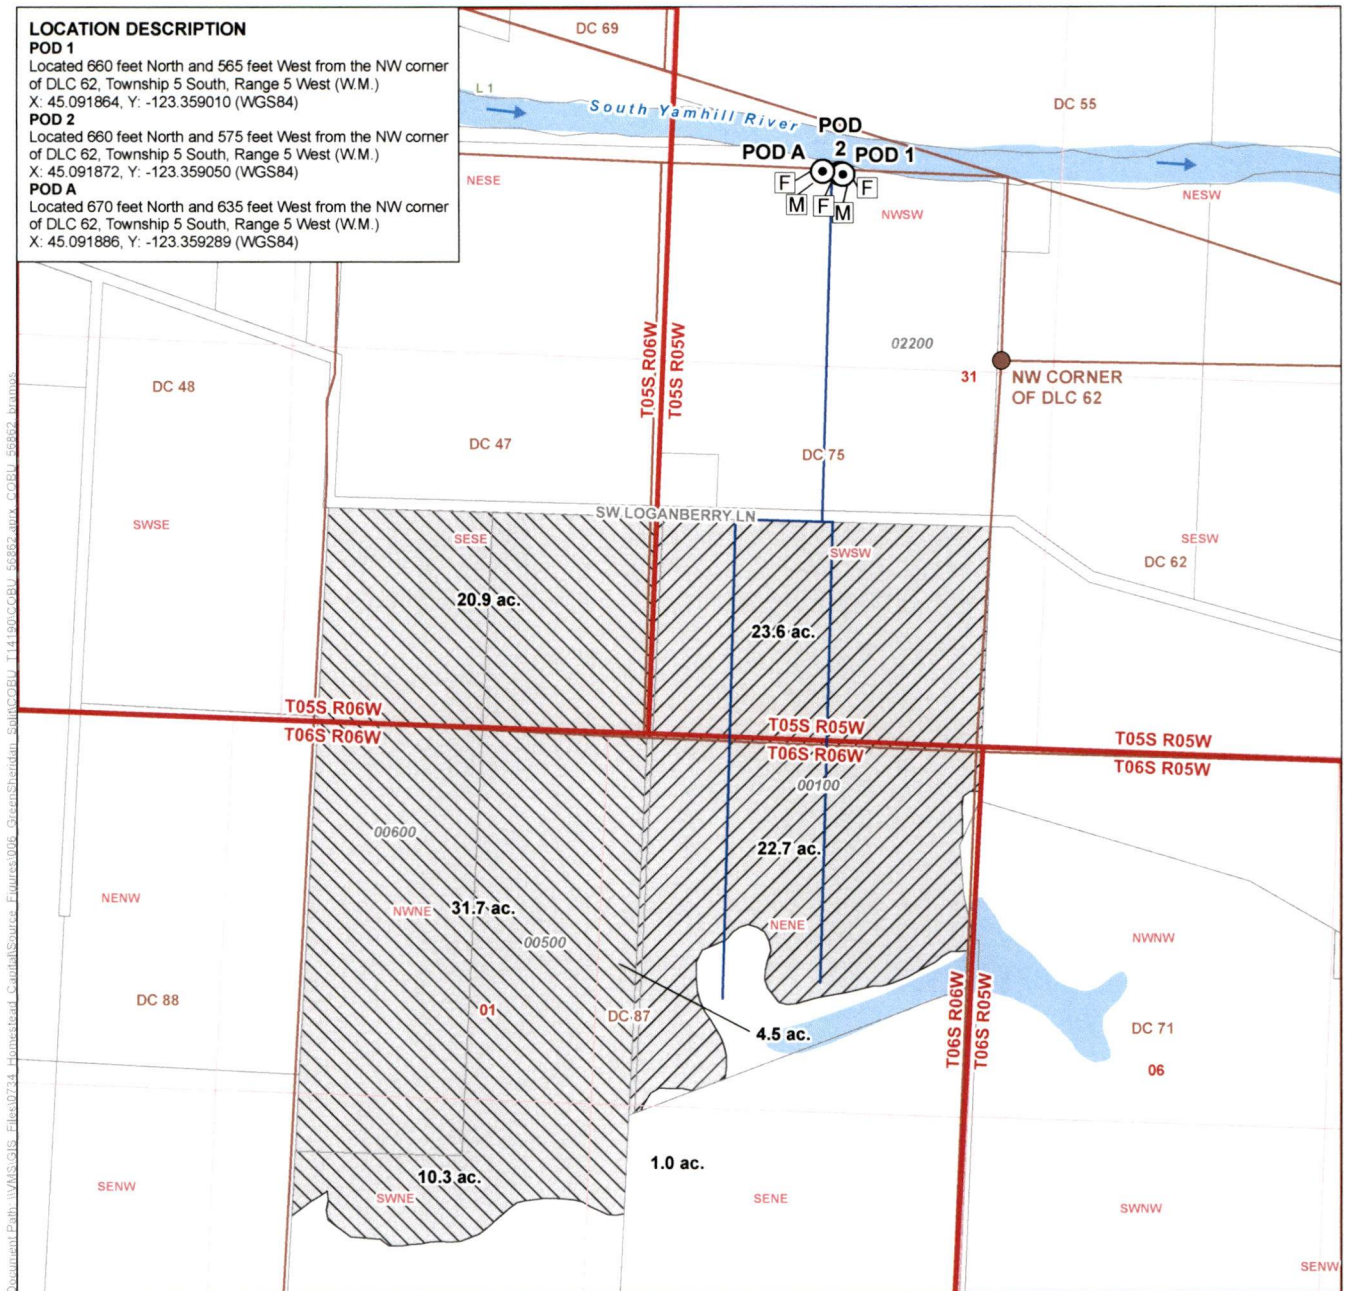

# **LEGEND**

- Authorized Point of Diversion (POD)
- Fish Screen
- Meter
- Mainline


## **Place of Use (POU)**

- Authorized Place of Use, POD 1 & POD 2 - 46.3 Acres Irrigation
- Authorized Place of Use, POD A - 68.4 Acres Irrigation

## **All Other Features**

- Tax Lot
- Donation Land Survey (DLC)
- Government Lot (GL)
- Watercourse
- Waterbody

## **CERTIFIED WATER RIGHTS EXAMINER STAMP**

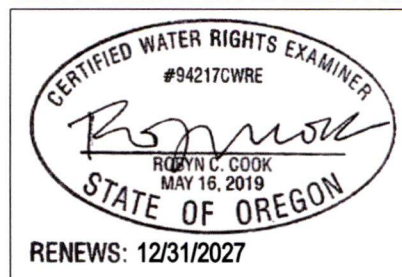


## **Claim of Beneficial Use Map** **Green Sheridan IV, LLC** **Transfer T-14190**

**Certificate 56862 (Application 51876)**

**Township 5/6 North, Range 5/6 West (W.M.)**

**Received**  
**OCT 05 2026**

**OWRD**

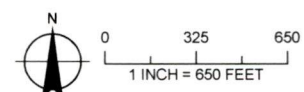


## **DISCLAIMER**

This map was prepared for the purpose of identifying the location of a water right only and it is not intended to provide legal dimensions or location of property ownership lines.

Date: September 23, 2026  
 Data Sources: BLM, ESRI, OWRD, USGS



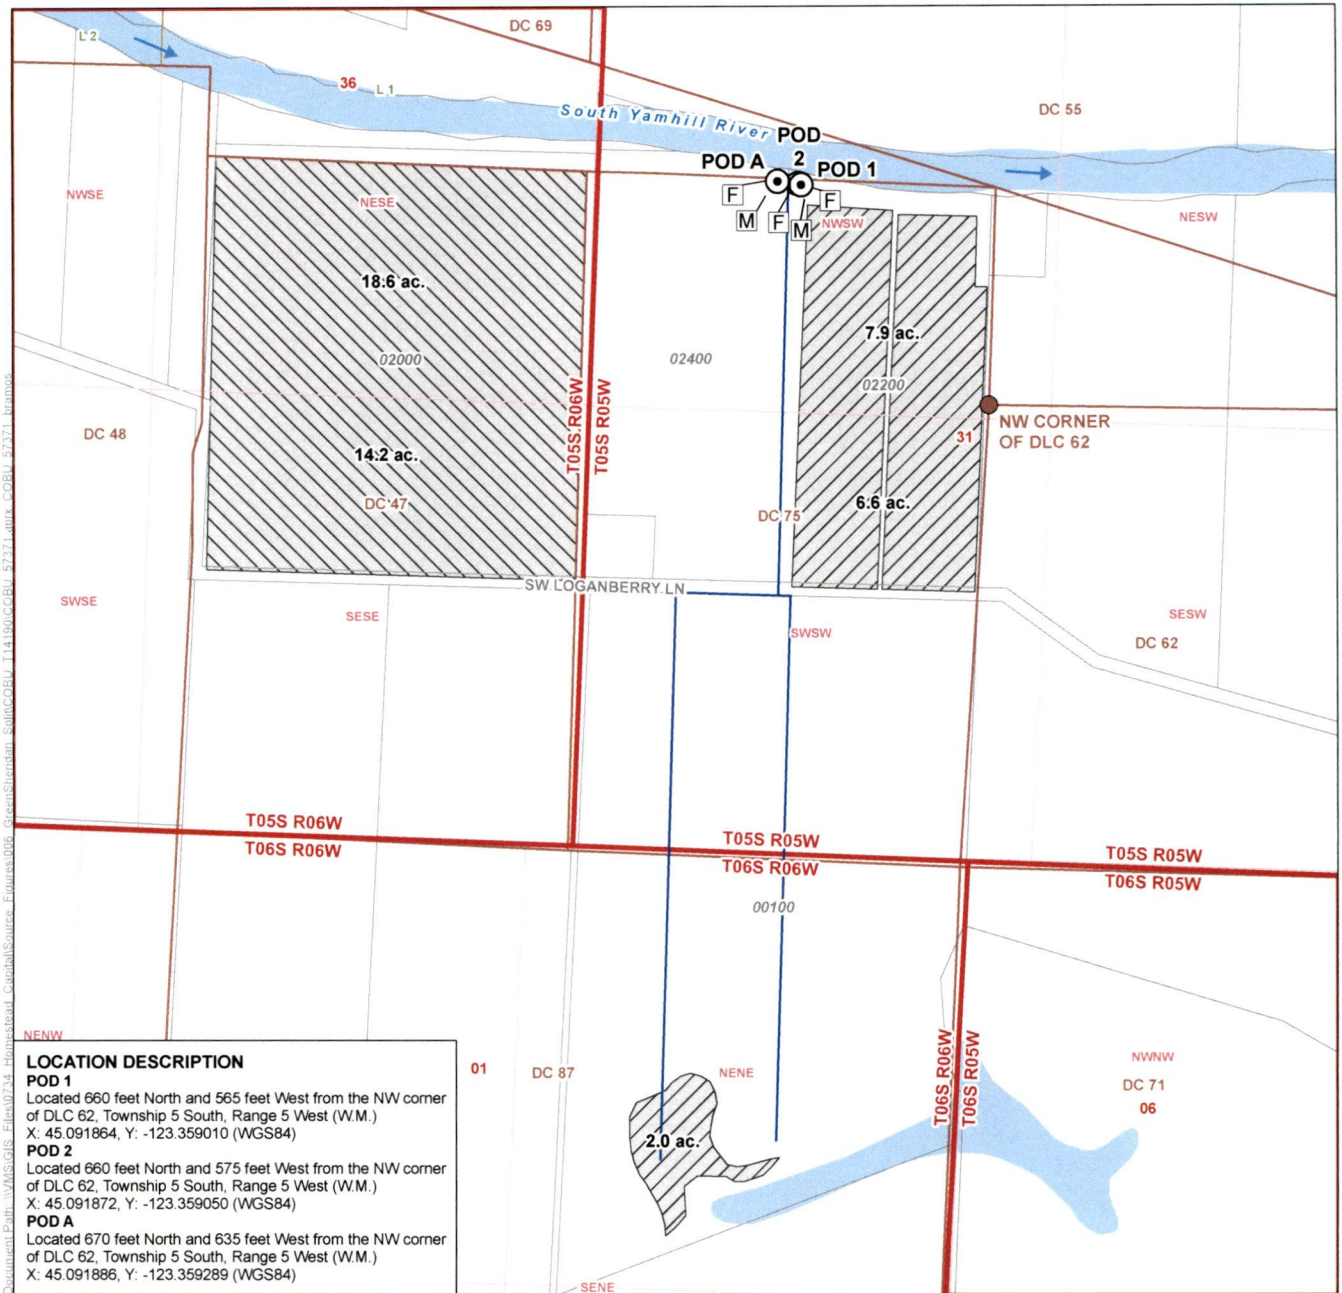

#### LEGEND

- ⊙ Authorized Point of Diversion (POD)
- [F] Fish Screen
- [M] Meter
- Mainline

#### Place of Use (POU)

- [Hatched Box] Authorized Place of Use, POD 1 & POD 2 – 16.5 Acres Irrigation
- [Hatched Box] Authorized Place of Use, POD A – 32.8 Acres Irrigation

#### All Other Features


- [Outline Box] Tax Lot
- [Red Outline Box] Donation Land Survey (DLC)
- [Green Outline Box] Government Lot (GL)
- [Blue Line] Watercourse
- [Blue Area] Waterbody

## Claim of Beneficial Use Map Green Sheridan IV, LLC Transfer T-14190

Certificate 57371 (Application 46441)

Township 5/6 North, Range 5/6 West (W.M.)

#### CERTIFIED WATER RIGHTS EXAMINER STAMP

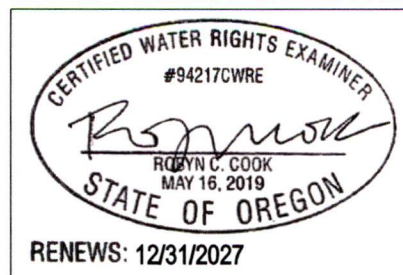

Received  
OCT 05 2026

OWRD

**DISCLAIMER**  
This map was prepared for the purpose of identifying the location of a water right only and it is not intended to provide legal dimensions or location of property ownership lines.

Date: September 23, 2026  
Data Sources: BLM, ESRI, OWRD, USGS

