

Received
OCT 01 2026




SCALE: 1" = 1320'


CLAIM of BENEFICIAL USE MAP

FOR: COUNCIL GROVE FARM
BY: NATHAN REED, PE, CWRE
T23S, R7W, W.M. SECTION 19, DLC 43
APPLICATION NO. S-89189
PERMIT NO. S-55408


DATE OF SURVEY: SEPTEMBER 4, 2026

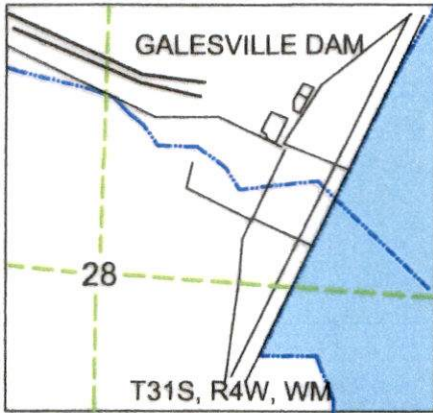

SCALE: 1" = 400'

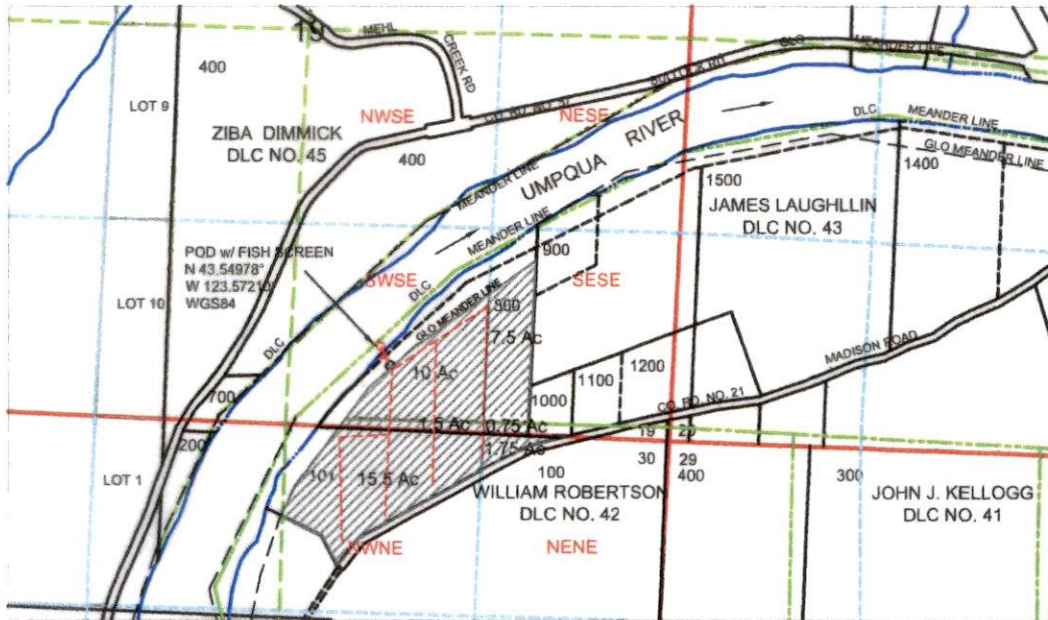

POD IS LOCATED 2227 FEET SOUTH & 530 FEET EAST OF C1/4 CORNER OF SECTION 19 WITHIN DLC NO. 43.

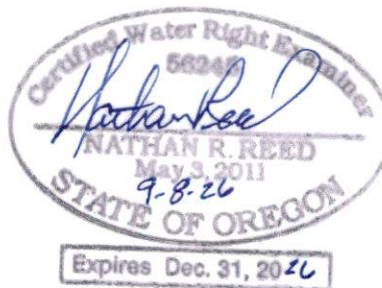

LEGEND

	WATER		SECTION
	POD		QUARTER
	PUMP		SIXTEENTH
	METER		DLC
	PIPE		GLOT
	PARCEL		IRRIGATION

MAP PREPARED FOR:
DAVID & CLAUDIA MADISON
1916 MADISON ROAD
OAKLAND, OR 97462

MAP PREPARED BY:
NATHAN REED PE, CWRE
157 WEST BODIE STREET
ROSEBURG, OR 97471

THE PURPOSE OF THIS MAP IS TO IDENTIFY THE LOCATION OF THE WATER RIGHT. IT IS NOT INTENDED TO PROVIDE INFORMATION RELATIVE TO THE LOCATION OF PROPERTY OWNERSHIP BOUNDARY LINES.