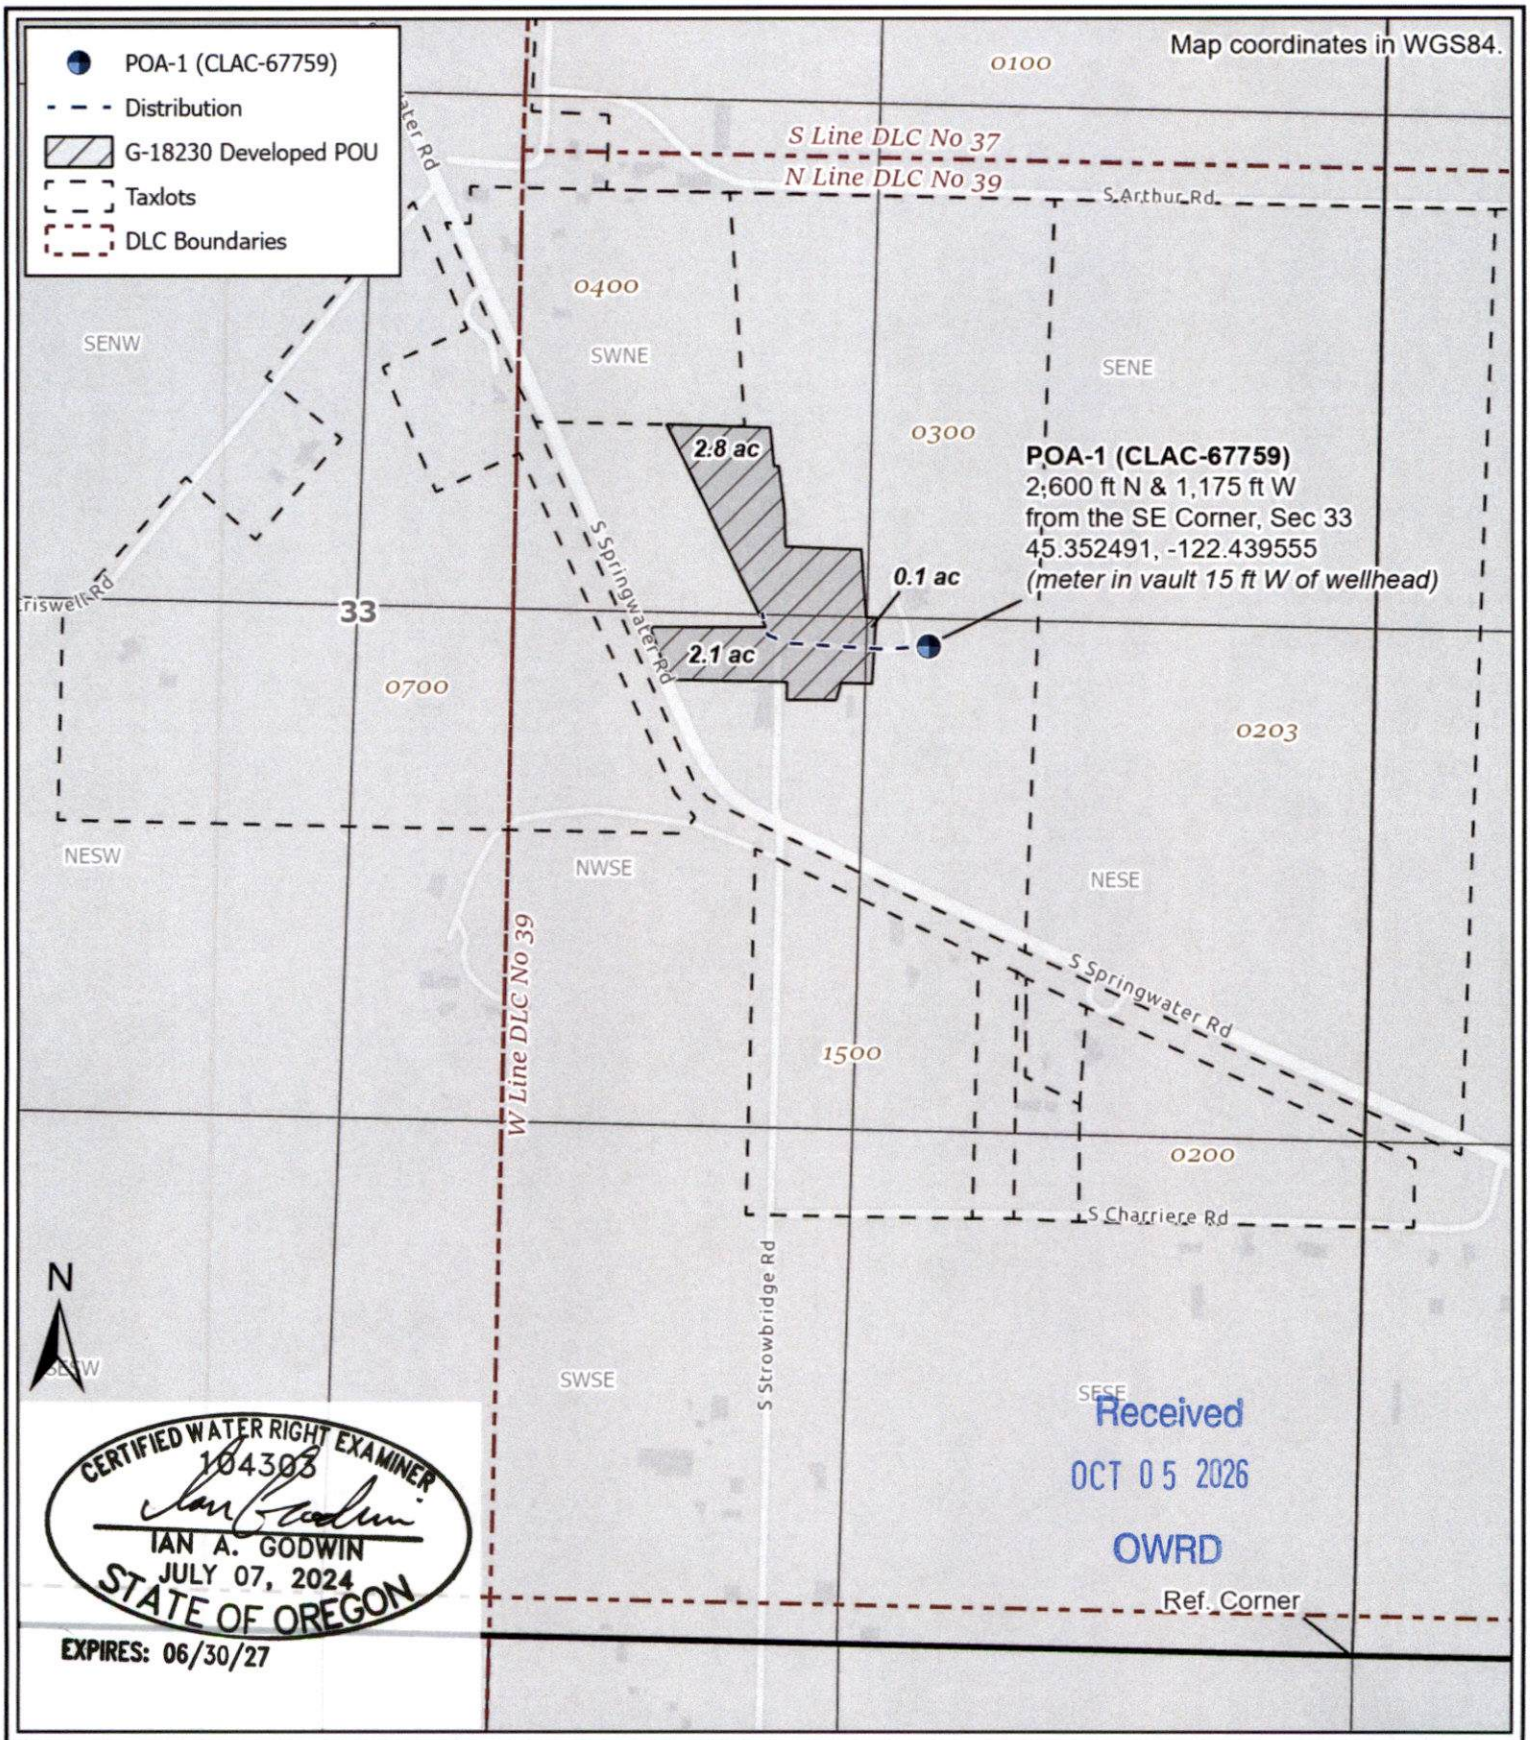


CERTIFIED WATER RIGHT EXAMINER
104303
IAN A. GODWIN
JULY 07, 2024
STATE OF OREGON
EXPIRES: 06/30/27

Received
OCT 05 2026
OWRD

ATTACHMENT 1
Claim of Beneficial Use - Permit G-18230
T2S, R3E, Section 33

0 500 1,000 2,000 ft
1 : 6,000

No.	Date	By	Revisions
1	DATE	AUTH	DRAFT

Proj#: 1807001
Willits WR

M&W Tree Farm
17500 S Springwater Rd
Oregon City, OR 97045

CwM-H2O
Complete Water Management
311 B Avenue, Suite P
Lake Oswego, Oregon 97034
(503) 954-1326