

Request for Assignment By Proof of Ownership (If Water Right Holder is Not Available)



Oregon Water Resources Department
725 Summer Street NE, Suite A
Salem, Oregon 97301-1266
(503) 986-0900
www.oregon.gov/owrd

If the Department determines that the application is incomplete, fees have not been paid, or the required documents are not acceptable, the application and all fees submitted will be returned to the applicant.

If for multiple rights, a separate form and fee for each right will be required.

1. Albrecht Family Farms LLC
(Name of Party Requesting Assignment)

P.O. Box 741
(Mailing Address)

CRANE
(City)

OR 97721
(State) (Zip)

541-990-5604
(Phone #)

albrechtfarms@yahoo.com
(Email Address)

☐ hereby request assignment of an entire application/permit/transfer order /limited license/groundwater statement

☒ hereby request assignment of a portion of application/permit/transfer order/limited license/groundwater statement;
(You must include a map showing the portion of the application/permit/ transfer order /limited license/groundwater statement to be assigned.)

Application # 6-12664 ; Permit # 6-11956 ; Transfer Order # _____;

Limited License # _____ ; Groundwater Statement # _____

Herb DAVIS & Sons
(Name of Current Holder of Record)

(Mailing Address)

(City)

(State) (Zip)

(Phone #)

Note: Write the initials (first letters) of your first and last names at the spots indicated below _____.

1) JA I certify that I am the current owner of the property described in this application, permit, transfer order, limited license, or groundwater statement. I have attached proof of ownership that may include but not be limited to: a copy of the deed to the land, a copy of a land sales contract, a court order or decree, documentation of survivorship of property held jointly. The Department cannot accept a copy of a tax statement.

2) JA I have the legal right to request assignment under OAR 690-310-0280 and 690-320-0060.

3) JA I have not been able to contact the owner(s) of record for the above referenced transaction. I have attached proof acceptable to the Department that notice of the assignment has been given or attempted for each identified property owner not a party to the assignment. ORS 537.220(2) Failure to submit this proof will result in the return of your request. (Proof may include but not be limited to: a copy of returned certified mailing, copy of a Death Certificate, or a court order.)

4) JA I further certify that the information provided herein is true and correct to the best of my knowledge.

Witness my hand this _____ day of _____, 20____.
(Day) (Month) (Year)

Signature of Party Requesting Assignment Jessie Albrecht

09/30/26

Failure to provide any of the required information will result in the return of your application.

This certifies assignment and record change at Oregon Water Resources Department effective 8:00 a.m. on date of receipt at Salem, Oregon.

Fee receipt # 148187

For Director by Mary F. Bjork, Program Analyst in Water Rights Division. MFB

The completed "Request for Assignment" form must be submitted to the Department along with the recording fee of \$180.

RECEIVED

OCT 01 2026

OWRD


part assign by proof - approve
MFB 10.2.2026

T. 26 S., R. 33 E., W.M.

RECEIVED

OCT 01 2026

OWRD

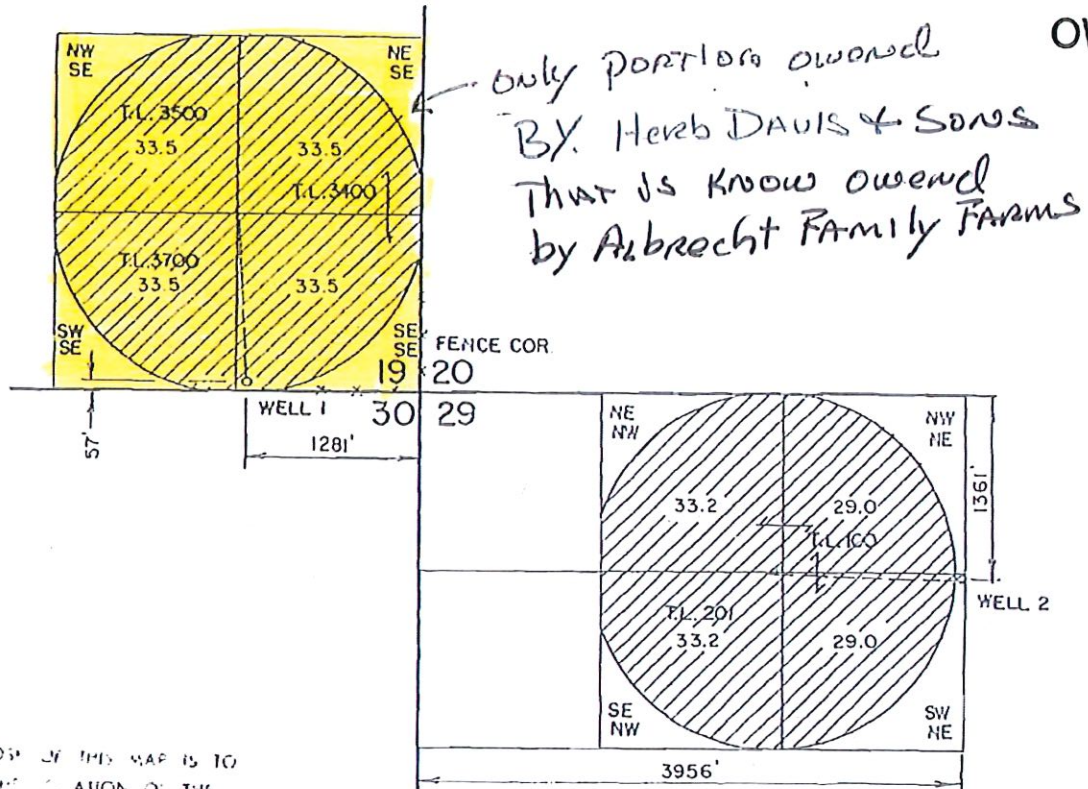

Chris T. Palmer Nov. 19, 1987 STATE OF OREGON RENEW 1-1-1999	FINAL PROOF SURVEY		IN THE NAME OF HERB DAVIS AND SONS	
	UNDER APPLICATION NO. G-12664 PERMIT NO. G-11956			
	Scale: 4" = MILE	Date: JAN. 1997	Job: 1338 - 97	
	Dsn: Drn: CHRIS Ckd:	 M. A. PALMER & SONS, INC. ENGINEERING & SURVEYING 254 N. Alder - Box 61 Burns, Oregon 97720	Sht. No. of 1	