


T. 11S, R. 5W, W.M. Section 25

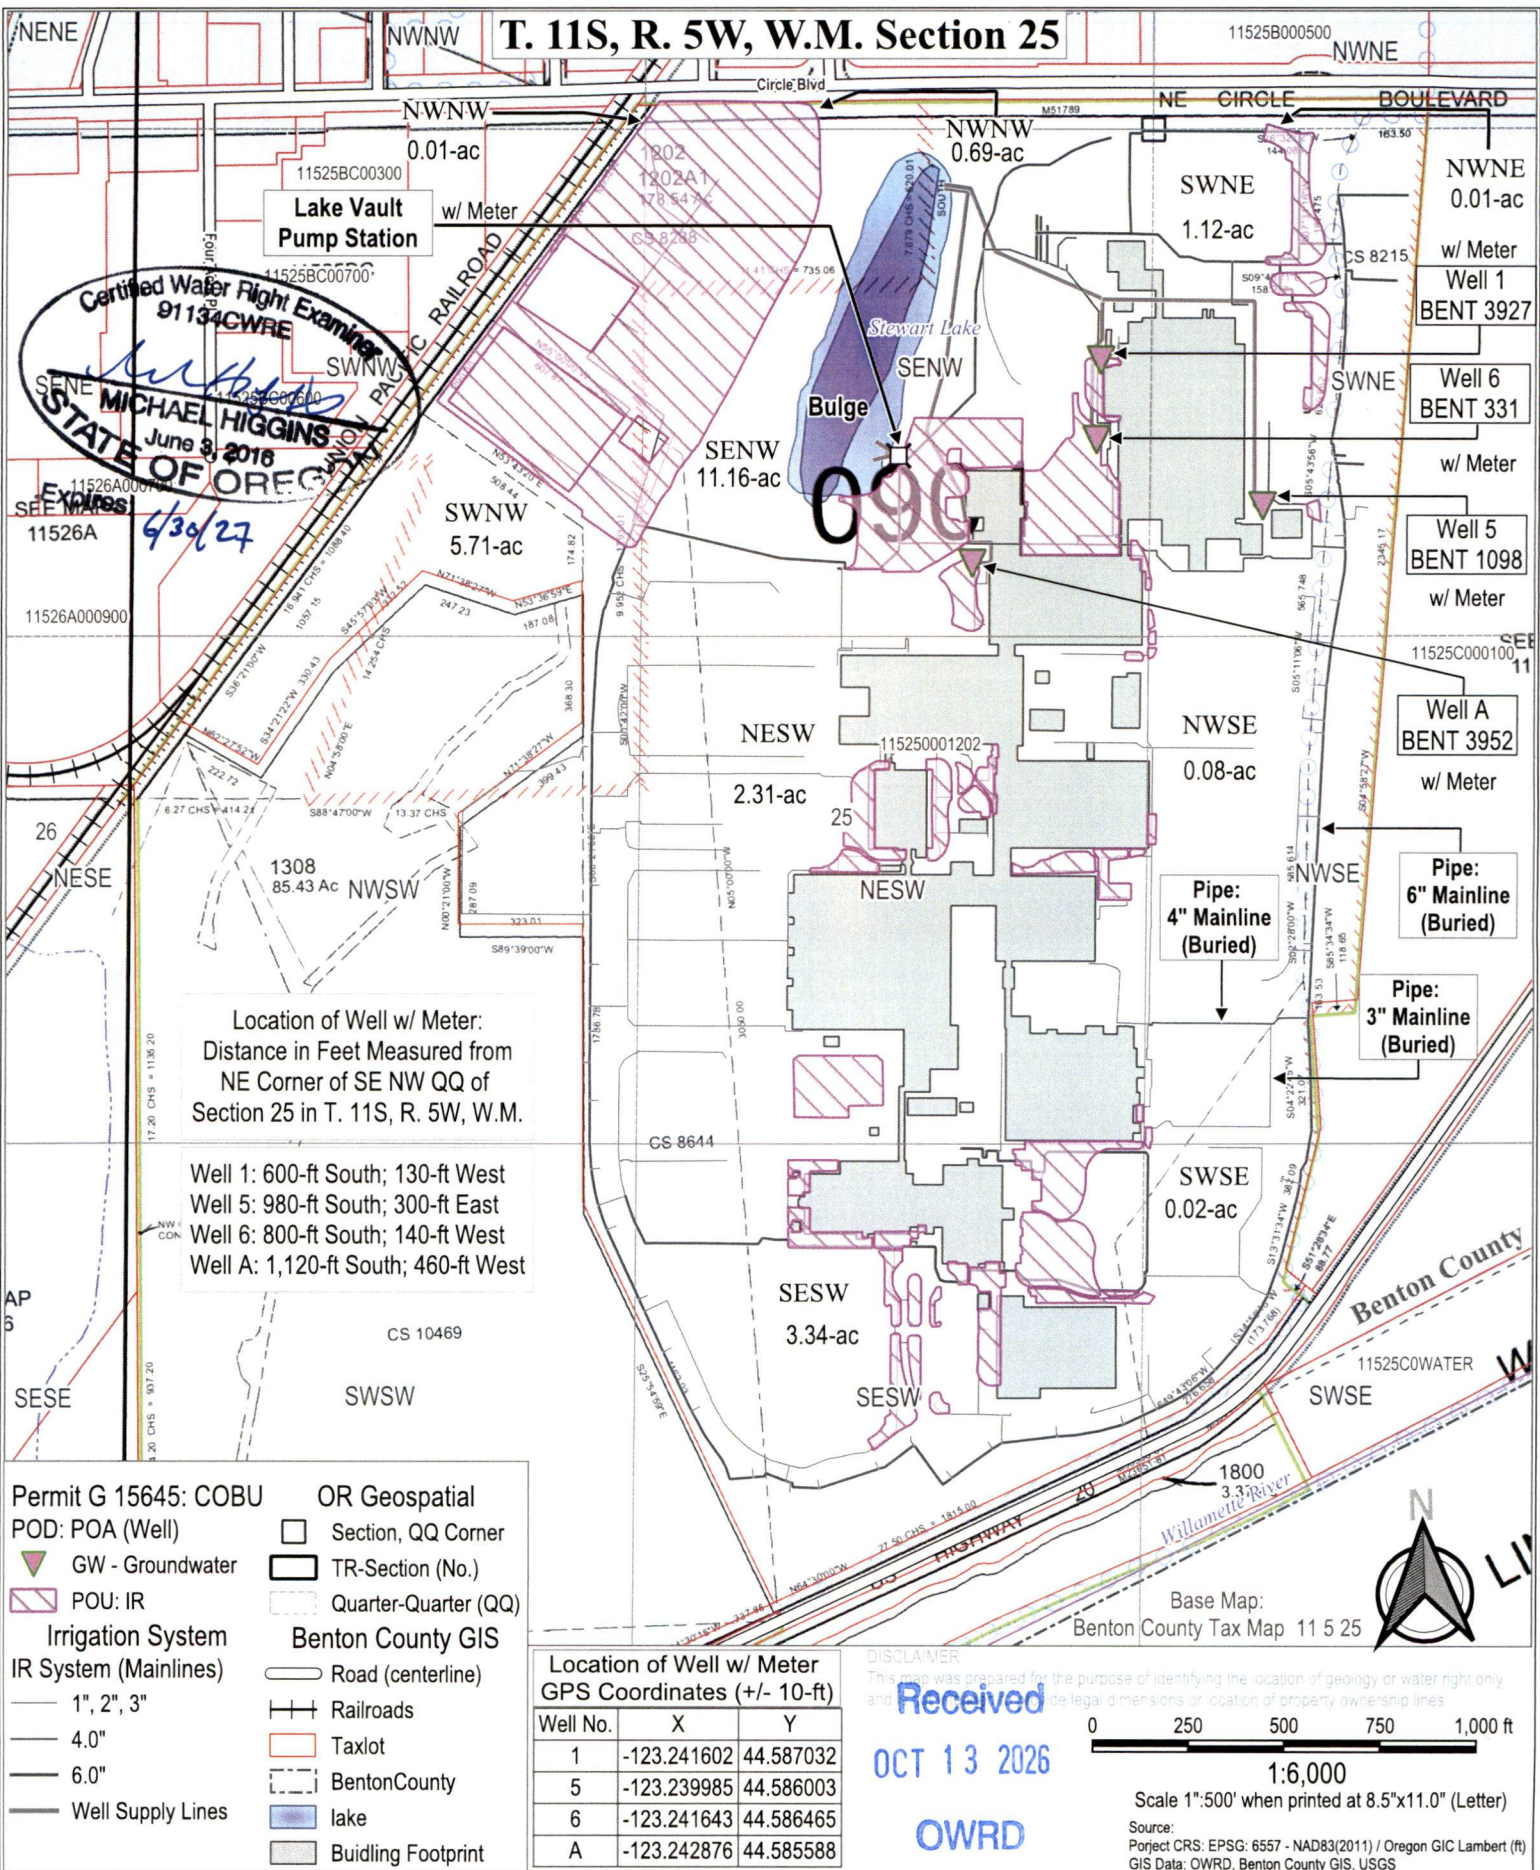

HGX Solutions, LLC

Prepared By: Michael Higgins, CWRE

Date: September 16, 2026


FINAL PROOF SURVEY, CLAIM OF BENEFICIAL USE

Under Application: G 15824; Permit: G 15645

In the Name of HP Inc.

Map Taxlot: 11 5 25 01202 in Benton County, OR

T. 11S, R. 5W, W.M. Section 25

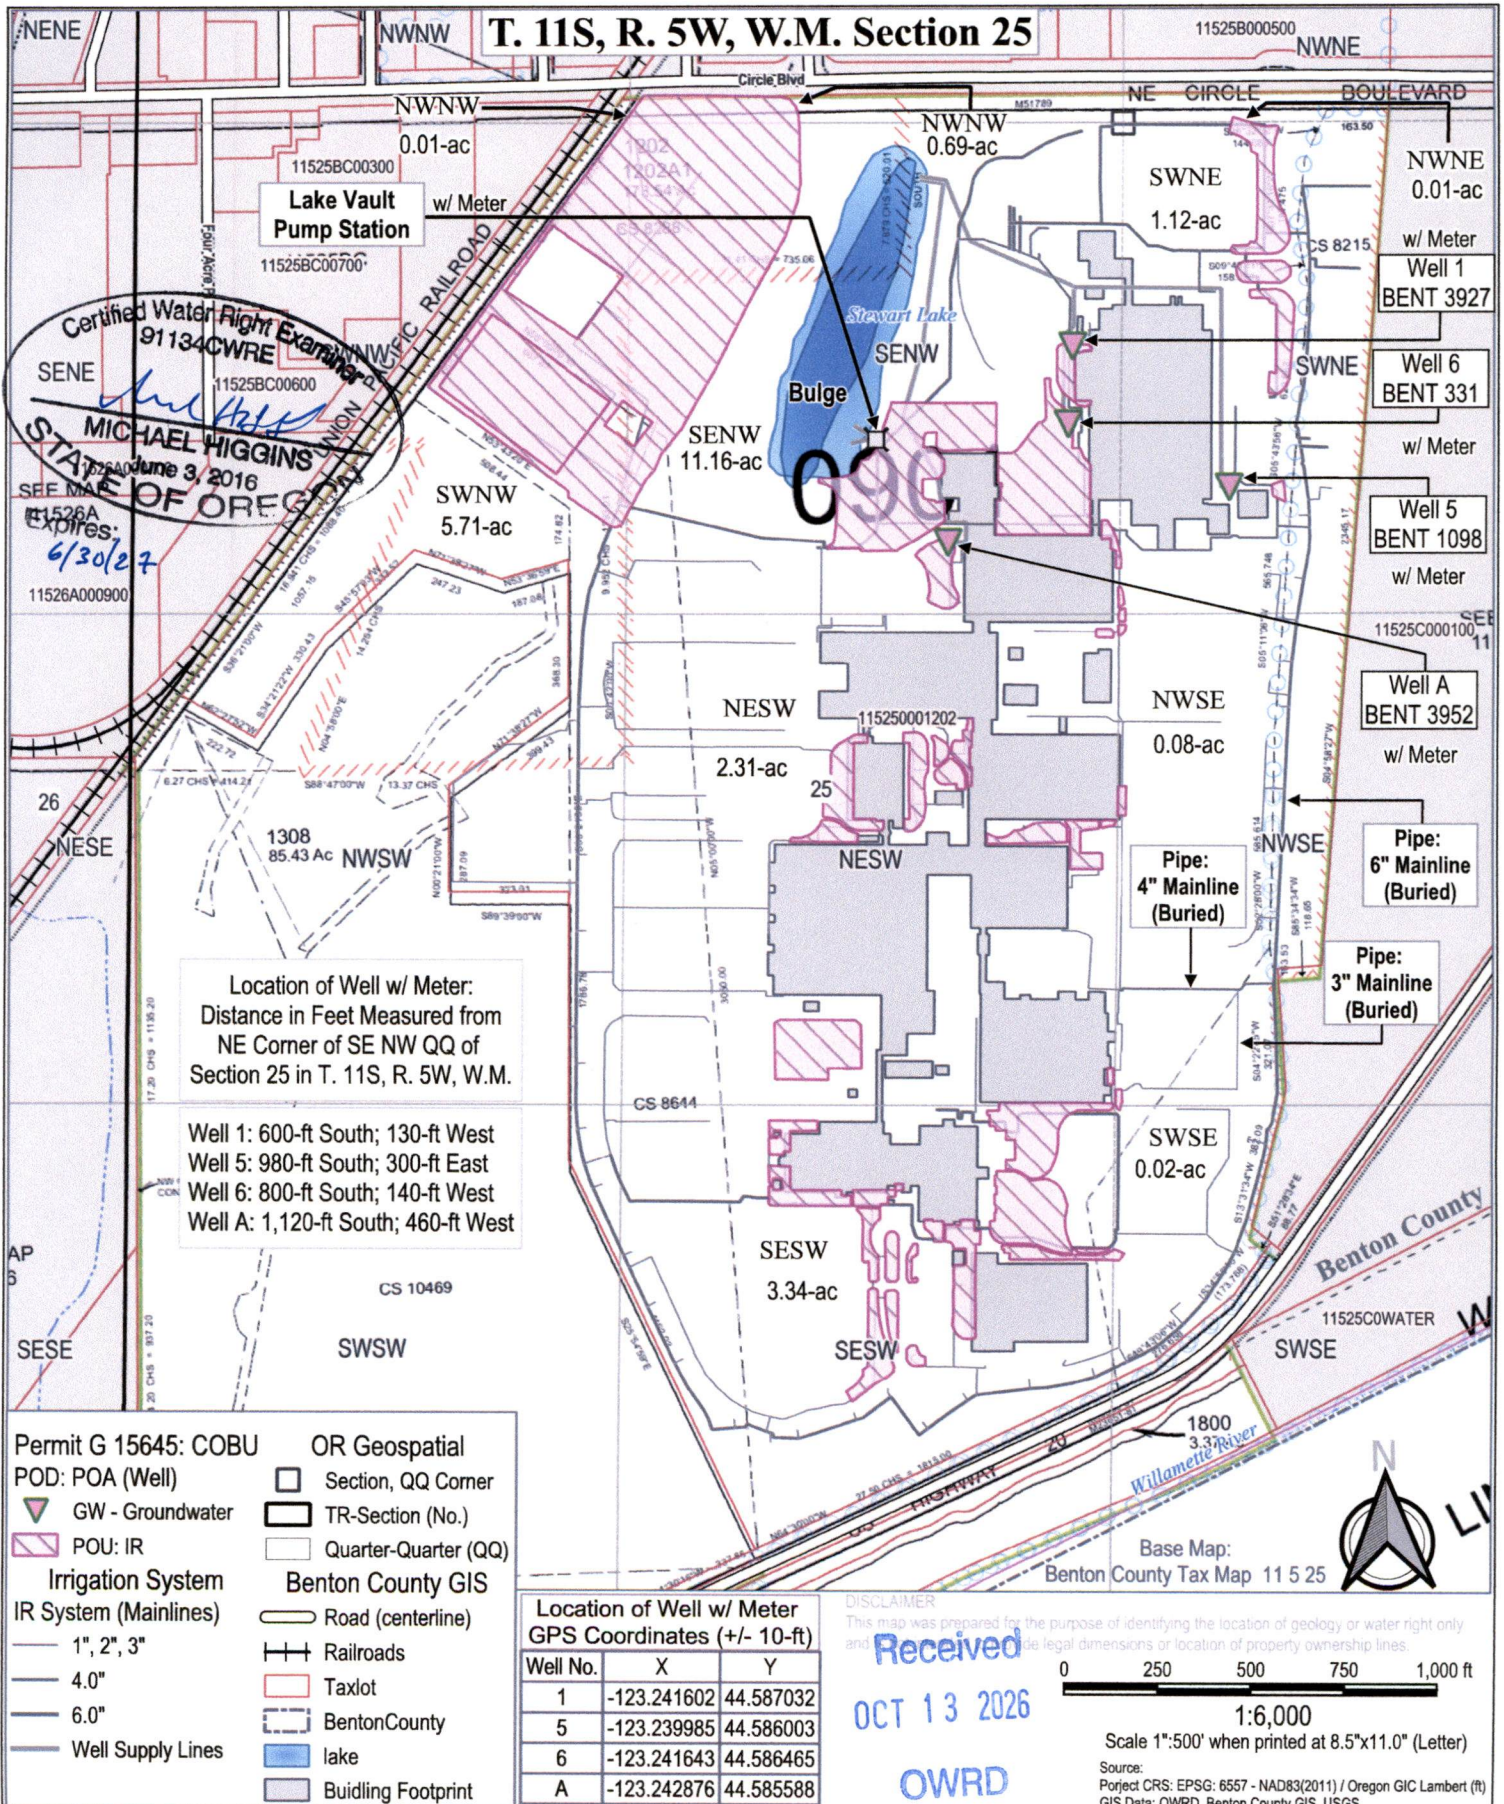

HGX Solutions, LLC

Prepared By: Michael Higgins, CWRE

Date: September 16, 2026

FINAL PROOF SURVEY, CLAIM OF BENEFICIAL USE

Under Application: G 15824; Permit: G 15645

In the Name of HP Inc.

Map Taxlot: 11 5 25 01202 in Benton County, OR

copy