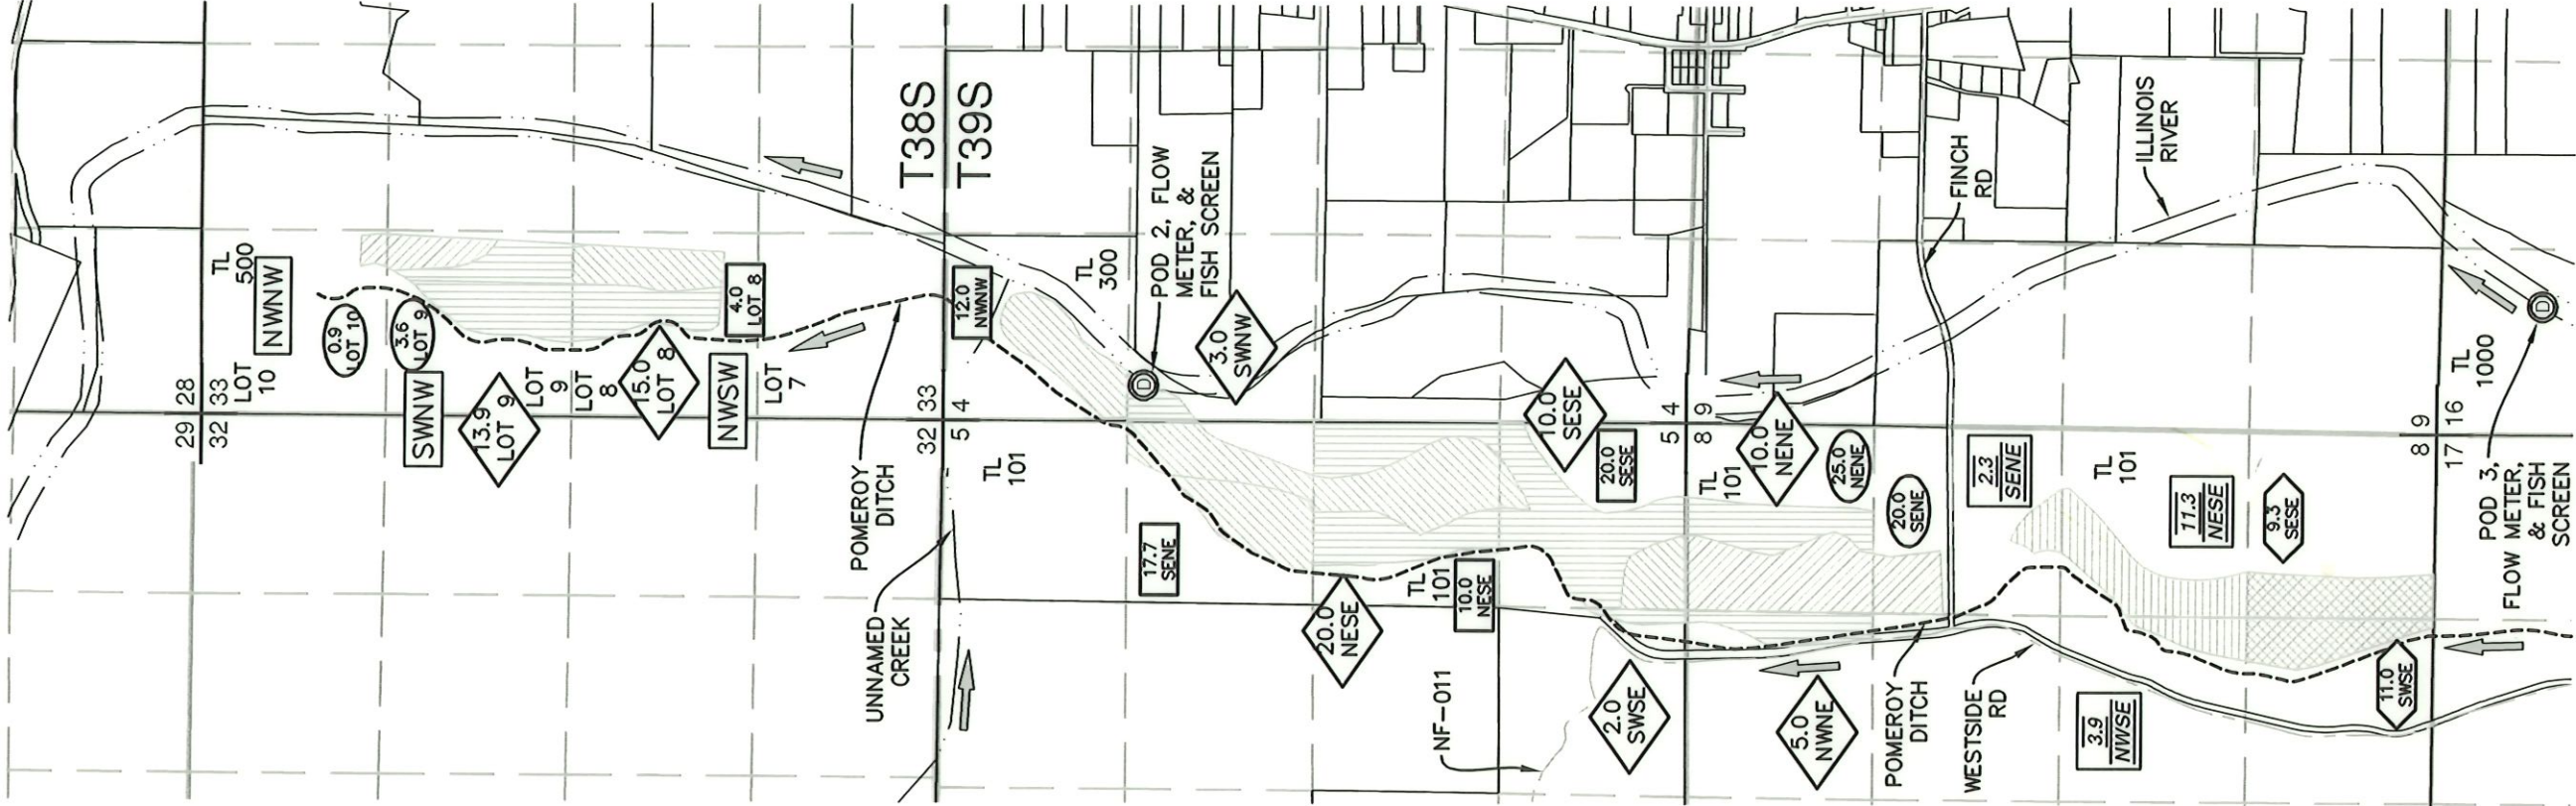


LEGEND

	TOWNSHIP LINE
	SECTION LINE
	1/4 1/4 LINE
	TAX LOT LINE
	RIVER
	DITCH LINE
	ROAD
	FLOW DIRECTION
	SECTION CORNER
	TAX LOT NUMBER
	GOVERNMENT LOT NUMBER
	POD
	TRANSFER T-14209 PRIMARY IRRIGATION TRANSFERRED TO PODS 2 & 3 (PRIORITY DATE 10/1/1898)
	TRANSFER T-14209 SUPPLEMENTAL IRRIGATION TRANSFERRED TO PODS 2 & 3 (PRIORITY DATE 10/1/1898)
	TRANSFER T-14209 PRIMARY IRRIGATION TRANSFERRED TO POD 3 (PRIORITY DATE 9/28/1917)
	TRANSFER T-14209 PRIMARY IRRIGATION TRANSFERRED TO PODS 2 & 3 (PRIORITY DATE 11/20/1953)
	TRANSFER T-14209 PRIMARY IRRIGATION TRANSFERRED TO POD 3 (PRIORITY DATE 11/20/1953)
	PROJECTED 1/4 1/4 WITHIN GOVERNMENT LOT

NOTES:

1. THIS MAP WAS PREPARED FROM FIELD MEASUREMENTS, NAIP 2025 AERIAL PHOTOGRAPHY, JOSEPHINE COUNTY TAX MAPS, AND OREGON GLO MAPS.
2. THE PURPOSE OF THIS MAP IS TO IDENTIFY THE LOCATION OF THE WATER RIGHT ONLY, AND IS NOT INTENDED TO PROVIDE DIMENSIONS OR LOCATION OF PROPERTY LINES.

POD LOCATIONS:

- POD 2: 1440' SOUTH & 250' EAST FROM THE NORTHWEST CORNER OF SECTION 4.
- POD 3: 750' SOUTH & 910' EAST FROM THE NORTHWEST CORNER OF SECTION 16.


AL ADKINS
ENGINEERING & SURVEYING
1435 ESPLANADE AVENUE, KLAMATH FALLS, OR 97601
o / 541.884.4666
w / AdkinsEngineering.com

SERVING S. OREGON & N. CALIFORNIA

ENGINEERING • SURVEYING • PLANNING • TESTING

7/30/2025

4061-01

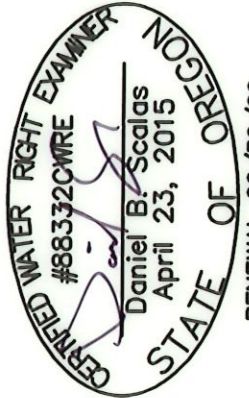

RENEWAL 06/30/26

CLAIM OF BENEFICIAL USE MAP

FOR
Q BAR X RANCH
T38S, R8W, WM; T39S, R8W, WM
JOSEPHINE COUNTY, OREGON
TRANSFER T-14209

Received
AUG 18 2025
OWRD

COBU MAP # 2194