


OCT 16 2026

Salem, OR

T.2S. R.1W. Section 35, W.M.

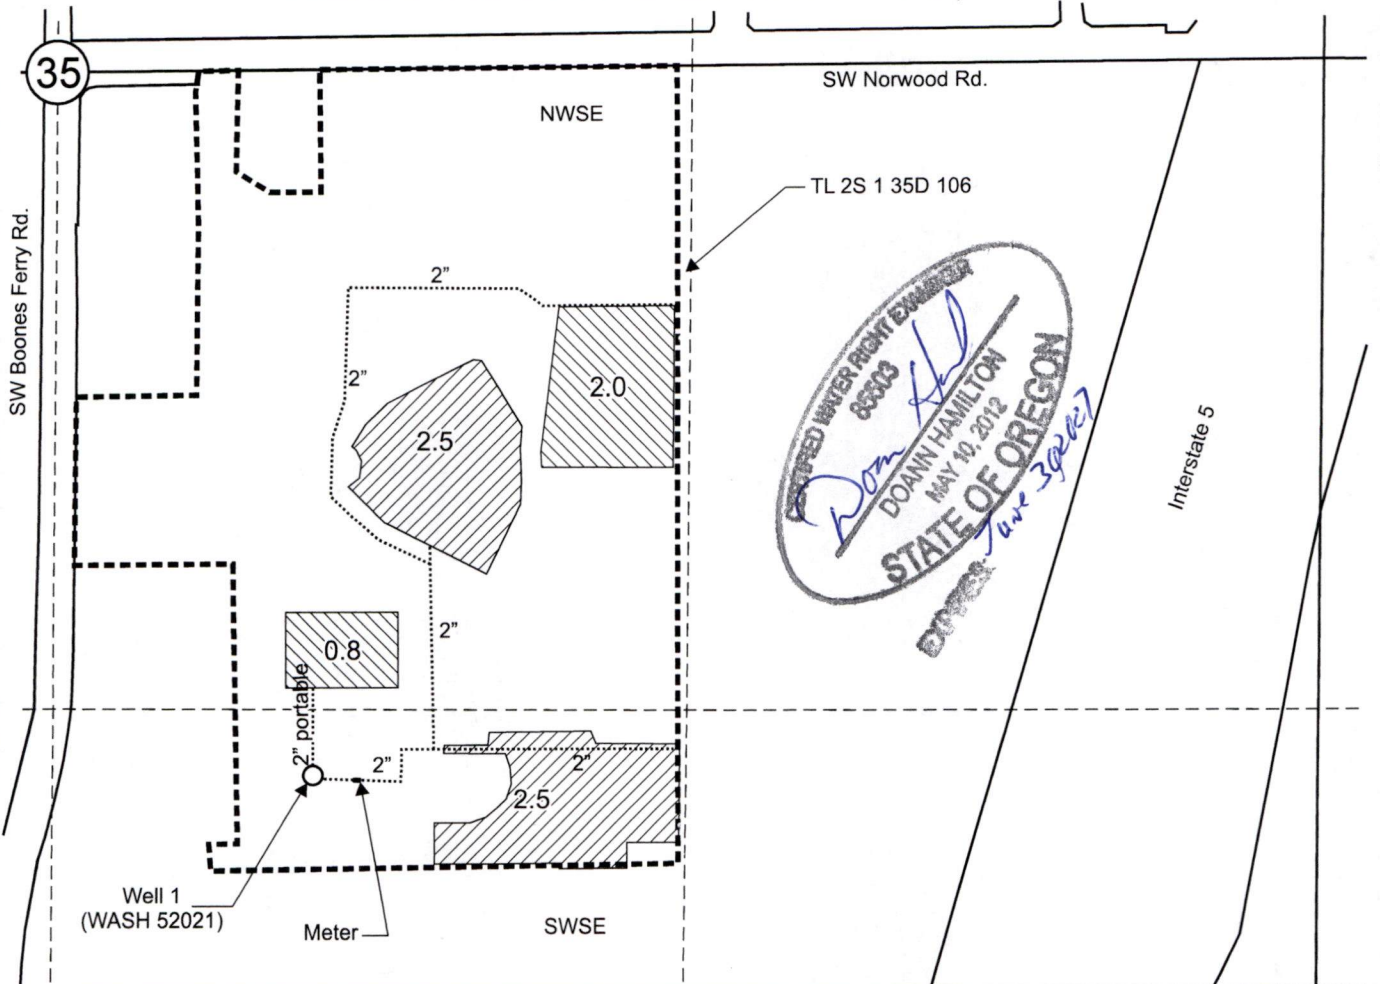

Well 1 (WASH 52021) is located 1,170 feet north and 2,075 feet west from the SE corner, Section. 35. (45.34971118, -122.77261488, WGS 84)


-  Area (2.8 acres) irrigated under T-14454, formerly Certificate 95051, priority date: 8-14-1961.
-  Area (5.0 acres) irrigated under T-14454, formerly was Certificate 95052, priority date: 9-3-1980.

SW Greenhill Ln.

Township 2S 35 36
Township 3S 2 1

- Tax lot boundary
- Irrigation mainlines

Scale: 1" = 400'

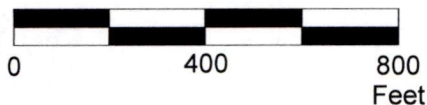

This map was prepared for the purpose of identifying the location of a water right only and is not intended to provide legal dimensions or location of property ownership lines.

Claim of Beneficial Use Map
T-14454 former Certificate 95051 and 95052

Horizon Community Church
T.2S. R.1W. Section 35, W.M.

 WILL MCGILL SURVEYING LLC

10/2026