
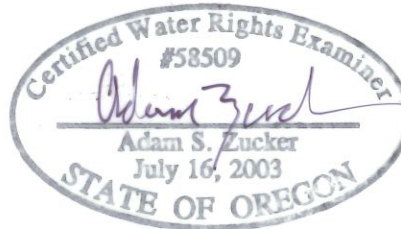


Section 28, T1N, R1W, W.M.  
Washington County, Oregon

CLAIM OF BENEFICIAL USE MAP  
for Permit R-14132, Application R-85677  
Hartung Farms Homeowner Association  
Hartung Farms No. 5 Homeowner Association

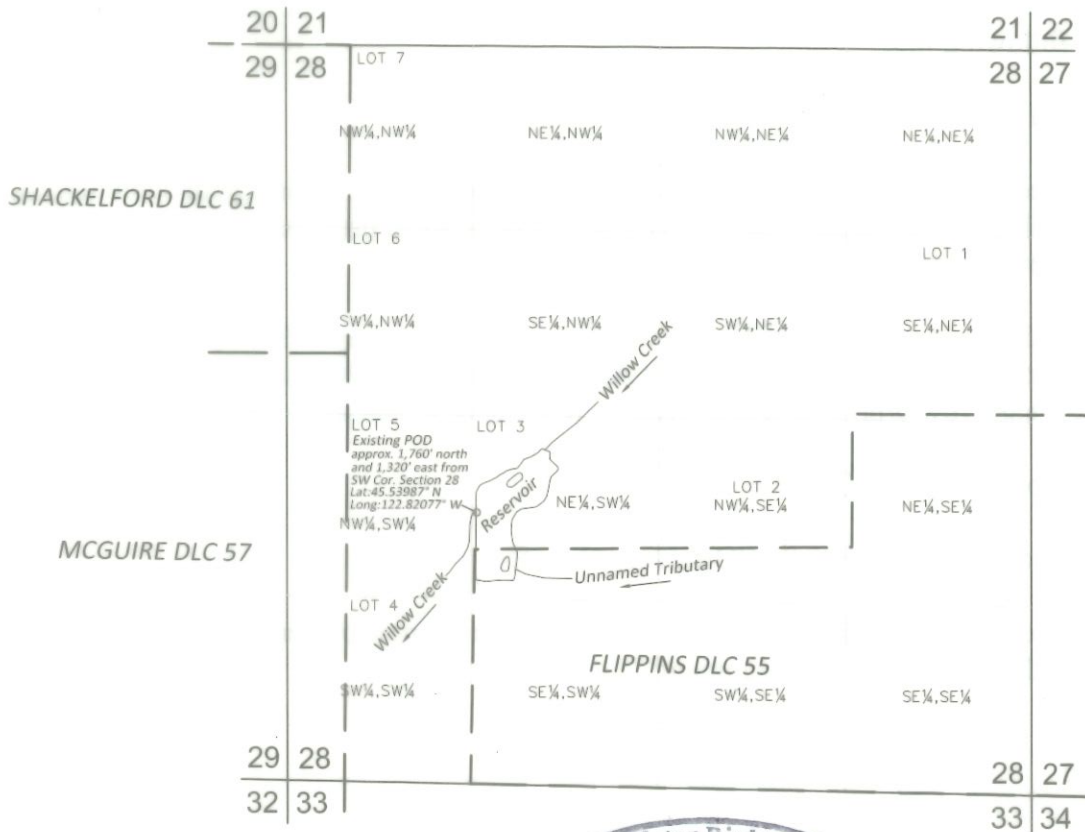


Expiration Date: 6-30-2028

This map is not intended to provide legal dimensions of locations of property ownership lines.



4014 SE Ankeny Street • Portland, Oregon 97214  
ph: 503-956-3473 • adam@zuckerengineering.com

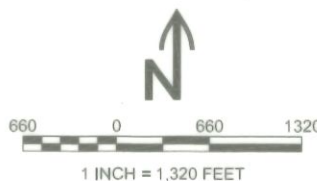

September 2026

Received  
OCT 19 2026  
OWRD