CLAIM OF BENEFICIAL USE MAP

TO ADD PLACE OF USE AND A POINT OF APPROPRIATION PER APPLICATION G-17424 FOR HARNEY ELECTRIC COOPERATIVE

SECTION 23, TOWNSHIP 23 SOUTH, RANGE 30 EAST, W.M.
TAX LOT: 5400 MAP 23S30E23DD

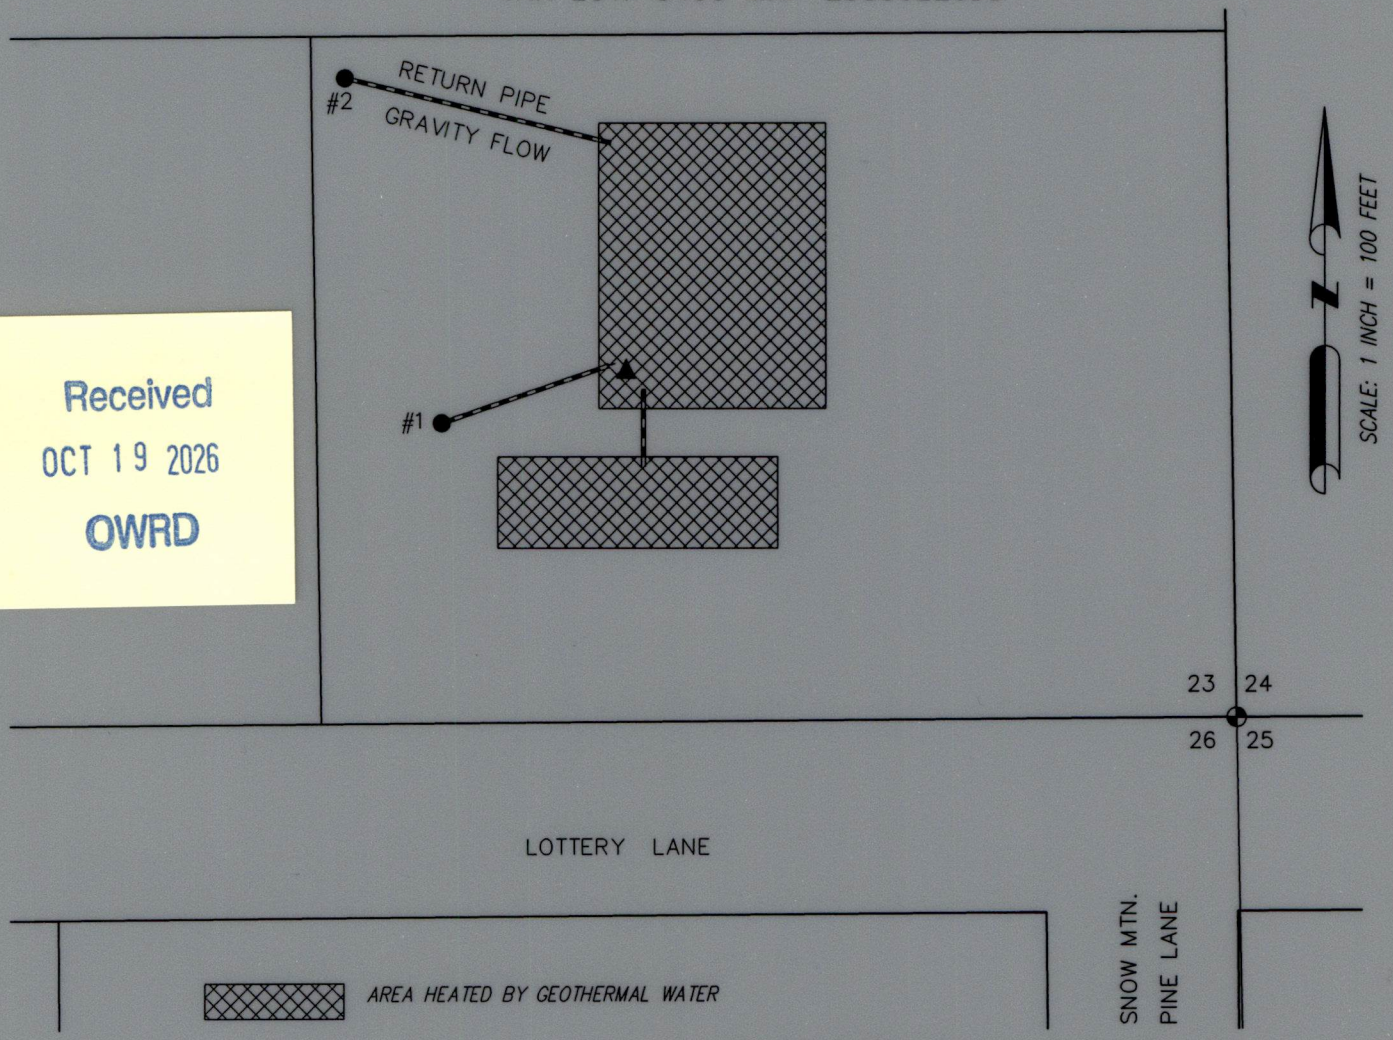

Received
OCT 19 2026
OWRD

Certified Water Right Examiner
#51324 WRE
Scott D. Montgomery
May 21, 2001
STATE OF OREGON

RENEWAL DATE: 12/31/2026

● *#1 SUPPLY WELL (HARN 51699) 43.55663° -119.08109°*
LOCATED 155 FEET NORTH AND 411 FEET WEST FROM THE CORNER COMMON TO SECTIONS 23, 24, 25, AND 26.

▲ *FLOW METER IS LOCATIED INSIDE BLDG IN MONITORING ROOM. 43.55671° -119.08087°*

● *#2 RETURN WELL (HARN 51698) 43.55716° -119.08133°*
LOCATED 340 FEET NORTH AND 460 FEET WEST FROM THE CORNER COMMON TO SECTIONS 23, 24, 25, AND 26.

THIS MAP IS FOR THE PURPOSE OF LOCATING A WATER RIGHT ONLY AND HAS NO INTENT TO PROVIDE LEGAL DIMENSIONS OR THE LOCATION OF PROPERTY LINES.

PREPARED FOR:

HARNEY ELECTRIC COOPERATIVE
P.O. BOX 587
HINES, OR 97738

PREPARED BY:



ALL POINTS ENGINEERING AND SURVEYING, INC.
P.O. BOX 767 TERREBONNE, OR 97760
(541) 548-5833 www.APEandS.com