

OCT 21 2026

T.4S. R.2E. Section 28, W.M.

Salem, OR


20 21
29 28

Lot 1

NWNW

NENW

S. Union Mills Rd.

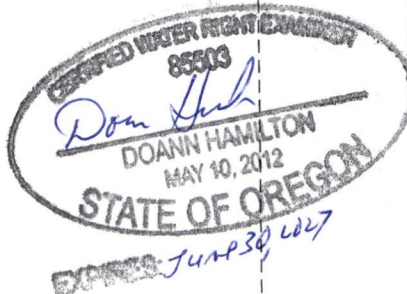


River Bend Reservoir

POD 1 is located 1,220 feet south and 990 feet east from the NW corner, Section 28.
(45.198222, -122.5753, WGS 84)

POD 2 is located 1,940 feet south and 1,120 feet east from the NW corner, Section 28.
(45.196222, -122.574761, WGS 84)

Center of reservoir is located 1,125 feet south and 1,125 feet east from the NW corner, Section 28.
(45.198489, -122.574825, WGS 84)

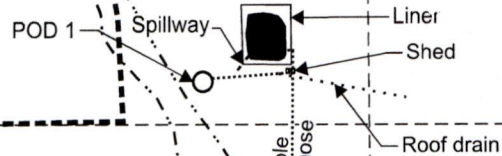

River Bend Reservoir Area
(0.125 Acres inundated)
under Application R-89116,
Permit R-15673, PA T-14610


--- Tax lot boundary

--- Donation Land Claim boundary

..... Water main line

TL 4 2E 28 402

Scale: 1" = 400'

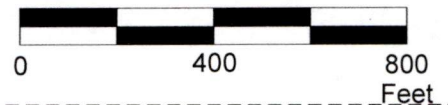Wright
DLC 38

Lot 2

Lot 3

Molalla River

Lot 4

SWNW

SENW

NWSW

NESW

This map was prepared for the purpose of
identifying the location of a water right only
and is not intended to provide legal dimensions
or location of property ownership lines.

Claim of Beneficial Use Map
Application R-89116, Permit R-15673, PA T-14610

Terry and Annemarie Obrist
T.4S. R.2E. Section 28, W.M.

WILL MCGILL SURVEYING LLC

10/2026