


CLAIM OF BENEFICIAL USE MAP


TO ADD POINTS OF APPROPRIATION
PER T-14191

FOR GOLDEN RULE FARMS, INC.

TOWNSHIP 26 SOUTH, RANGE 30 EAST, SECTION 1, W.M.
TAX LOTS: 100 & 200

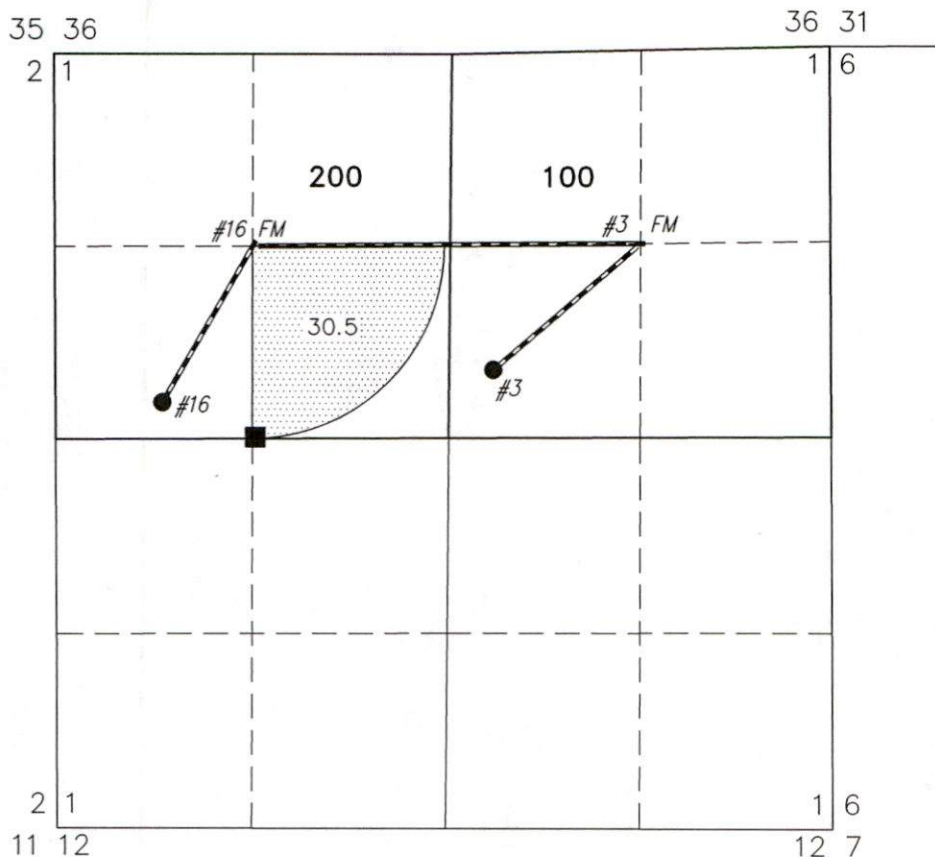

30.5 ACRES IR REMAIN, AS
SHOWN PER T-14191.

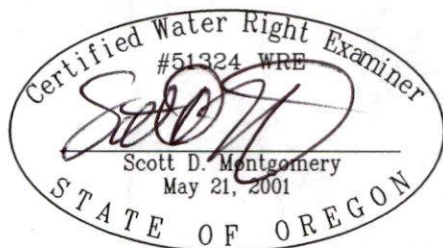

RENEWAL DATE: 12/31/2026

THIS MAP IS FOR THE PURPOSE OF LOCATING A WATER
RIGHT ONLY AND HAS NO INTENT TO PROVIDE LEGAL
DIMENSIONS OR THE LOCATION OF PROPERTY LINES.

- WELL 3 (HARN 50143) 43.34626° -119.05879°
LOCATED 2160 FEET SOUTH AND 2340 FEET WEST FROM THE
NE CORNER OF SECTION 1.
FLOW METER IS LOCATED 8' NW FROM CENTER PIVOT.
43.34921° -119.05403°
- WELL 16 (HARN 51555) 43.34709° -119.06793°
LOCATED 250 FEET NORTH AND 730 FEET EAST FROM
THE W 1/4 CORNER OF SECTION 1.
FLOW METER IS LOCATED 4' WEST FROM CENTER PIVOT.
43.34918° -119.06391°

Received
OCT 19 2026

OWRD

PREPARED FOR:

GOLDEN RULE FARMS, INC.
P.O. BOX 255
CHRISTMAS VALLEY, OR 97641

PREPARED BY:



ALL POINTS ENGINEERING AND SURVEYING, INC.
P.O. BOX 767 TERREBONNE, OR 97760
(541) 548-5833
www.APEandS.com