


T.6S. R.3W. Section 1, W.M.

OCT 21 2026

Salem, OR

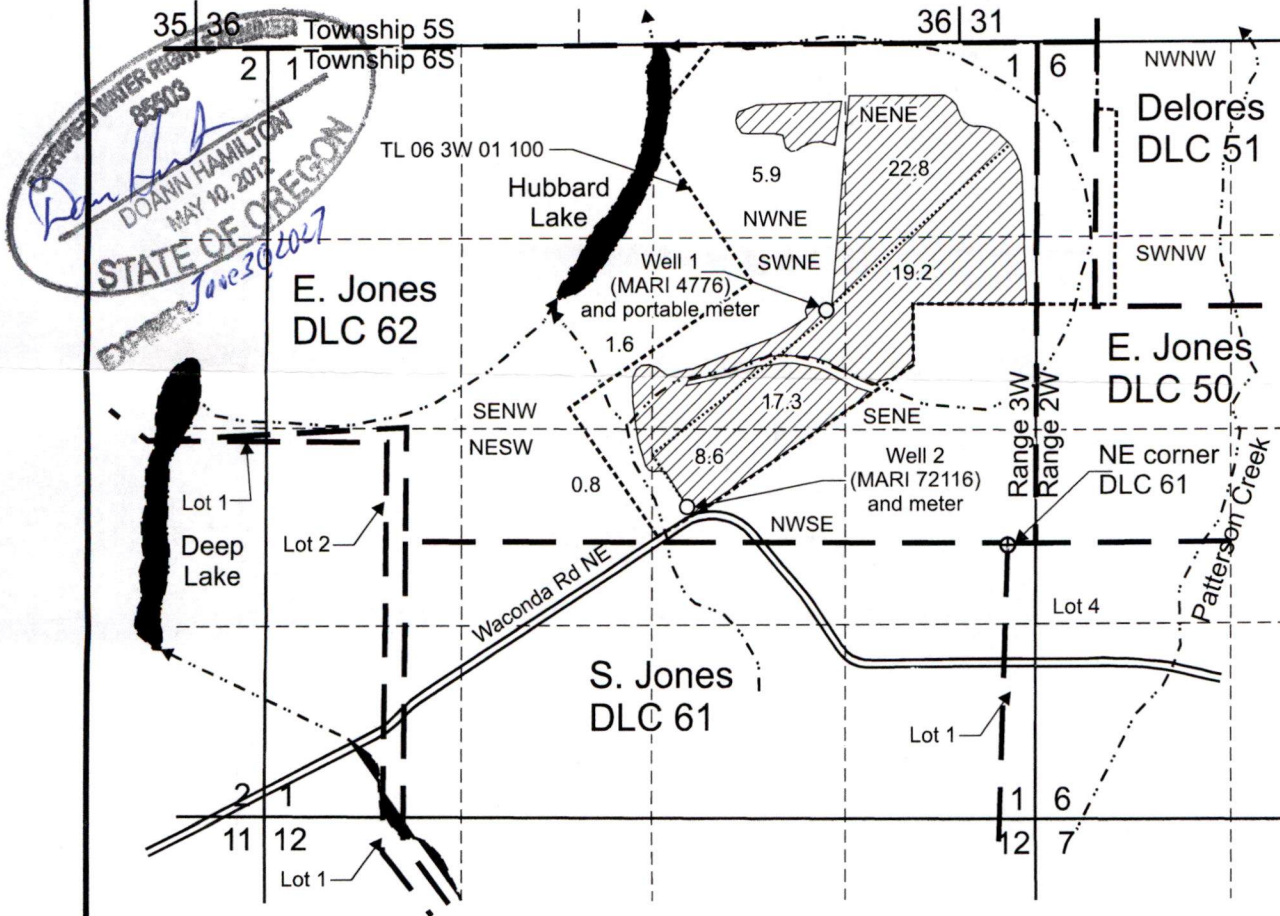

Well 1 (MARI 4776) is located 1,590 feet north and 1,250 feet west from the NE corner, DLC 61.
(45.0811400, -122.9947300, WGS 84)

Well 2 (MARI 72116) is located 270 feet north and 2,210 feet west from the NE corner, DLC 61.
(45.077372, -122.998347, WGS 84)


 Area (76.2 Acres) irrigated under T-14522, formerly Certificate 34795, priority date: 4-3-1964.

 Tax lot boundary

 Donation Land Claim boundary

 Water main line, are portable, estimated location.

Scale: 1" = 1,320'

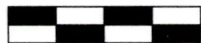

0 1,320
Feet

This map was prepared for the purpose of identifying the location of a water right only and is not intended to provide legal dimensions or location of property ownership lines.

Claim of Beneficial Use Map
T-14522, formerly Certificate 34795

ED Landholdings LLC
T.6S, R.3W. Section 1, W.M.

 WILL MCGILL SURVEYING LLC

10/2026