


CLAIM OF BENEFICIAL USE MAP

SECTION 13, TOWNSHIP 21 SOUTH, RANGE 20 EAST, WILLAMETTE MERIDIAN, DESCHUTES COUNTY, OREGON,
SECTION 18, TOWNSHIP 21 SOUTH, RANGE 21 EAST, WILLAMETTE MERIDIAN, CROOK COUNTY, OREGON.
APP.# R-83756 PERMIT# R-12756

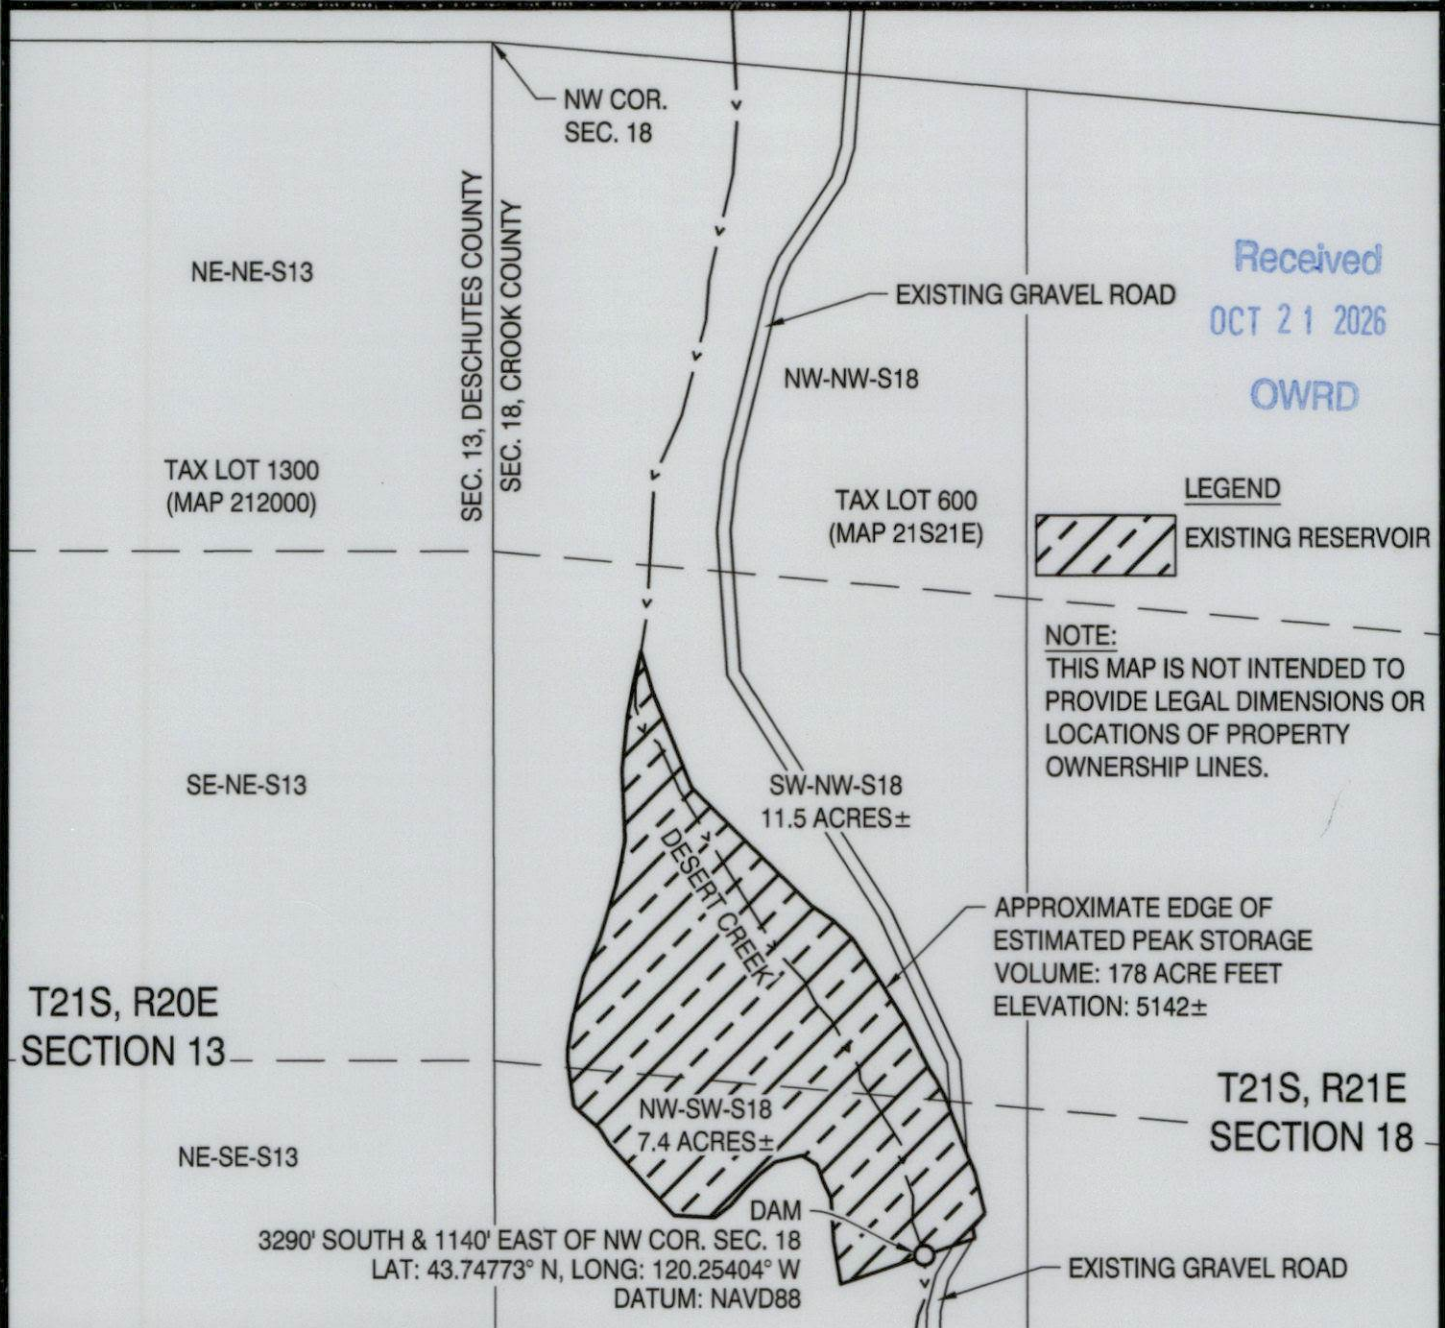

H.A. McCOY
ENGINEERING & SURVEYING LLC

1180 SW LAKE ROAD SUITE 201
REDMOND, OR 97756
(541) 923-7554

SCALE: 1" = 500'
FOR 8.5"x11" SHEETS
0 250' 500'



PROJECT: DESERT CREEK RESERVOIR

DRAWN BY: JJW DATE: 10/15/2026 PAGE 1 OF 1 PROJECT#: 22-082