T. 5 S., R .6 W., W.M.

FINAL PROOF SURVEY

UNDER
Application G-15649
Permit G-15216

IN NAME OF
DELPHIAN SCHOOL

Surveyed November 12, 2024

Location:
The SE 1/4 SECTION 20, NW 1/4 SECTION 28, NE 1/4 & SE 1/4 SECTION 29, T. 5 S., R. 6 W., YAMHILL COUNTY, OR

Tax Lot: 5629 - 100

Date: 28 Sept. 2026


POINT OF DIVERSION TABLE:

WELL #	*LOCATION*
WELL #2	735' S. & 2257' E. NW COR. SEC. 28 45.11356° N, -123.43424° W
WELL #14	949' S. & 490' W. N 1/16TH COR. SEC. 28/29 45.10924° N, -123.44466° W
WELL #17	1385' S. & 205' W. N 1/16TH COR. SEC. 28/29 45.10805° N, -123.44354° W
WELL #20	1888' S. & 252' E. NW COR. SEC. 28 45.11031° N, -123.44188° W
WELL #21	653' S. & 2232' E. NW COR. SEC. 28 45.11387° N, -123.43429° W

North

Scale: 1" = 1320'

0 1320 2640

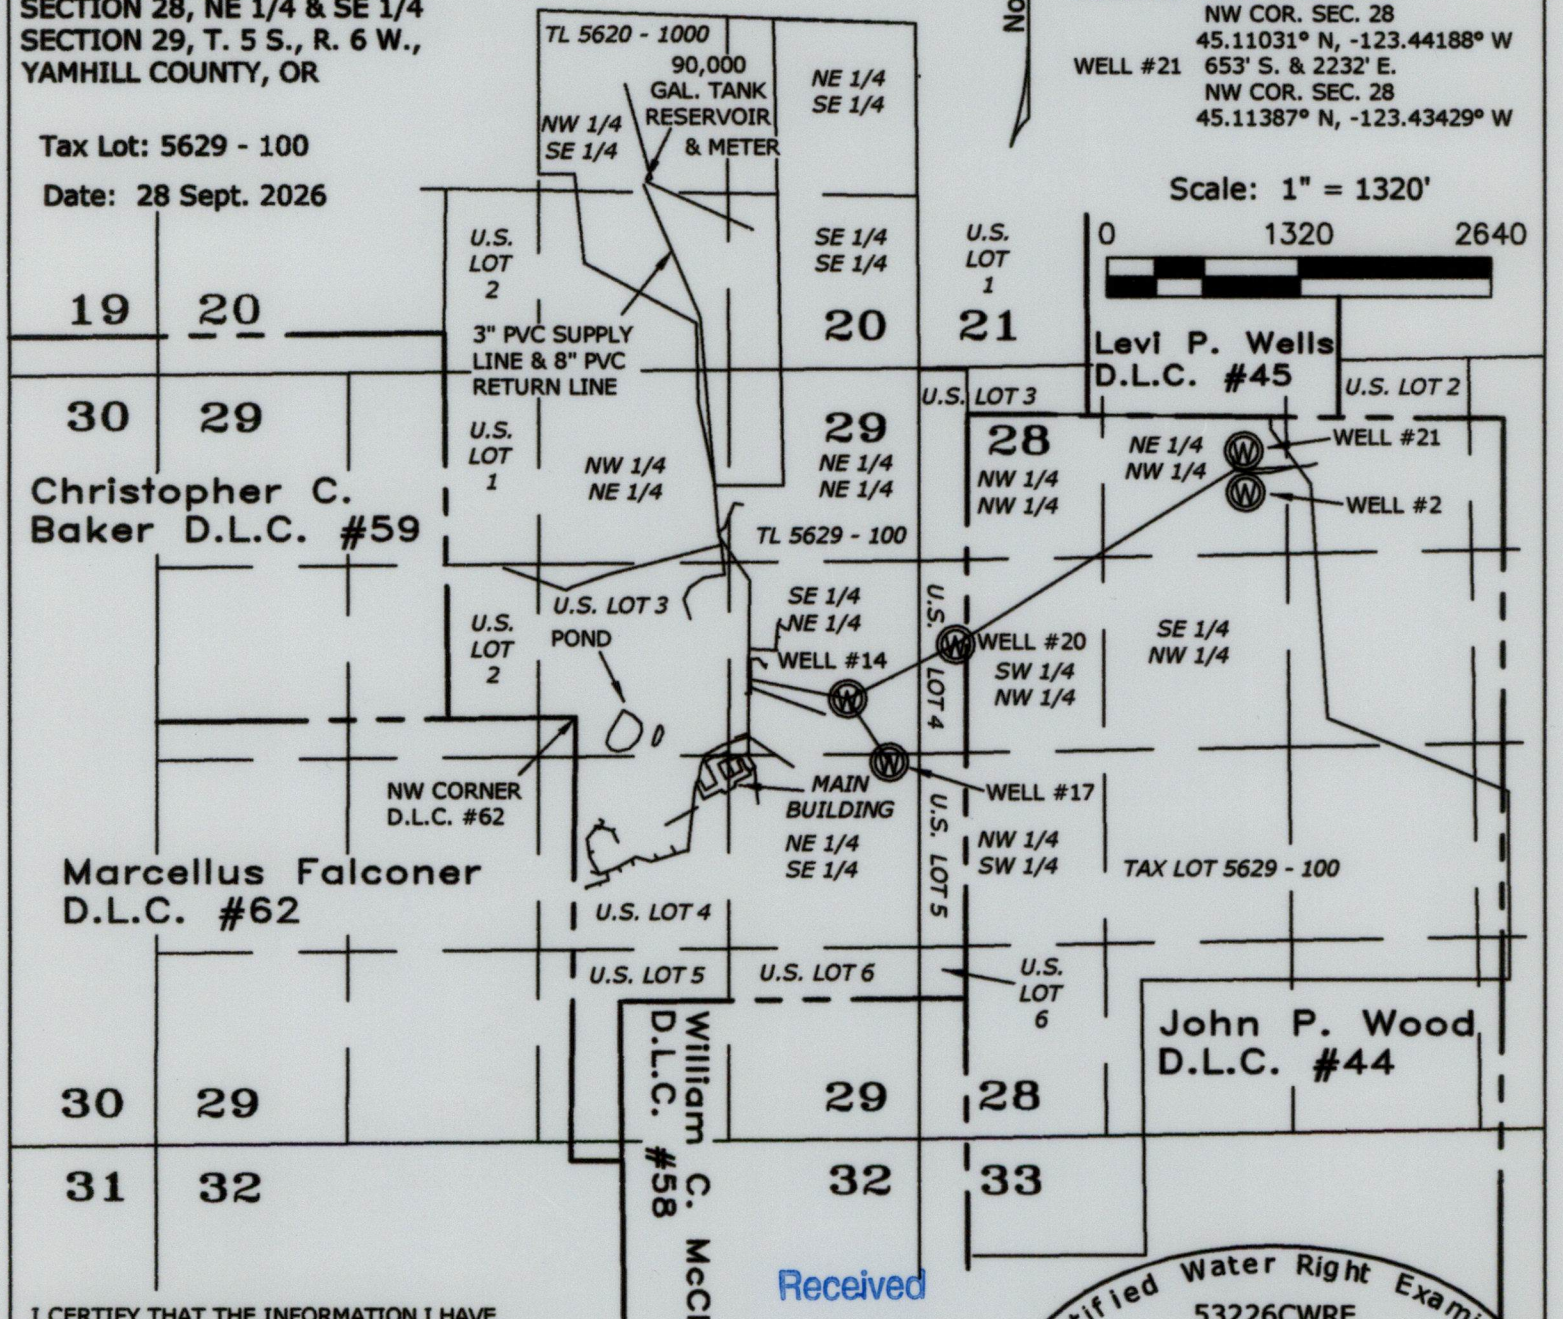

I CERTIFY THAT THE INFORMATION I HAVE PROVIDED IN THIS FINAL PROOF SURVEY IS AN ACCURATE REPRESENTATION OF THE ACTUAL WATER USE AND IS TRUE AND CORRECT TO THE BEST OF MY KNOWLEDGE. THIS MAP IS TO BE USED FOR THE PURPOSE OF IDENTIFYING THE LOCATION OF WATER RIGHT ONLY AND IS NOT INTENDED TO PROVIDE LEGAL DIMENSIONS OR LOCATIONS OF PROPERTY OWNERSHIP LINES.

LELAND A. MACDONALD, 53226 CWRE

Received
OCT 26 2026
OWRD

Certified Water Right Examiner
53226CWRE
LELAND A. MACDONALD
JUNE 8, 2009
STATE OF OREGON

Leland MacDonald & Assoc., LLC
3765 Riverside Drive
McMinnville, Oregon 97128
Phone: 503-472-7904
Email:lee@macdonaldsurveying.com

RENEWS: 31 DECEMBER 2026

#9497