15333 Pletzer Rd. SE
Turner, Oregon 97392
(503) 931-0210 Phone

WILL MCGILL SURVEYING LLC

Memo

To: Oregon Water Resources Department / Nick Reece

From: Doann Hamilton, CWRE

CC:

Date: October 29, 2026

Re: Application R-89370.

On October 29, 2026 I received an email from the caseworker Nick Reece concerning the map submitted for a new reservoir ApplicationR-89370 for our client Lynnia Woods. Besides the location of the well, the center of the reservoir needed to be identified.

Corrections have been made to the maps listing the location of the center of Pelfry Pond. Attached is the corrected maps to reflect this change.

CERTIFIED WATER RIGHT EXAMINER
85603
DOANN HAMILTON
MAY 10, 2012
STATE OF OREGON
EXPIRES: JUNE 30, 2026

T.1N. R.3E. Section 28, W.M.

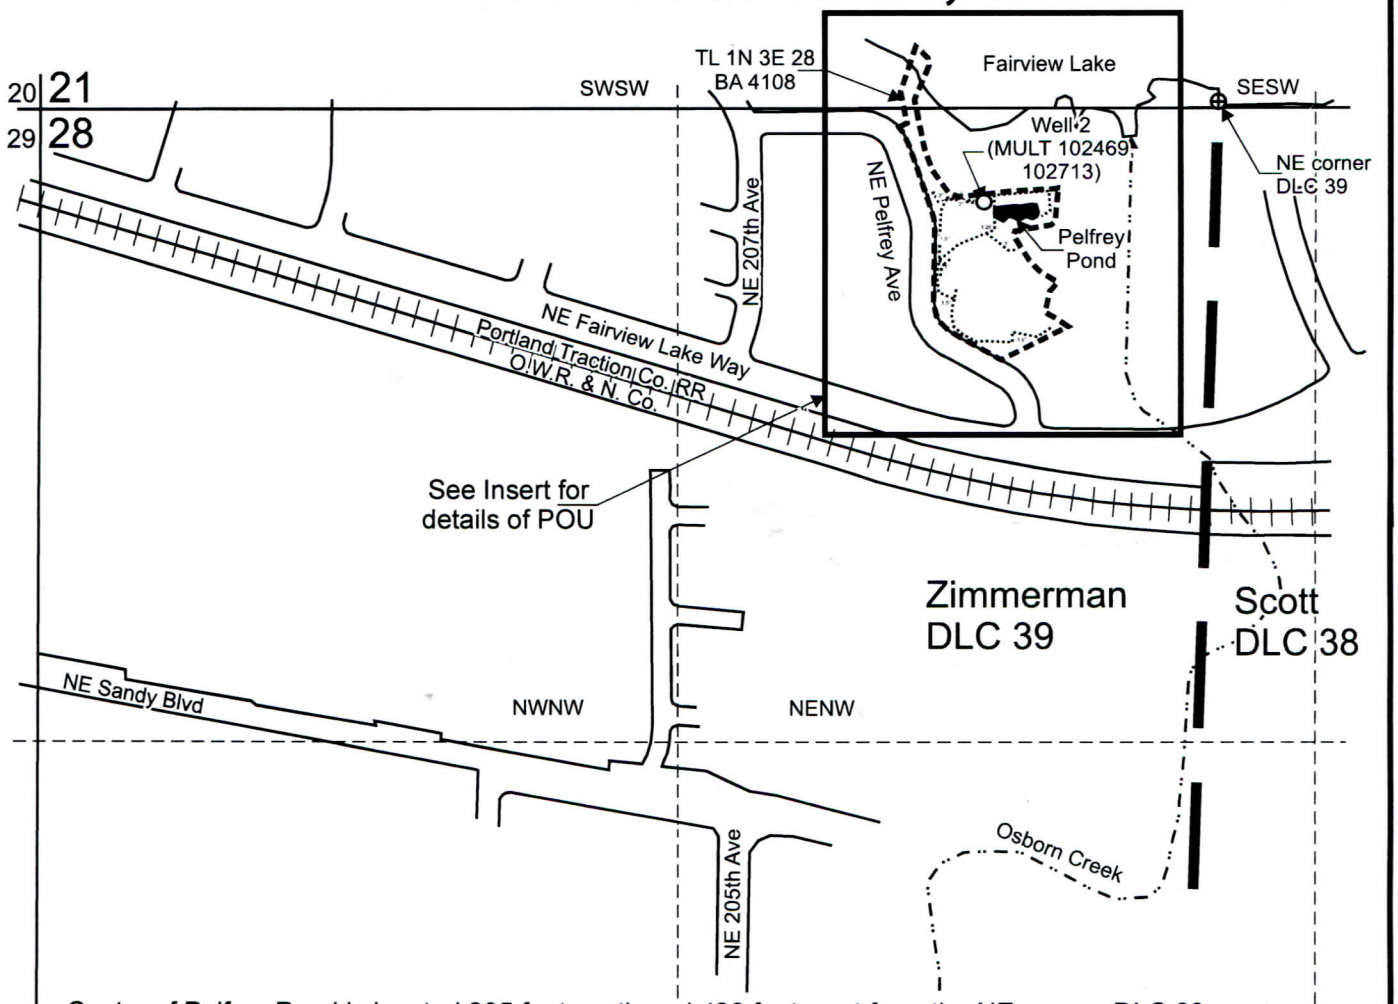

Center of Pelfrey Pond is located 235 feet south and 420 feet west from the NE corner, DLC 39.

Well 2 (MULT 102469, 102713) is located 220 feet south and 390 feet west from the NE corner, DLC 39

Area (0.07 Acres) to be submerged by Pelfrey Pond.

Tax lot boundary

Donation Land Claim boundary

Water main line

CERTIFIED WATER RIGHT EXAMINER
85503
DOANN HAMILTON
MAY 10, 2012
STATE OF OREGON
EXPIRES: June 30, 2026

Scale: 1" = 400'

0 400 800 Feet

This map was prepared for the purpose of identifying the location of a water right only and is not intended to provide legal dimensions or location of property ownership lines.

Reservoir Application Map

Pacific Hydro-Geology Inc.

05/2022
Rev 10/2026

Lynnia K. Woods or Lynnia K. Pelfrey
T.1N. R.3E. Section 28, W.M.

Woods ResAppMap.cdr

T.1N. R.3E. Section 28, W.M.

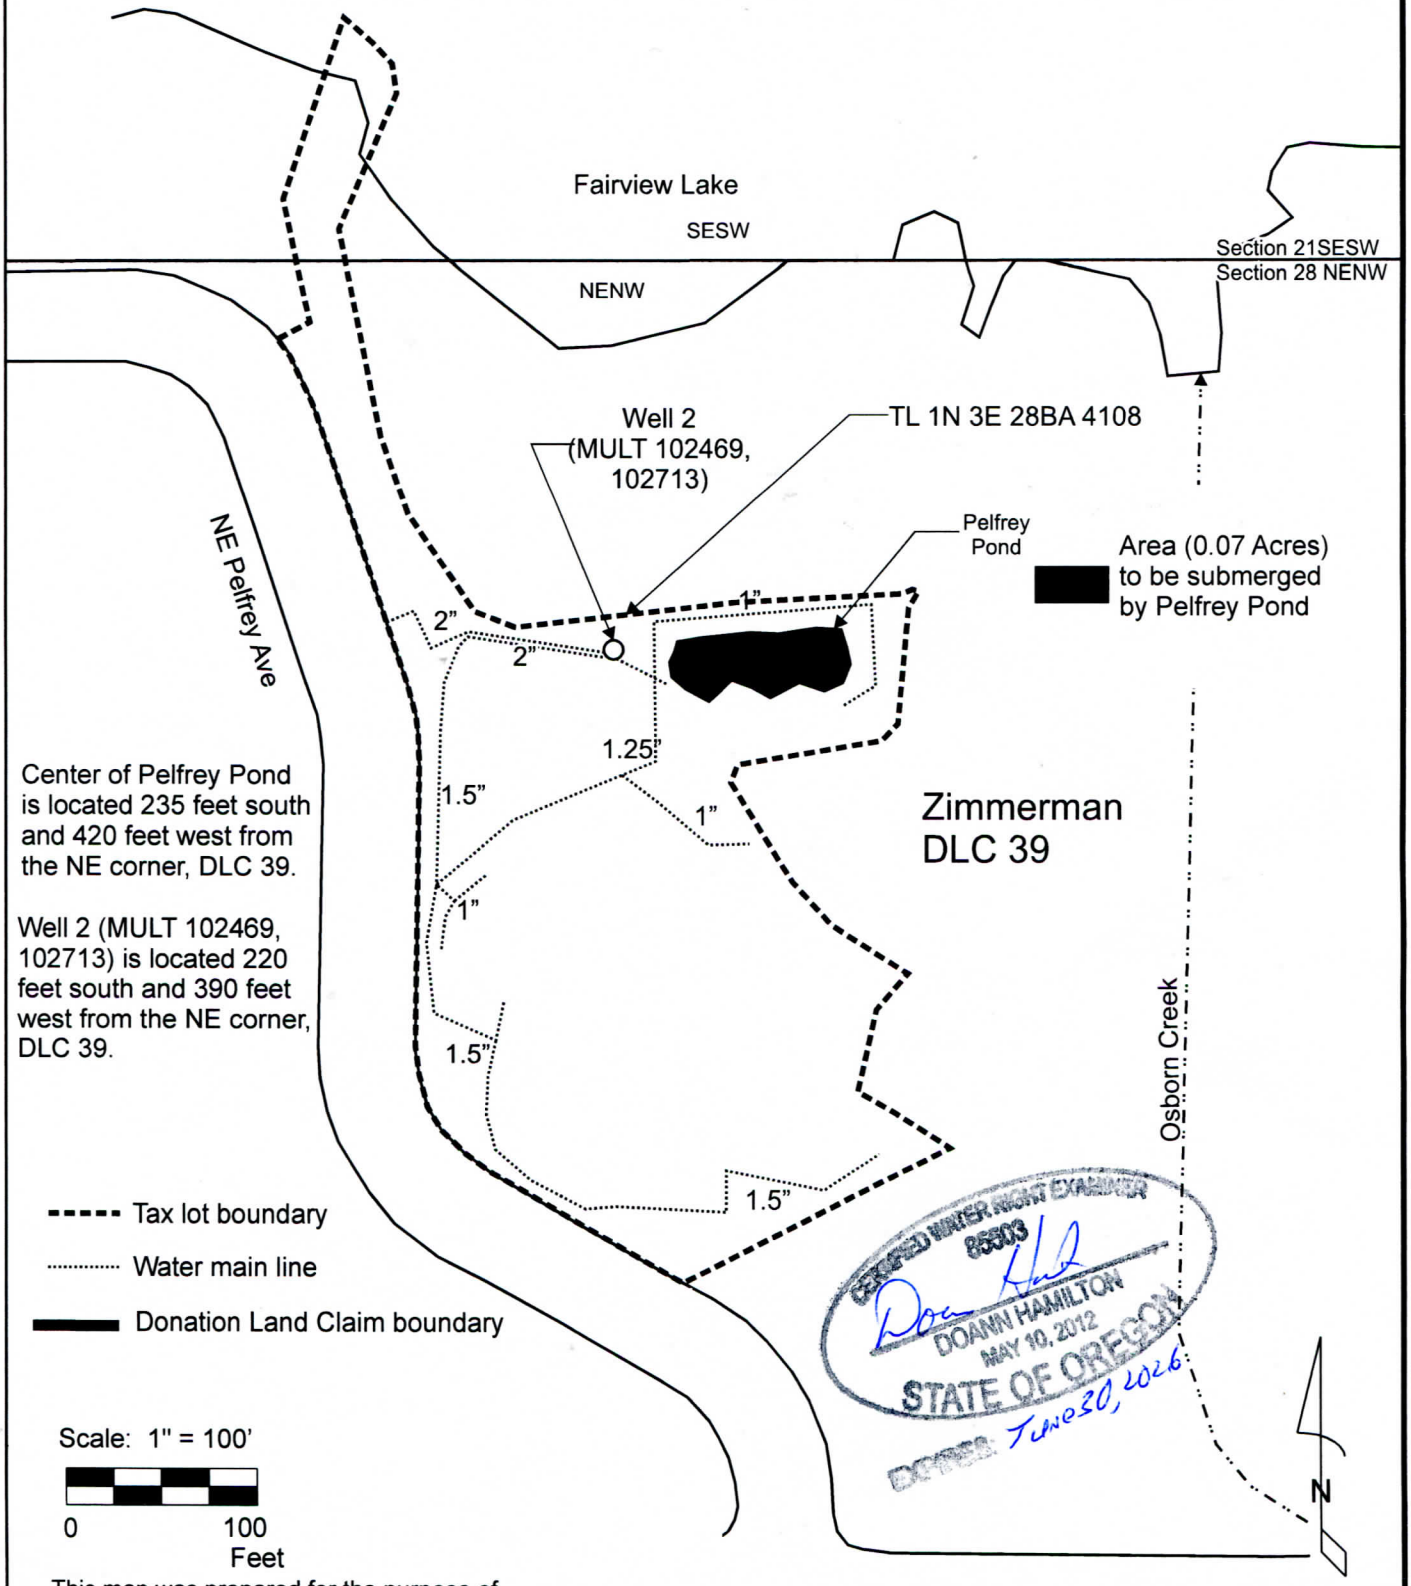

This map was prepared for the purpose of identifying the location of a water right only and is not intended to provide legal dimensions or location of property ownership lines.

Insert Map for: Reservoir Application Map

Pacific Hydro-Geology Inc.

05/2022
Rev, 10/2026

Lynnia K. Woods or Lynnia K. Pelfrey
T.1N. R.3E. Section 28, W.M.