
CLAIM OF BENEFICIAL USE MAP

TO ADD PLACE OF USE AND A POINT OF APPROPRIATION FOR APPLICATION G-18911

SOUTH 1/2 OF SECTION 16 AND NORTH 1/2 OF SECTION 21,
TOWNSHIP 36 SOUTH, RANGE 24 EAST, W.M.
TAX LOTS: 3400 AND 3800

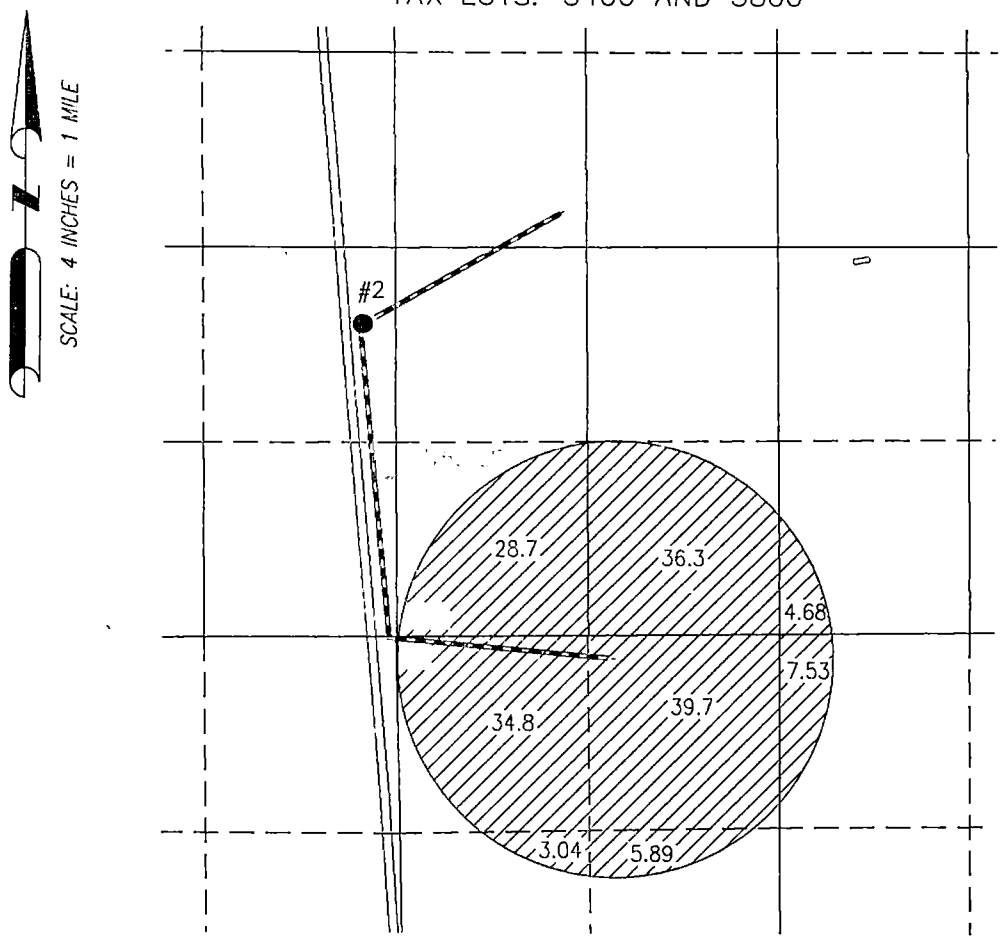

160.64 AC IR FROM POA2
(PERMIT G-18725)

CONVEYANCE

THIS MAP IS FOR THE PURPOSE OF LOCATING A WATER RIGHT ONLY AND HAS NO INTENT TO PROVIDE LEGAL DIMENSIONS OR THE LOCATION OF PROPERTY LINES

POA 2 (LAKE 1840) 42.44499° -119.90571°
LOCATED IN THE NE 1/4 SE 1/4 SECTION 17, T36S R24E, W.M. AND 1300 FEET NORTH AND 380 FEET WEST FROM THE SE CORNER OF SECTION 17. FLOW METER LOCATED 8 FEET EAST ON DELIVERY PIPE.

Certified Water Right Examiner
#51324 WRE
Scott D. Montgomery
May 21, 2001
STATE OF OREGON

RENEWAL DATE: 12/31/2026

PREPARED FOR:

FITZGERALD RANCH, INC.
220 N 'G' STREET
LAKEVIEW, OR 97630

PREPARED BY:

ALL POINTS ENGINEERING AND SURVEYING, INC.
P.O. BOX 767 TERREBONNE, OR 97760
(541) 548-5833 www.APEandS.com