


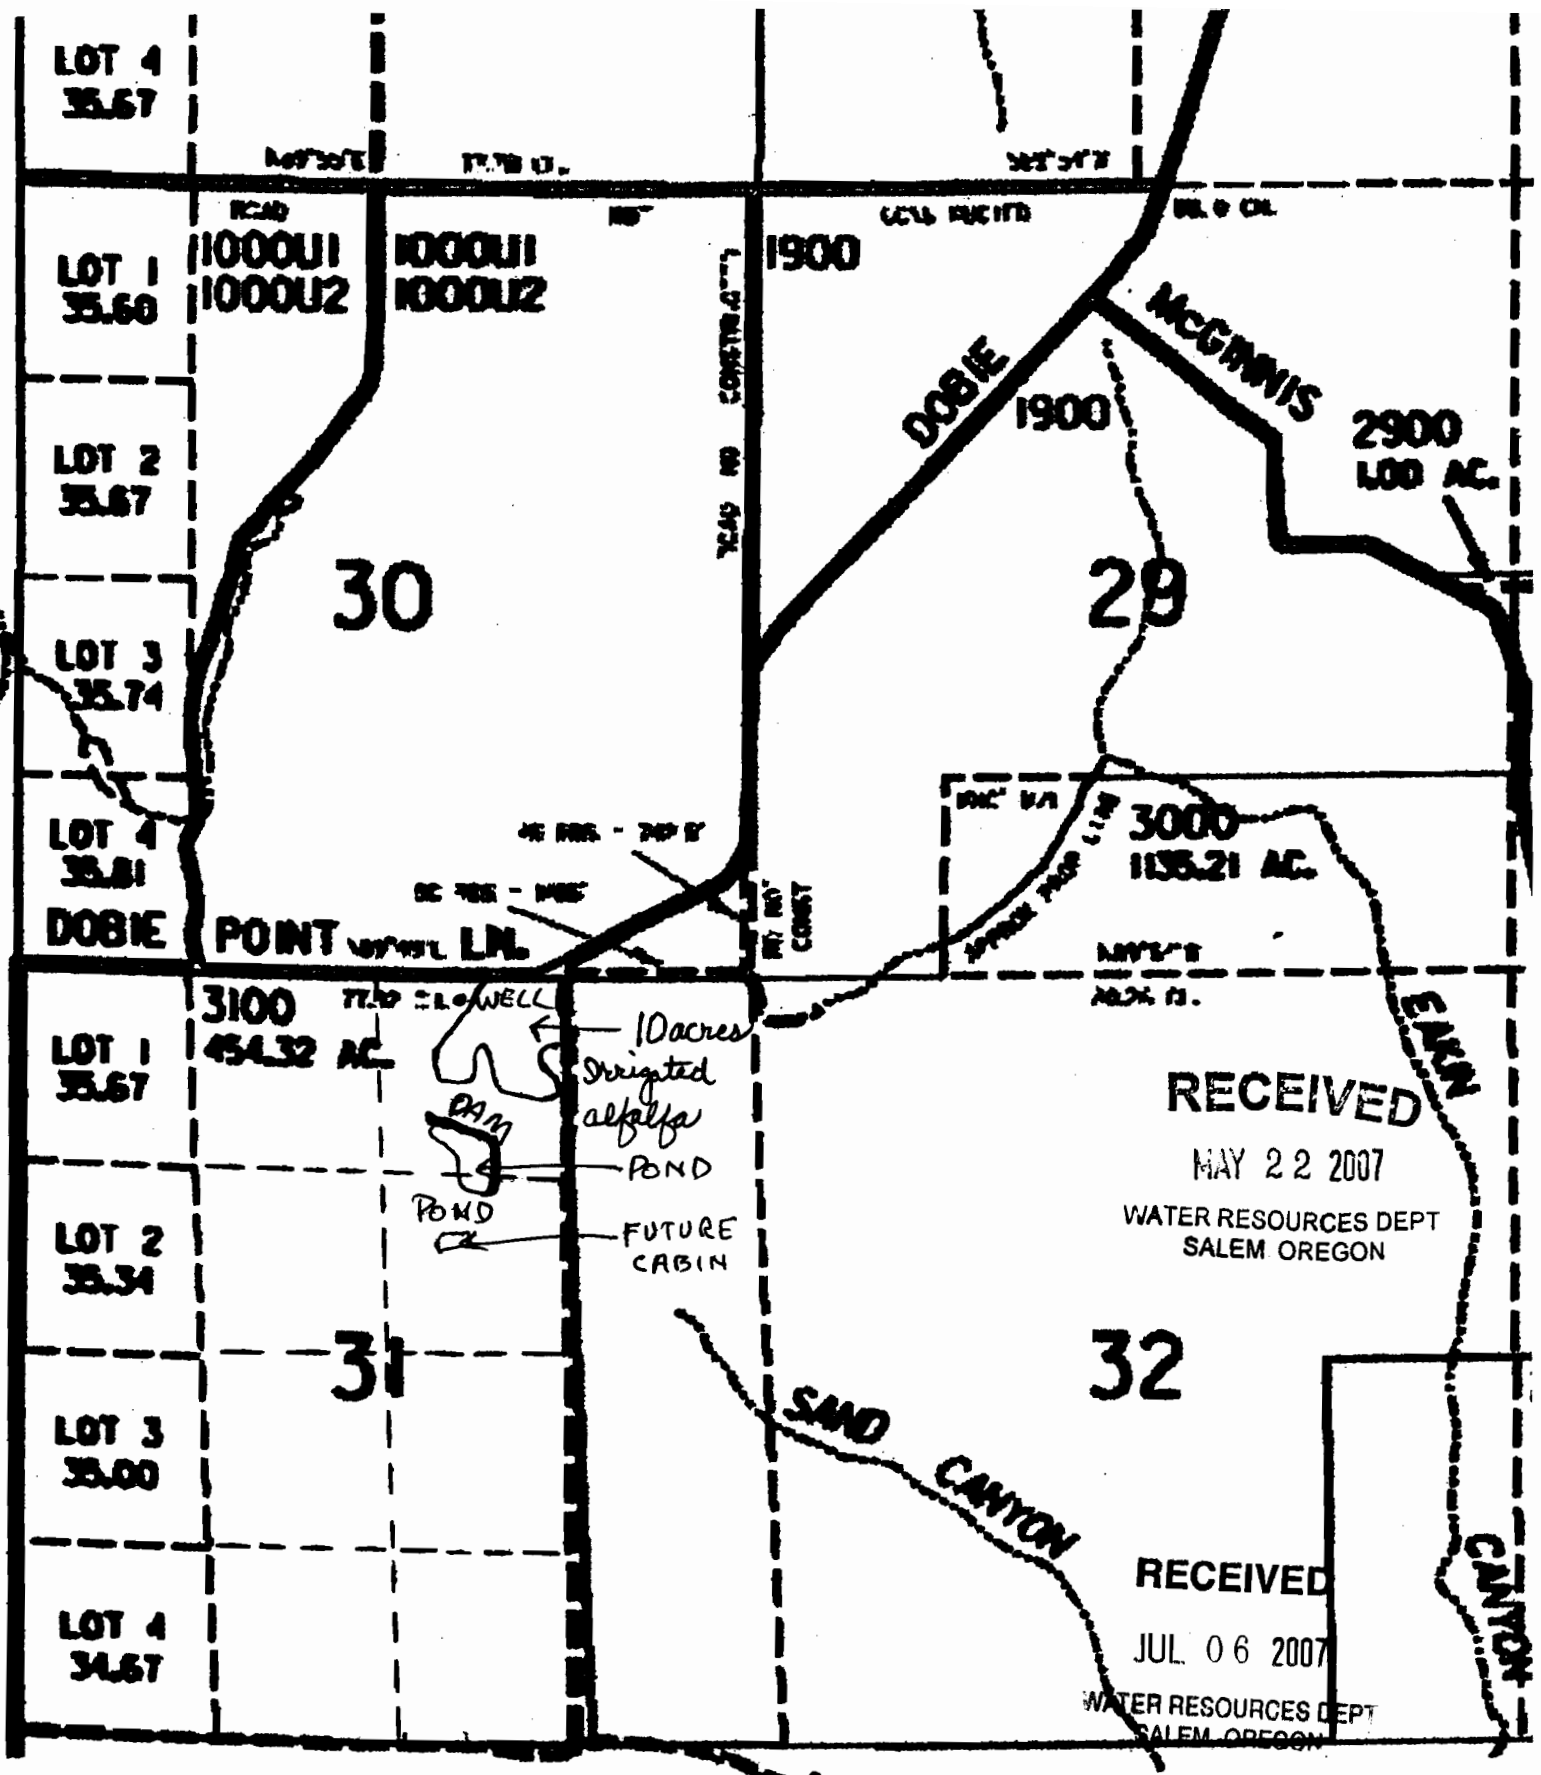

Well is 3168 ft east
 5108' N. of the S.W.
 corner of Section 31

4 S / 18 E / 31

NW 1/4 of the NE 1/4 & SW 1/4 of NE 1/4
 Section 3100
 TAK LOT 3100

4" = 1 mile

located 3168 ft. East & 4008' N. of the S.W. corner of Sec. 31, Sherman County