T.2N., R.12E., W.M.

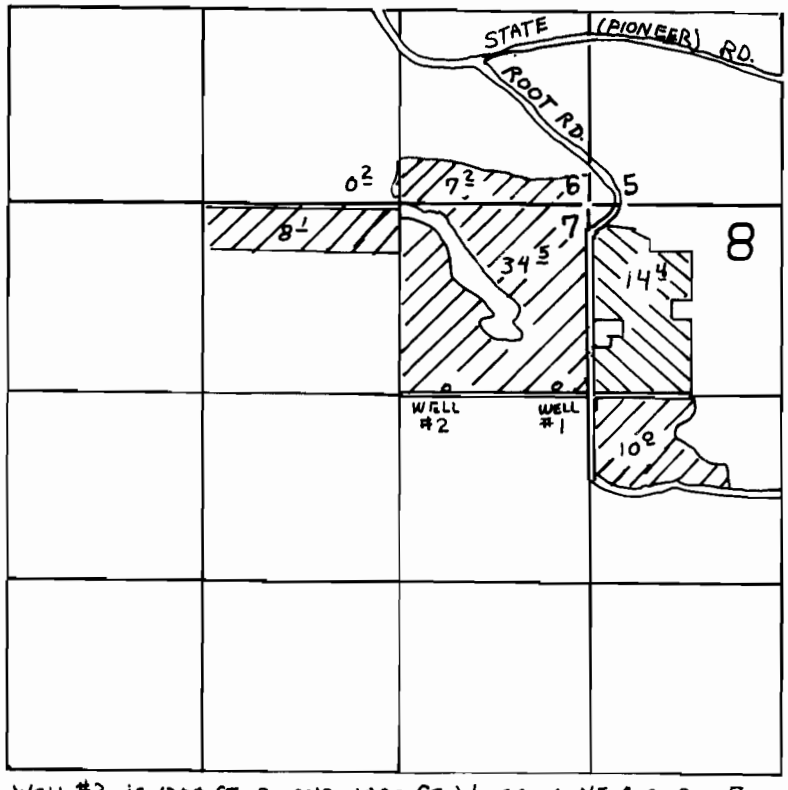

WELL #2 IS 1300 FT. S. AND 1000 FT W. FROM N.E. COR SEC 7
AS PER FINAL PROOF SURVEY FOR PERMIT No. G-8865.
(SUPPLEMENTAL WELL) WATER RIGHT CERTIFICATE #64936

WELL #1 IS 1280 FT. S AND 190 FT W. FROM N.E. COR. SEC. 7
(PRIMARY WELL) PERMIT G-10911

FINAL PROOF SURVEY
UNDER

Application No. G-11722 Permit No. G-10911
IN NAME OF

W.B. and M. JEANNE REEVES

Surveyed Sept. 19 1985, by T. PAUL – SUPPLEMENTAL (W.R.C. #64736
Surveyed Sept. 19 1993, by P.J. HINDS
} Both as PRIMARY Permit G10911

SCALE 1" = 1320'

The purpose of this map is to locate the water right. It is not intended to provide legal dimensions or location of property ownership lines.

Certified Water Right Examiner
#224
Patrick J. Hinds
Patrick J. Hinds
Map
STATE OF OREGON