



Oregon

Theodore R. Kulongoski, Governor

In reference to

Potential Conflict

to

App: 616828

Water Resources Department

North Mall Office Building

725 Summer Street NE, Suite A

Salem, OR 97301-1271

503-986-0900

FAX 503-986-0904

MAILED: OCTOBER 24, 2007

NOTICE

Reference: Permit G-8734 Application G-9315

Enclosed is a proposed certificate of water right and a map which illustrates the location of the right. The map and proposed certificate represent the extent water was used within the terms of the permit based upon a survey and inspection.

If you do not agree with the proposed certificate or the map, Oregon Administrative Rule 690-330-010 (2) allows the permittee or landowner 60 days from the mailing date of this notice to request the Department to reconsider the contents of the proposed certificate.

If you agree with the proposed certificate and map no response to this notice is required. Sometime after the 60 day period, the recorded certificate of water right will be mailed to the permittee.

If you have any questions please contact Gerry Clark at 503-986-0811.

Sincerely,

Dwight French
Administrator
Water Rights Division

STATE OF OREGON

COUNTY OF HARNEY

CERTIFICATE OF WATER RIGHT

THIS CERTIFICATE ISSUED TO

ROY LEE REED
STAR ROUTE 1, BOX 94
TURNOUT ROAD
BURNS OR 97720

confirms the right to use the waters of ONE WELL in the Poison Creek Basin for IRRIGATION of 27.4 ACRES.

This right was perfected under Permit G-8734. The date of priority is JULY 17, 1979. The amount of water to which this right is entitled is limited to an amount actually used beneficially, and shall not exceed 0.34 CUBIC FOOT PER SECOND or its equivalent in case of rotation, measured at the well.

The well is located as follows:

Twp	Rng	Mer	Sec	Q-Q	Survey Coordinates
22 S	31 E	WM	28	SW SW	80 FEET NORTH AND 1160 FEET EAST FROM SW CORNER, SECTION 28

The amount of water used for irrigation, together with the amount secured under any other right existing for the same lands, is limited to a diversion of ONE-EIGHTIETH of one cubic foot per second, or its equivalent for each acre irrigated, and shall be further limited to a diversion of not to exceed 3.0 acre-feet per acre for each acre irrigated during the irrigation season of each year. The right to the use of the water for the above purpose is restricted to beneficial use on the lands or place of use described.

A description of the place of use to which this right is appurtenant is as follows:

Twp	Rng	Mer	Sec	Q-Q	Acres
22 S	31 E	WM	28	SW SW	1.9
22 S	31 E	WM	28	SE SW	9.4
22 S	31 E	WM	28	SW SE	0.4
22 S	31 E	WM	33	NE NW	11.2
22 S	31 E	WM	33	NW NW	4.5

The well shall be maintained in accordance with the General Standards for the Construction and Maintenance of Water Wells in Oregon.

NOTICE OF RIGHT TO PETITION FOR RECONSIDERATION OR JUDICIAL REVIEW

This is an order in other than a contested case. This order is subject to judicial review under ORS 183.484. Any petition for judicial review must be filed within the 60 day time period specified by ORS 183.484(2). Pursuant to ORS 536.075 and OAR 137-004-0080, you may either petition for judicial review or petition the Director for reconsideration of this order. A petition for reconsideration may be granted or denied by the Director, and if no action is taken within 60 days following the date the petition was filed, the petition shall be deemed denied. In addition, under ORS 537.260 any person with an application, permit or water right certificate subsequent in priority may jointly or severally contest the issuance of the certificate at any time before it has issued, and after the time has expired for the completion of the appropriation under the permit, or within three months after issuance of the certificate.

PROPOSED

See
wmi

The works shall be equipped with a usable access port, and may also include an air line and pressure gauge to determine the water level elevation in the well at all times.

The water user shall maintain a weir, meter, or other suitable measuring device and keep a complete record of the amount of ground water withdrawn.


The use of water shall be limited when it interferes with any prior surface or ground water rights.

WITNESS the signature of the Water Resources Director, affixed _____.

PROPOSED

Phillip C. Ward, Director
Water Resources Department

T. 22S., R. 31E., W. M.

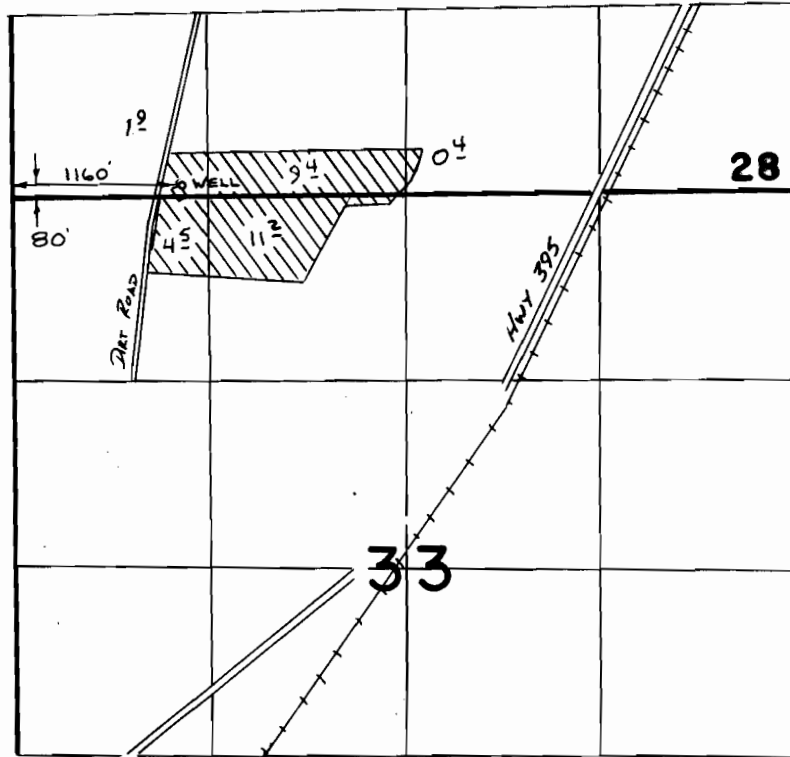

SCALE 1" = 1320'

FINAL PROOF SURVEY
UNDER

Application No. **G:9315** Permit No. **G:8734**
IN NAME OF

ROY LEE REED

Surveyed 5-10 1988, by M. Schmede