


Well 10 Amended



T22S R21E S 9,10,15,16

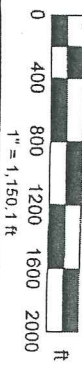

Data use subject to license.

© DeLorme, Topo USA® 8

www.delorme.com

RECEIVED

SEP 21 2010

WATER RESOURCES DEPT
SALEM, OREGON

Stephen Roth
Amended Place of Beneficial Use
541-410-1012
Township 22S, Range 21 E
80.3.97 acres 10.05 CFS

RECEIVED
SEP 21 2010
WATER RESOURCES DEPT
SALEM, OREGON

Sec 9

SW 1/4 NE 1/4	2.76
SE 1/4 NE 1/4	27.47
NE 1/4 SE 1/4	40.06
NW 1/4 SE 1/4	17
SW 1/4 SE 1/4	7.11
SE 1/4 SE 1/4	36.46

Section 10

SW 1/4 NE 1/4	3.77
SW 1/4 NW 1/4	25.72
SE 1/4 NW 1/4	2.73
NE 1/4 SW 1/4	33.96
NW 1/4 SW 1/4	37.05
SW 1/4 SW 1/4	30.85
SE 1/4 SW 1/4	19.86
NE 1/4 SE 1/4	14.62
NW 1/4 SE 1/4	40.01
SW 1/4 SE 1/4	37.46
SE 1/4 SE 1/4	11.3

Section 15

NE 1/4 NE 1/4	5.31
NW 1/4 NE 1/4	32.17
SW 1/4 NE 1/4	38.24
SE 1/4 NE 1/4	12.86
NE 1/4 NW 1/4	28.83
NW 1/4 NW 1/4	25.15
SW 1/4 NW 1/4	27.38
SE 1/4 NW 1/4	41.32
NE 1/4 SW 1/4	10.48
NE 1/4 SE 1/4	0.5
NW 1/4 SE 1/4	15.04

Section 16

NE 1/4 NE 1/4	31.86
NW 1/4 NE 1/4	23.92
SW 1/4 NE 1/4	36.47
SE 1/4 NE 1/4	29.11
NE 1/4 NW 1/4	36.4
NW 1/4 NW 1/4	6.36

76 N. 5 N

