


Verheyden

T.17S. R.11E.W.M.
DESCHUTES COUNTY

1" = 2000'
See Map 16 11

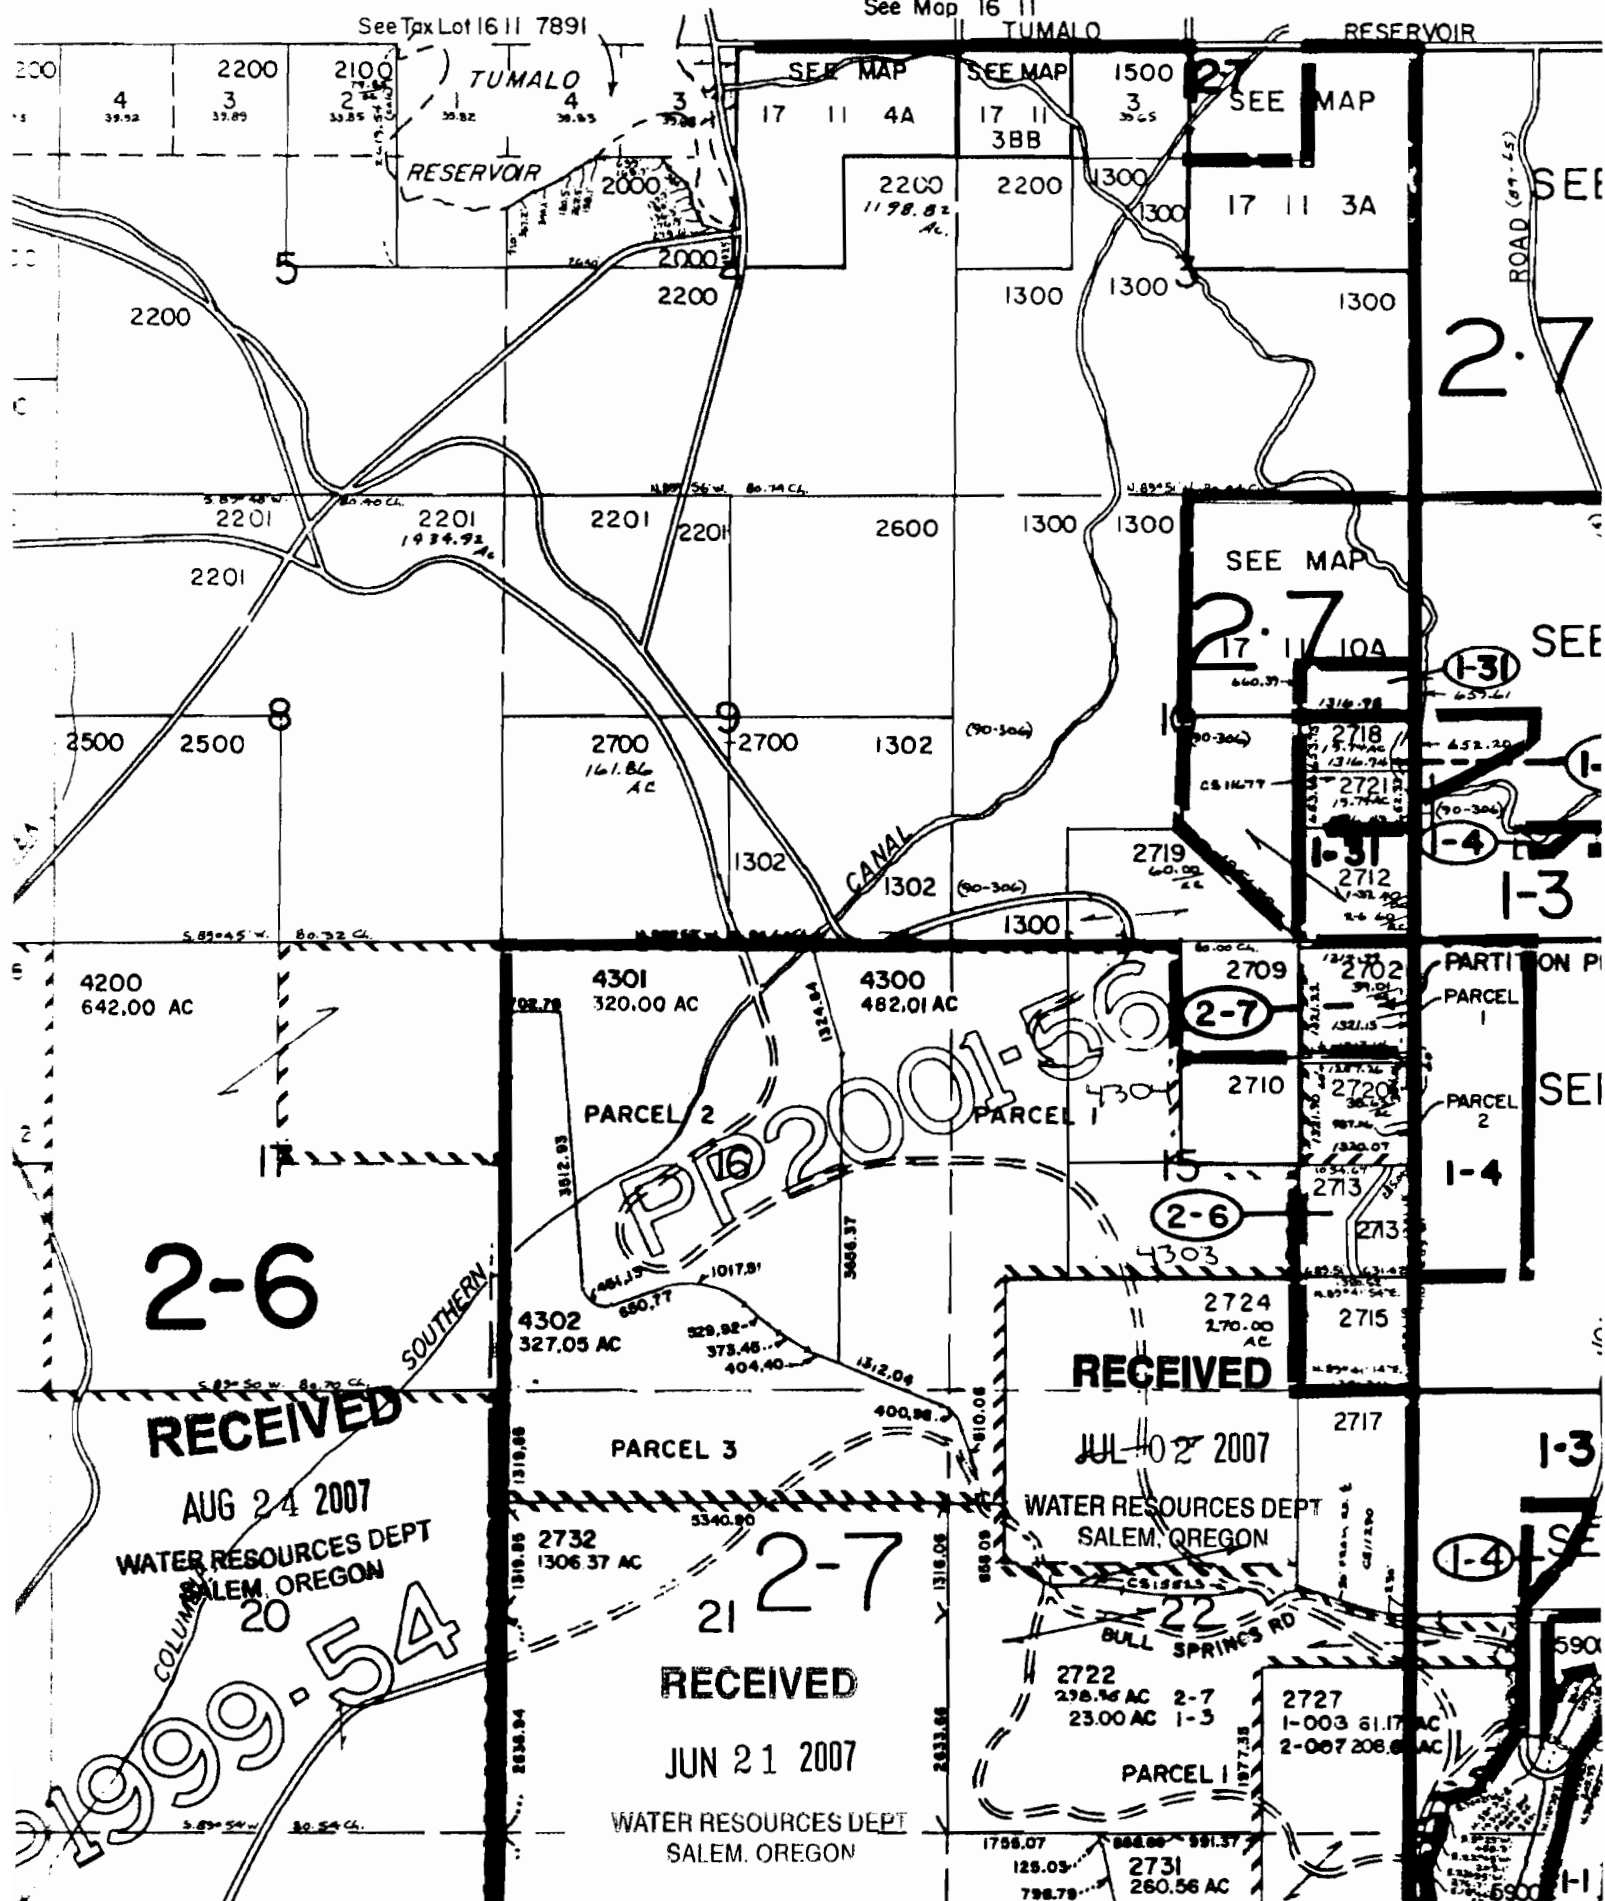

2-6

RECEIVED

AUG 24 2007
WATER RESOURCES DEPT
SALEM, OREGON

1999-54

2-7

RECEIVED

JUN 21 2007

WATER RESOURCES DEPT
SALEM, OREGON

RECEIVED

JUL 02 2007

WATER RESOURCES DEPT
SALEM, OREGON

2722
238.16 AC 2-7
23.00 AC 1-3

PARCEL 1

2731
260.56 AC

2.7

2.7

1-3

1-3

1-4

1-3

1-4

1-1

PP 2001-56