

RECEIVED

OCT 01 1999

WATER RESOURCES DIVISION
BUREAU OF LAND MANAGEMENT

KLAMATH BASIN WATER RIGHT CLAIM #376

BY THE
UNITED STATES OF AMERICA,
DEPARTMENT OF THE INTERIOR,
BUREAU OF LAND MANAGEMENT
FOR
FEDERAL RESERVED RIGHT
ON THE
KLAMATH RIVER

THE PURPOSE OF THIS MAP IS FOR IDENTIFYING THE LOCATION OF THE WATER RIGHT AND
IS NOT INTENDED TO PROVIDE LEGAL DIMENSION OR LOCATION
OF PROPERTY OWNERSHIP.

BUREAU OF LAND MANAGEMENT
OREGON STATE OFFICE
BRANCH OF GEOGRAPHIC SCIENCE

LETTER OF AUTHORIZATION
DATED: AUGUST 10, 1999


EXECUTED BY:

RICHARD L. JOHNSON, PLS, WRE
OR-957.1
E.O. BOX 2965
PORTLAND, OR 97208

The upper reach is located in the SE 1/4 of the NE 1/4 of
section 14, T. 40 S., R. 6 E., WM.

Tie to the upper reach, from the corner of sections 11, 12, 13
and 14, T. 40 S., R. 6 E., WM., to the downstream side of
John Boyle Dam powerhouse project boundary was
calculated from the map "KLAMATH RIVER PROJECT,
BIG BEND DEVELOPMENT", EXHIBIT K-4, SHEET #5,
DATED MARCH 30, 1959.

S. 87° 26' W., 1970 FT

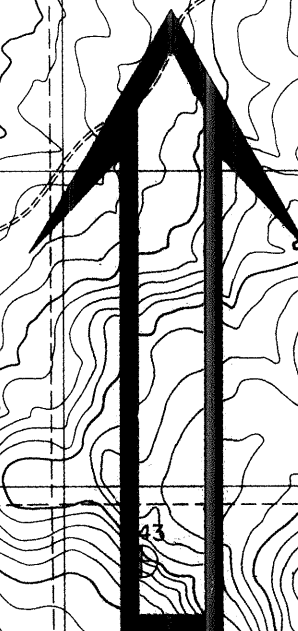

N

1: 24,000

SOURCE OF MAP:

UNITED STATES GEOLOGICAL SURVEY,
7.5 MINUTE QUADRANGLE

MULE HILL, OREG.-CALIF
PROVISIONAL EDITION, 1985

CHICKEN HILLS, OREG.-CALIF
PROVISIONAL EDITION, 1986


The lower reach is located in Lot 3 of section 13,
T. 41 S., R. 5 E., WM.

The tie to the lower reach was calculated from GPS, Trimble
Pathfinder PRO XL, data gathered at the 109 Mile Post on the
Oregon and California State Boundary, and on the left bank of
the Klamath River, a distance to the center of the river was
estimated.

S. 89° 52' W., 600 FT

IRON PIPE WITH BRASS CAP

The underlying map was compiled, the tie to the northerly reach was
computed, and the tie to the southerly reach was gathered by
Richard L. Johnson, WRE, PLS.

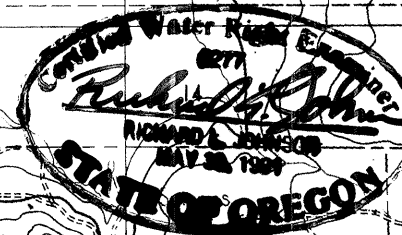

376 120