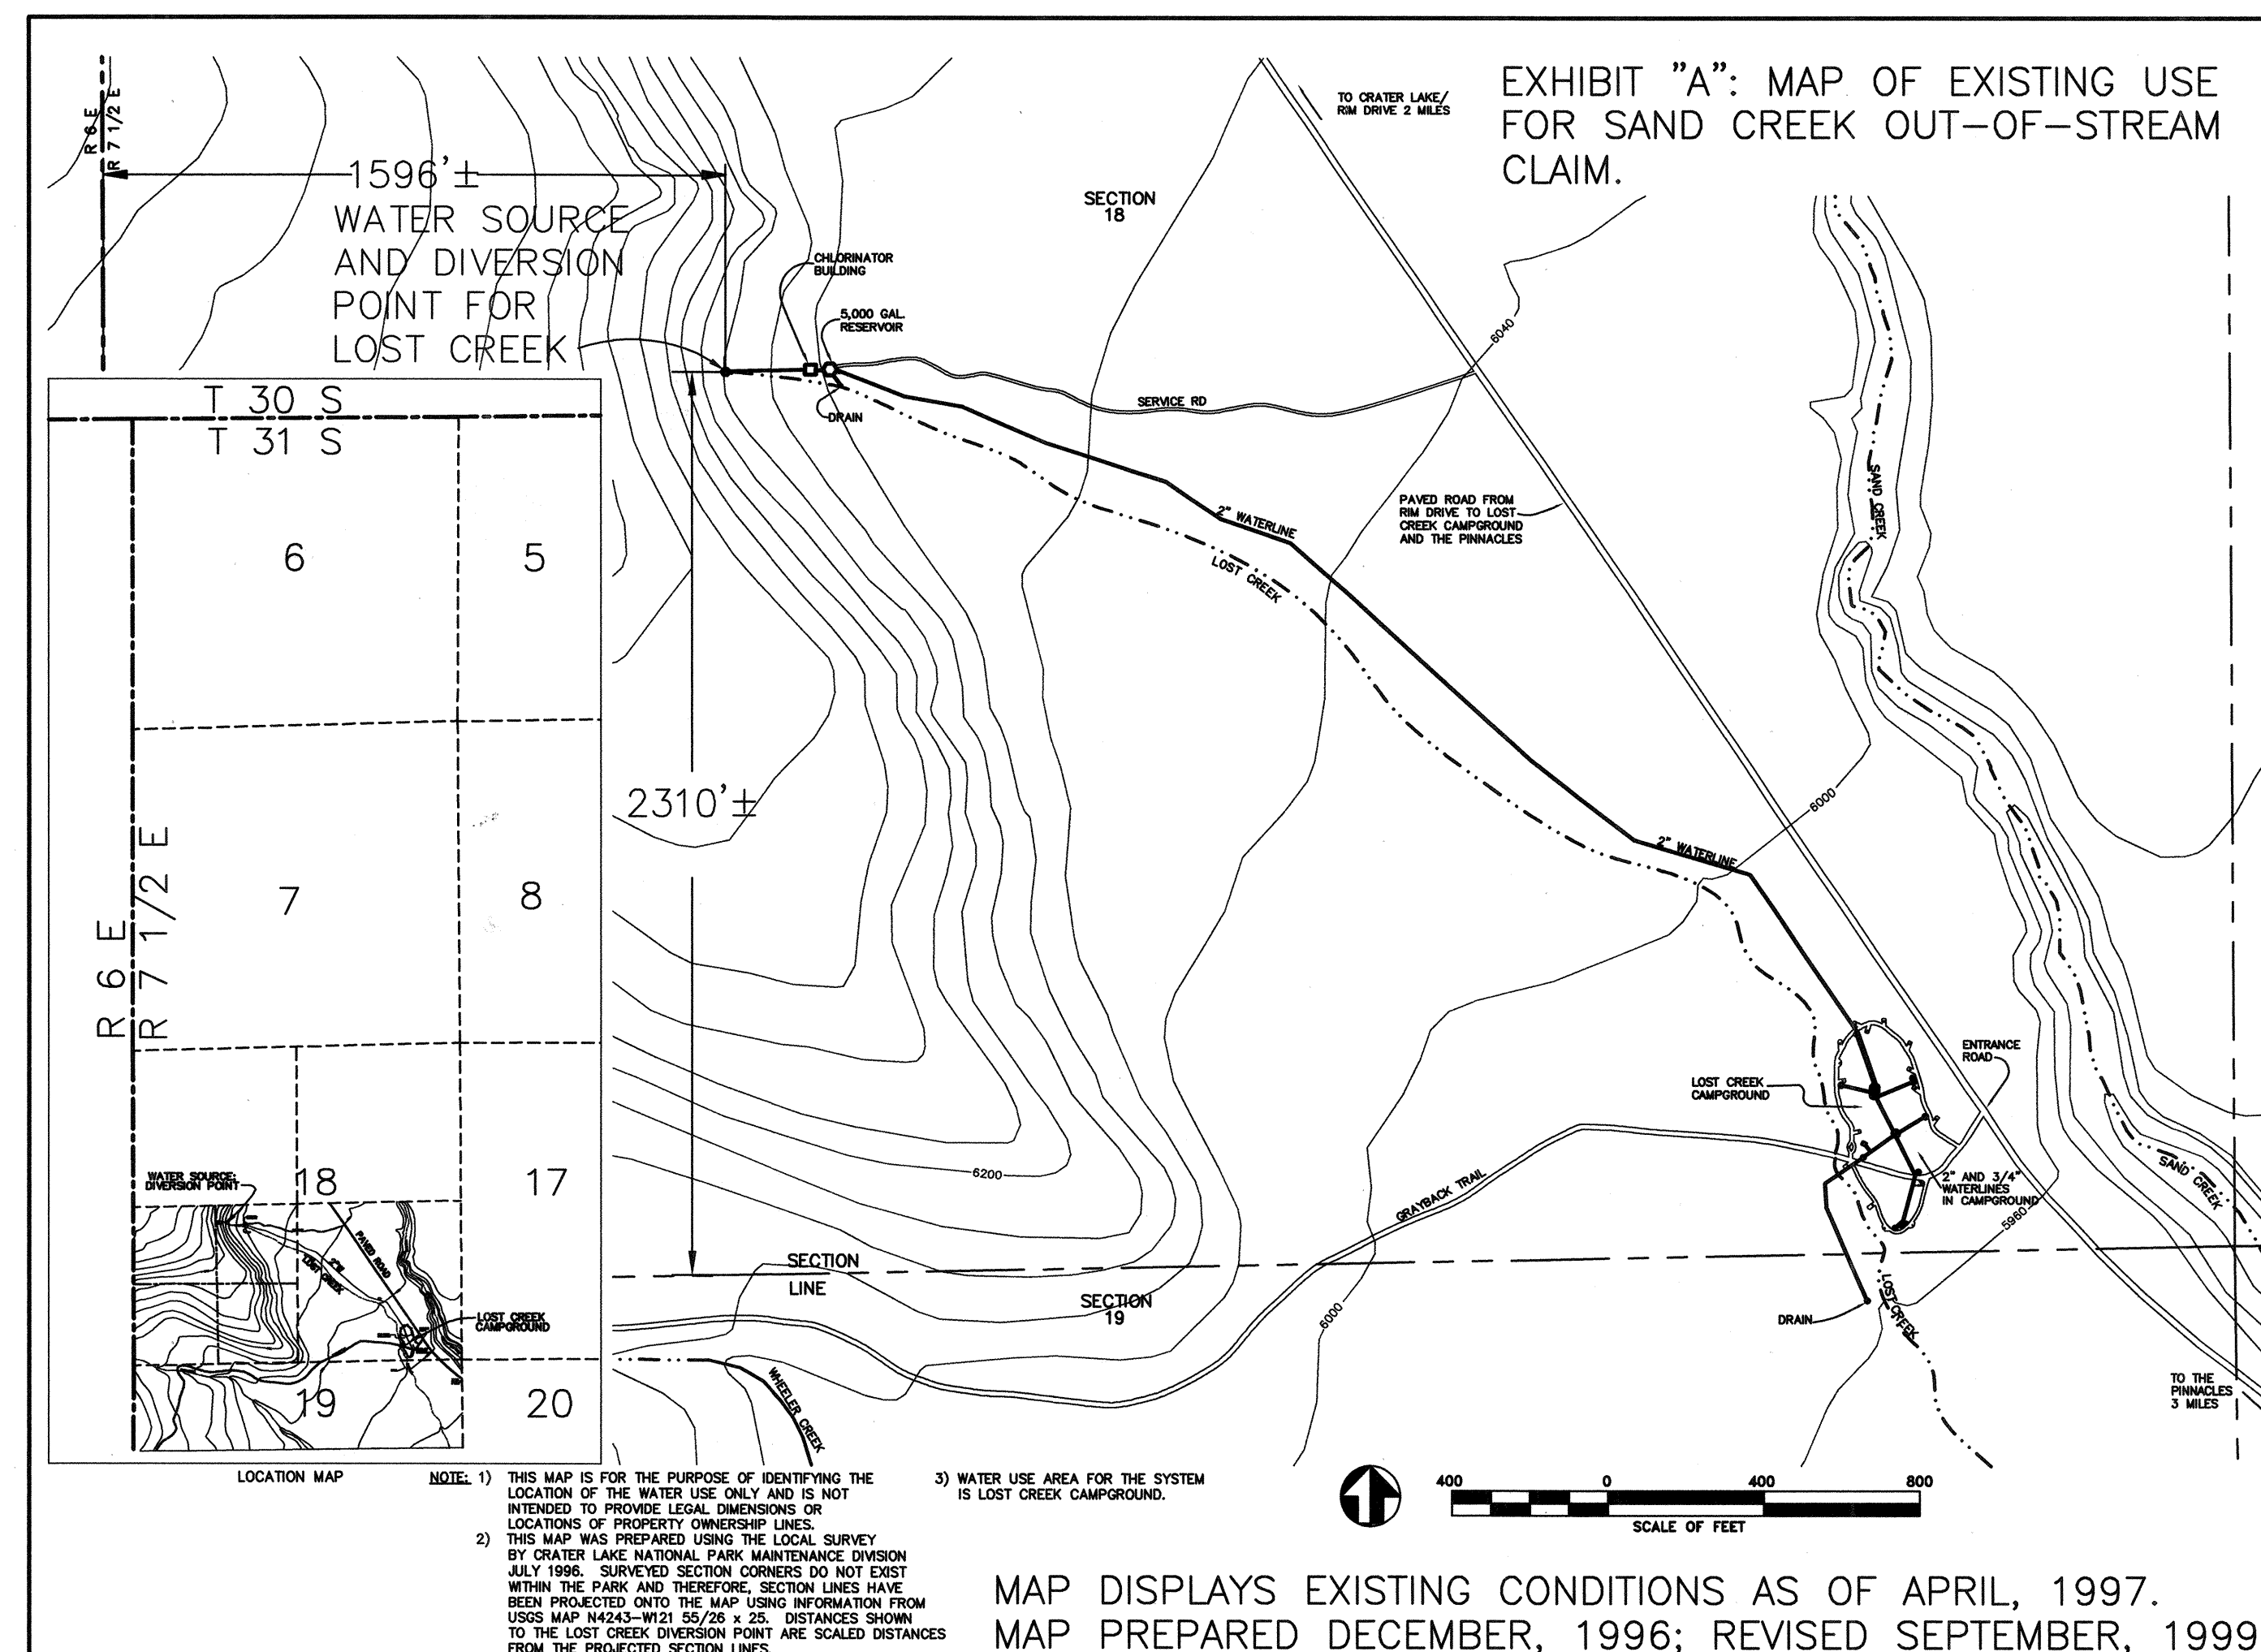


CRATER LAKE
NATIONAL PARK

EXISTING USES UNDER SAND CREEK FEDERAL RESERVED
WATER RIGHT CLAIM;
LOST CREEK WATER SUPPLY SYSTEM

CLAIM #606