


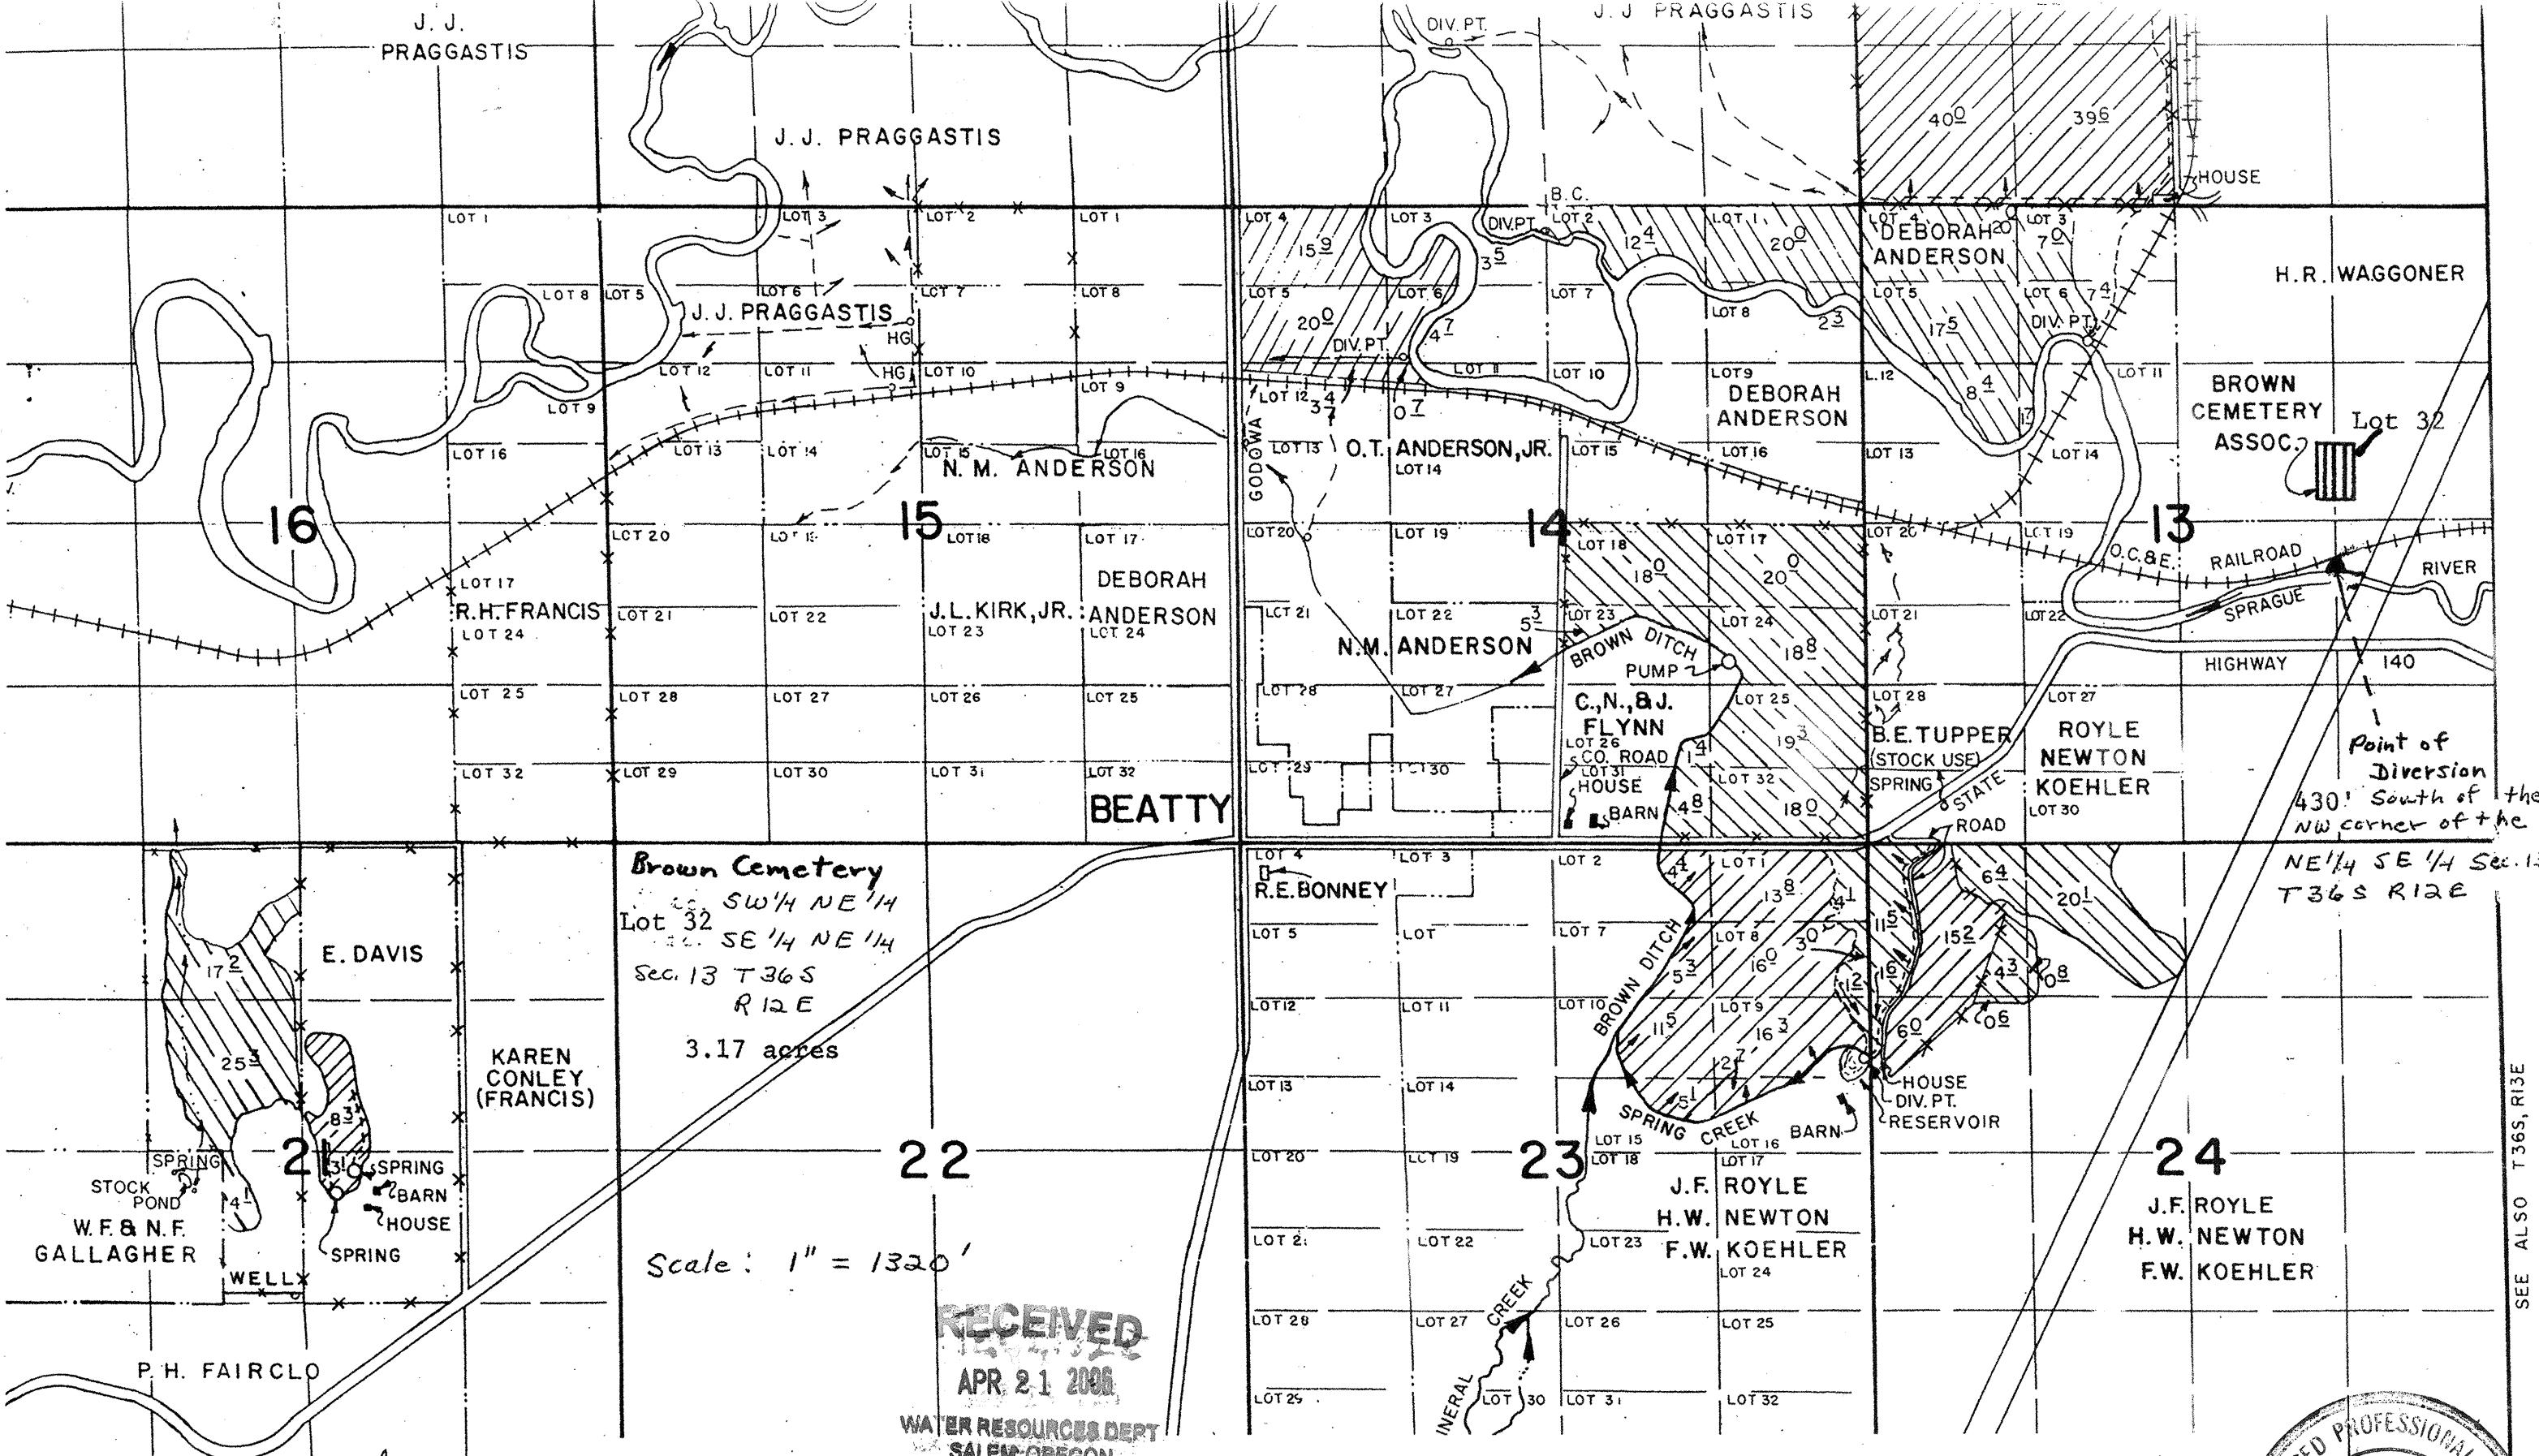

United States/Klamath
Claim No: 618
K23

TOWNSHIP 36 SOUTH, RANGE 12 EAST, W. M.

