

FINAL PROOF MAP UNDER KLAMATH ADJUDICATION CLAIM #196 & CERTIFICATE #11106

T.40S, R.1E., W.M.




LEGEND:

- = IRRIG UNDER CLAIM #196 & CERT. 11106 THIS PROOF.
- = IRRIG UNDER CLAIM #196 NOT UNDER THIS PROOF.

LOCATIONS OF DIV. PTS FROM N. 1/4 COR. S.36

- ORIG DIV PT: 1570' W & 180' S.
- SPRING #1 : 1550' W. & 100' S.
- TEMP DIV PT: 970' W. & 1000' S.
- SPRING #2: 1020' W. & 1050' S.

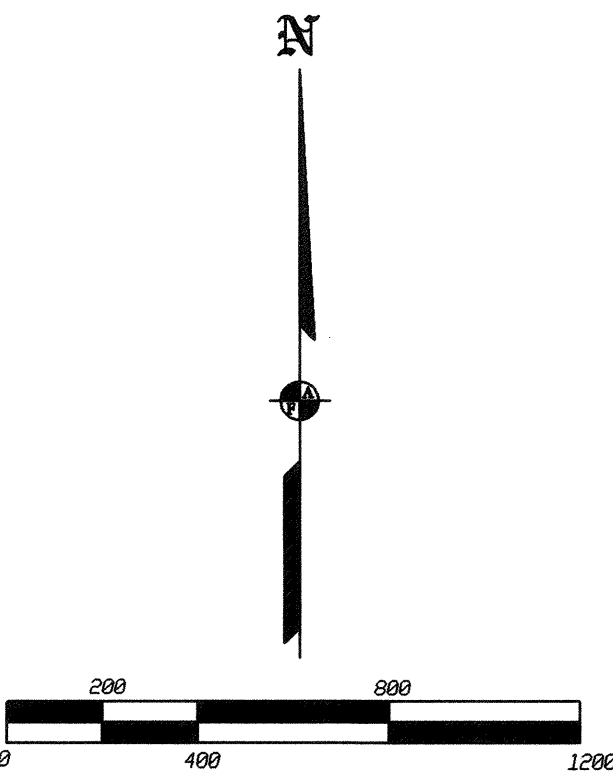

THE PREPARATION OF THIS MAP IS TO IDENTIFY THE WATER RIGHT ONLY AND IS NOT INTENDED TO PROVIDE LEGAL DIMENSIONS OF PROPERTY OWNERSHIP LINES.

	TITLE: FINAL PROOF MAP	DATE: 17 JUL 1999
	ASSESSOR'S MAP #: 40S1E36 TL900	SCALE: 1 inch = 400 feet
	FOR: KATINA AVGERIS 1700 COLESTINE ROAD ASHLAND, OR 97520 PH: 488-1768	DRAWN BY: JEH CHK BY:
	L.J. FRIAR & ASSOCIATES P.C. CONSULTING LAND SURVEYORS 816 W. 8TH ST., MEDFORD, OR (541) 772-2782	ORIGIN:
		ROTATION: 0° JOB#: 99-189
		Sheet 1 of 1.

CLAIM #196