


TOWNSHIP 48 NORTH, RANGE 3 EAST, M.D.M.

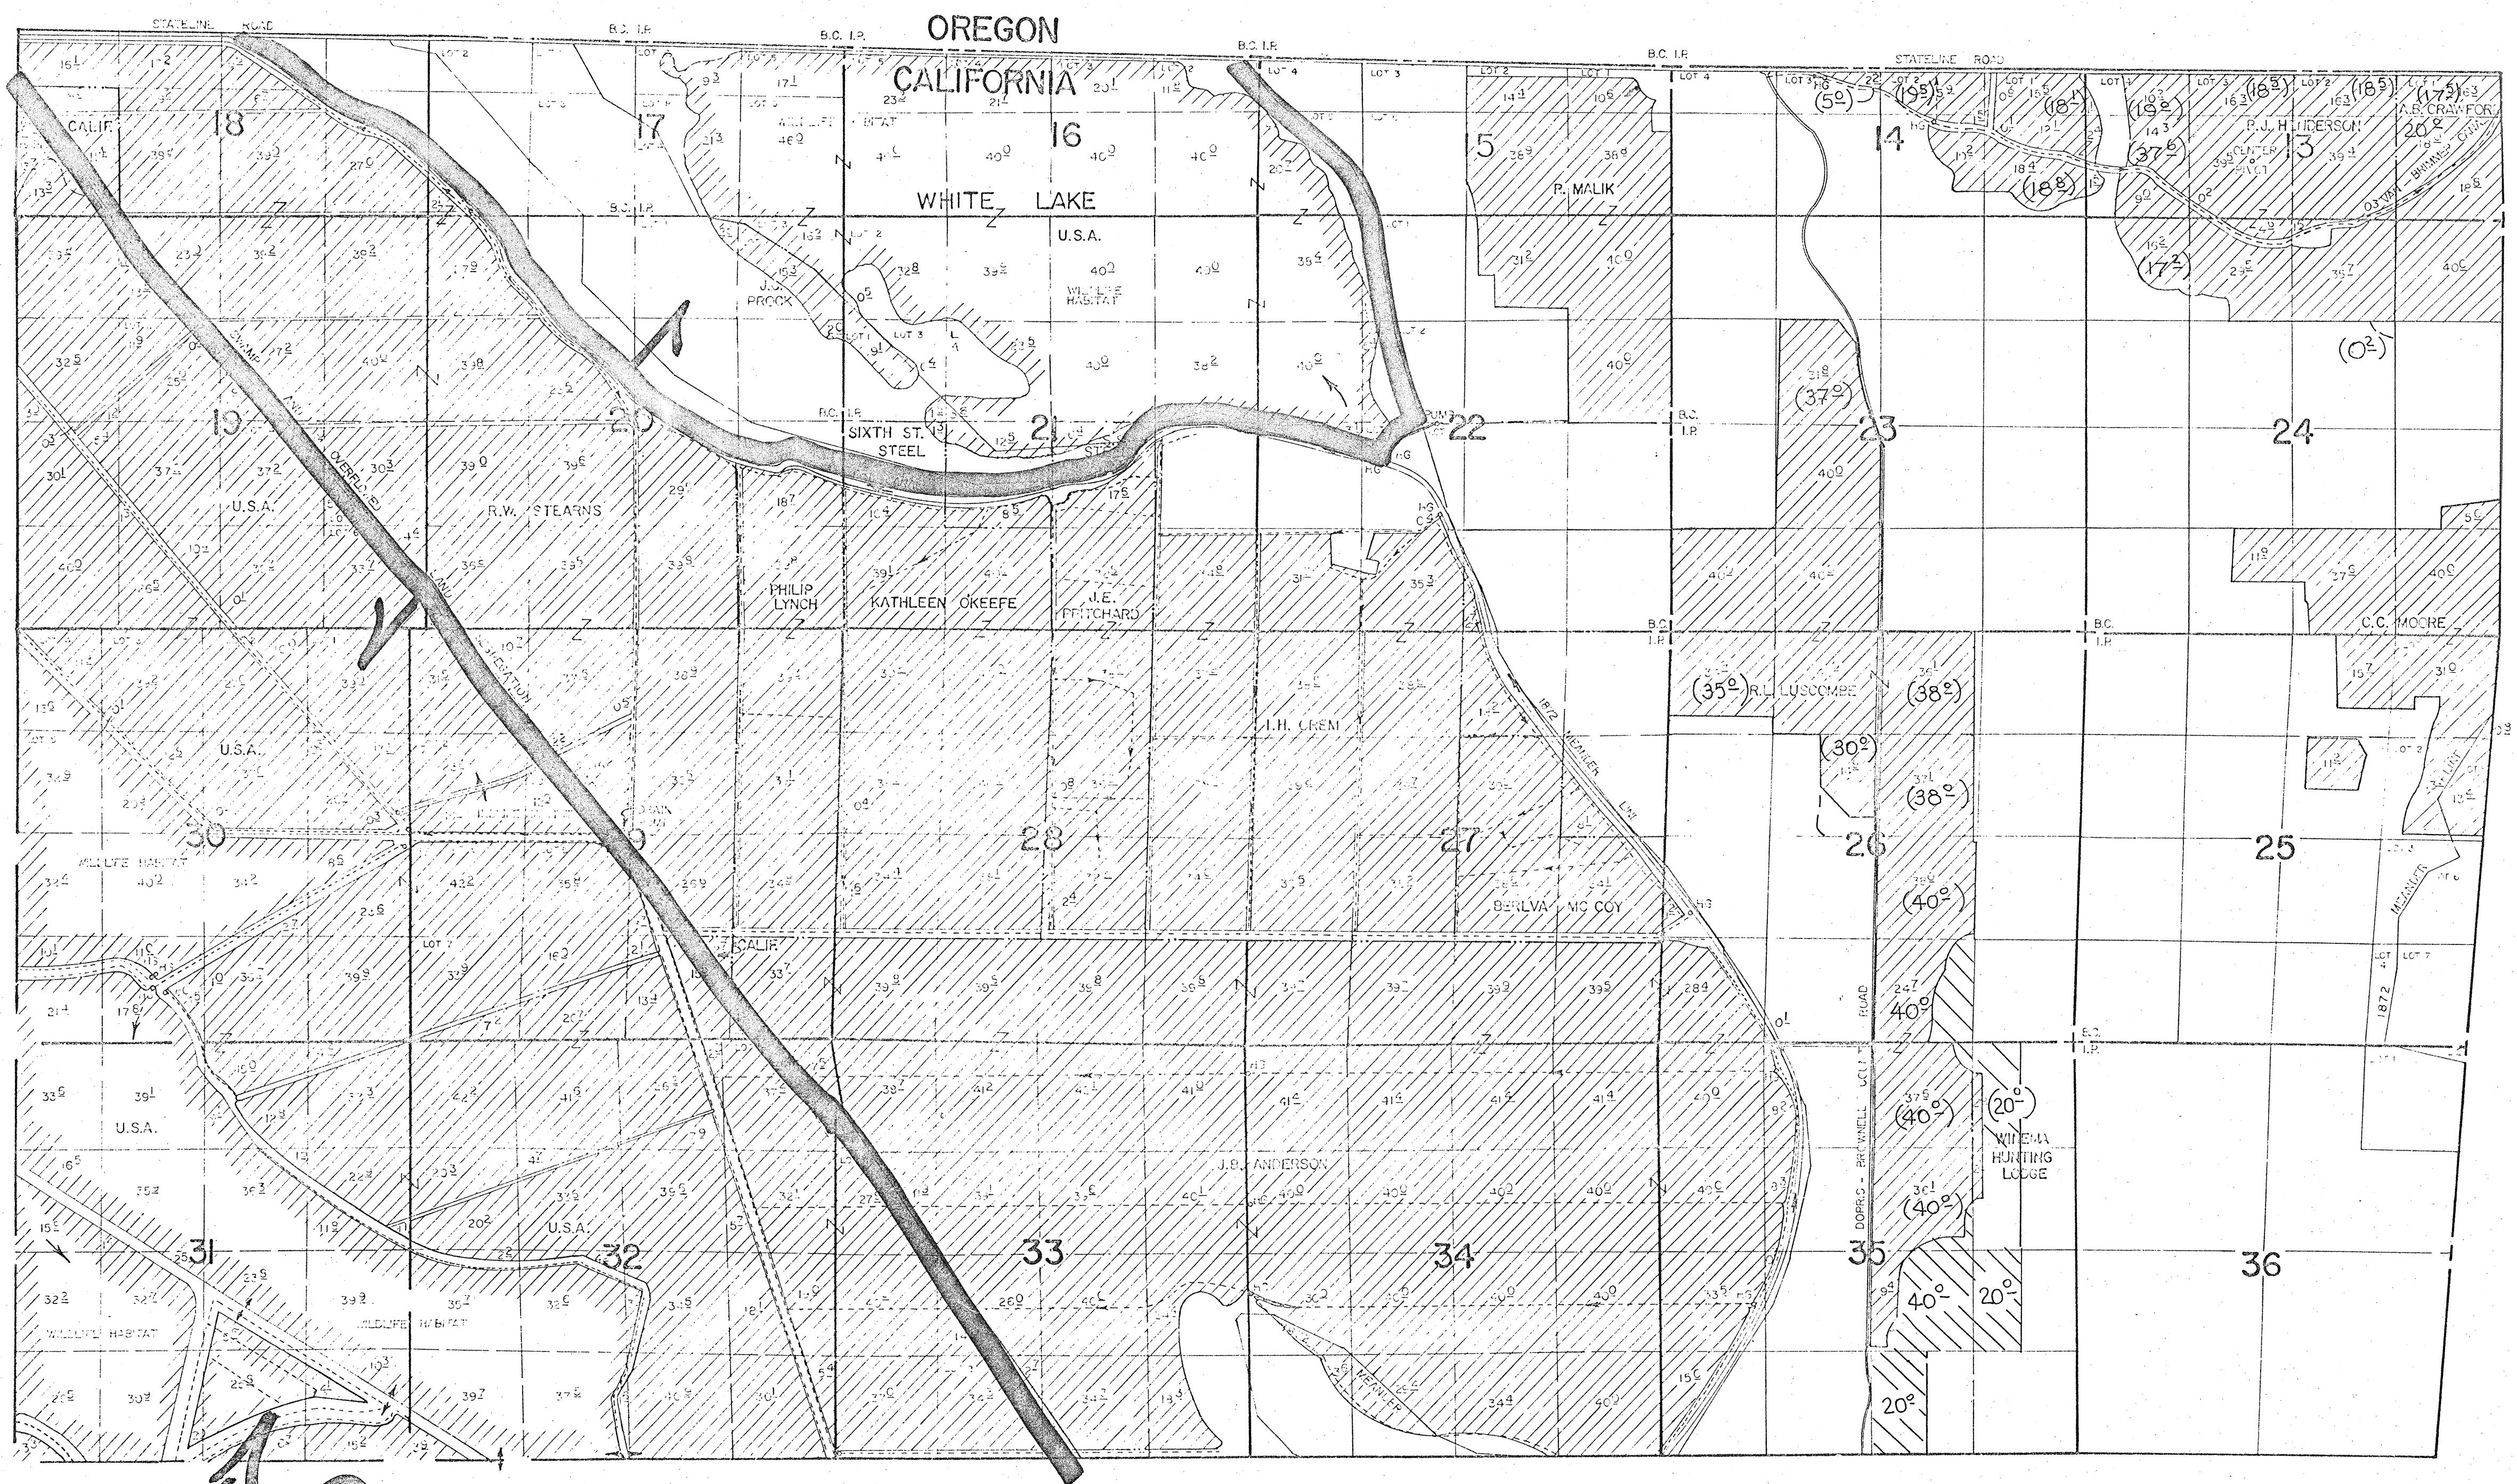


**PROJECT LANDS
CLAIMED BY USFWS**

(34.5) Indicates corrected
 acreage for the area
 34.5 u/a Indicates unirrigated
 acreage under contract