


TOWNSHIP 48 NORTH, RANGE 4 EAST, M.D.M.

PROPERTY OWNERS AND CORRESPONDING IRRIGATED LAND ACREAGES

(A) BERTHA McCOY 05	(K) E. O. SCHULTZ 03	(U) M. R. LAIRD 01
(B) A. A. HERMAN 05	(L) J. L. SIMON	(V) H. P. HANSEN
(C) R. O. HULBERT 05	(M) R. H. HANSON	(W) W. W. SCHAMEL 06
(D) A. M. VARELA 09	(N) REATHA KRIZO	(X) T. W. FREY 13
(E) B. E. SELLERS 17	(O) CLYDE TODD	(Y) T. A. FREY 01
(F) H. E. GLAZIER 06	(P) GERTIE PRINCE 19	(Z) LEON JACKSON
(G) F. M. PLASS	(Q) G. A. WRIGHT 02	(AA) WAYNE LONG
(H) M. G. PEDERSON	(R) A. S. BLOCH	(AB) REGENTS OF THE UNIVERSITY OF CALIFORNIA
(I) HOWARD KING 05	(S) J. M. PADGETT 01	
(J) T. M. WEBER	(T) RICHARD FLYNN	

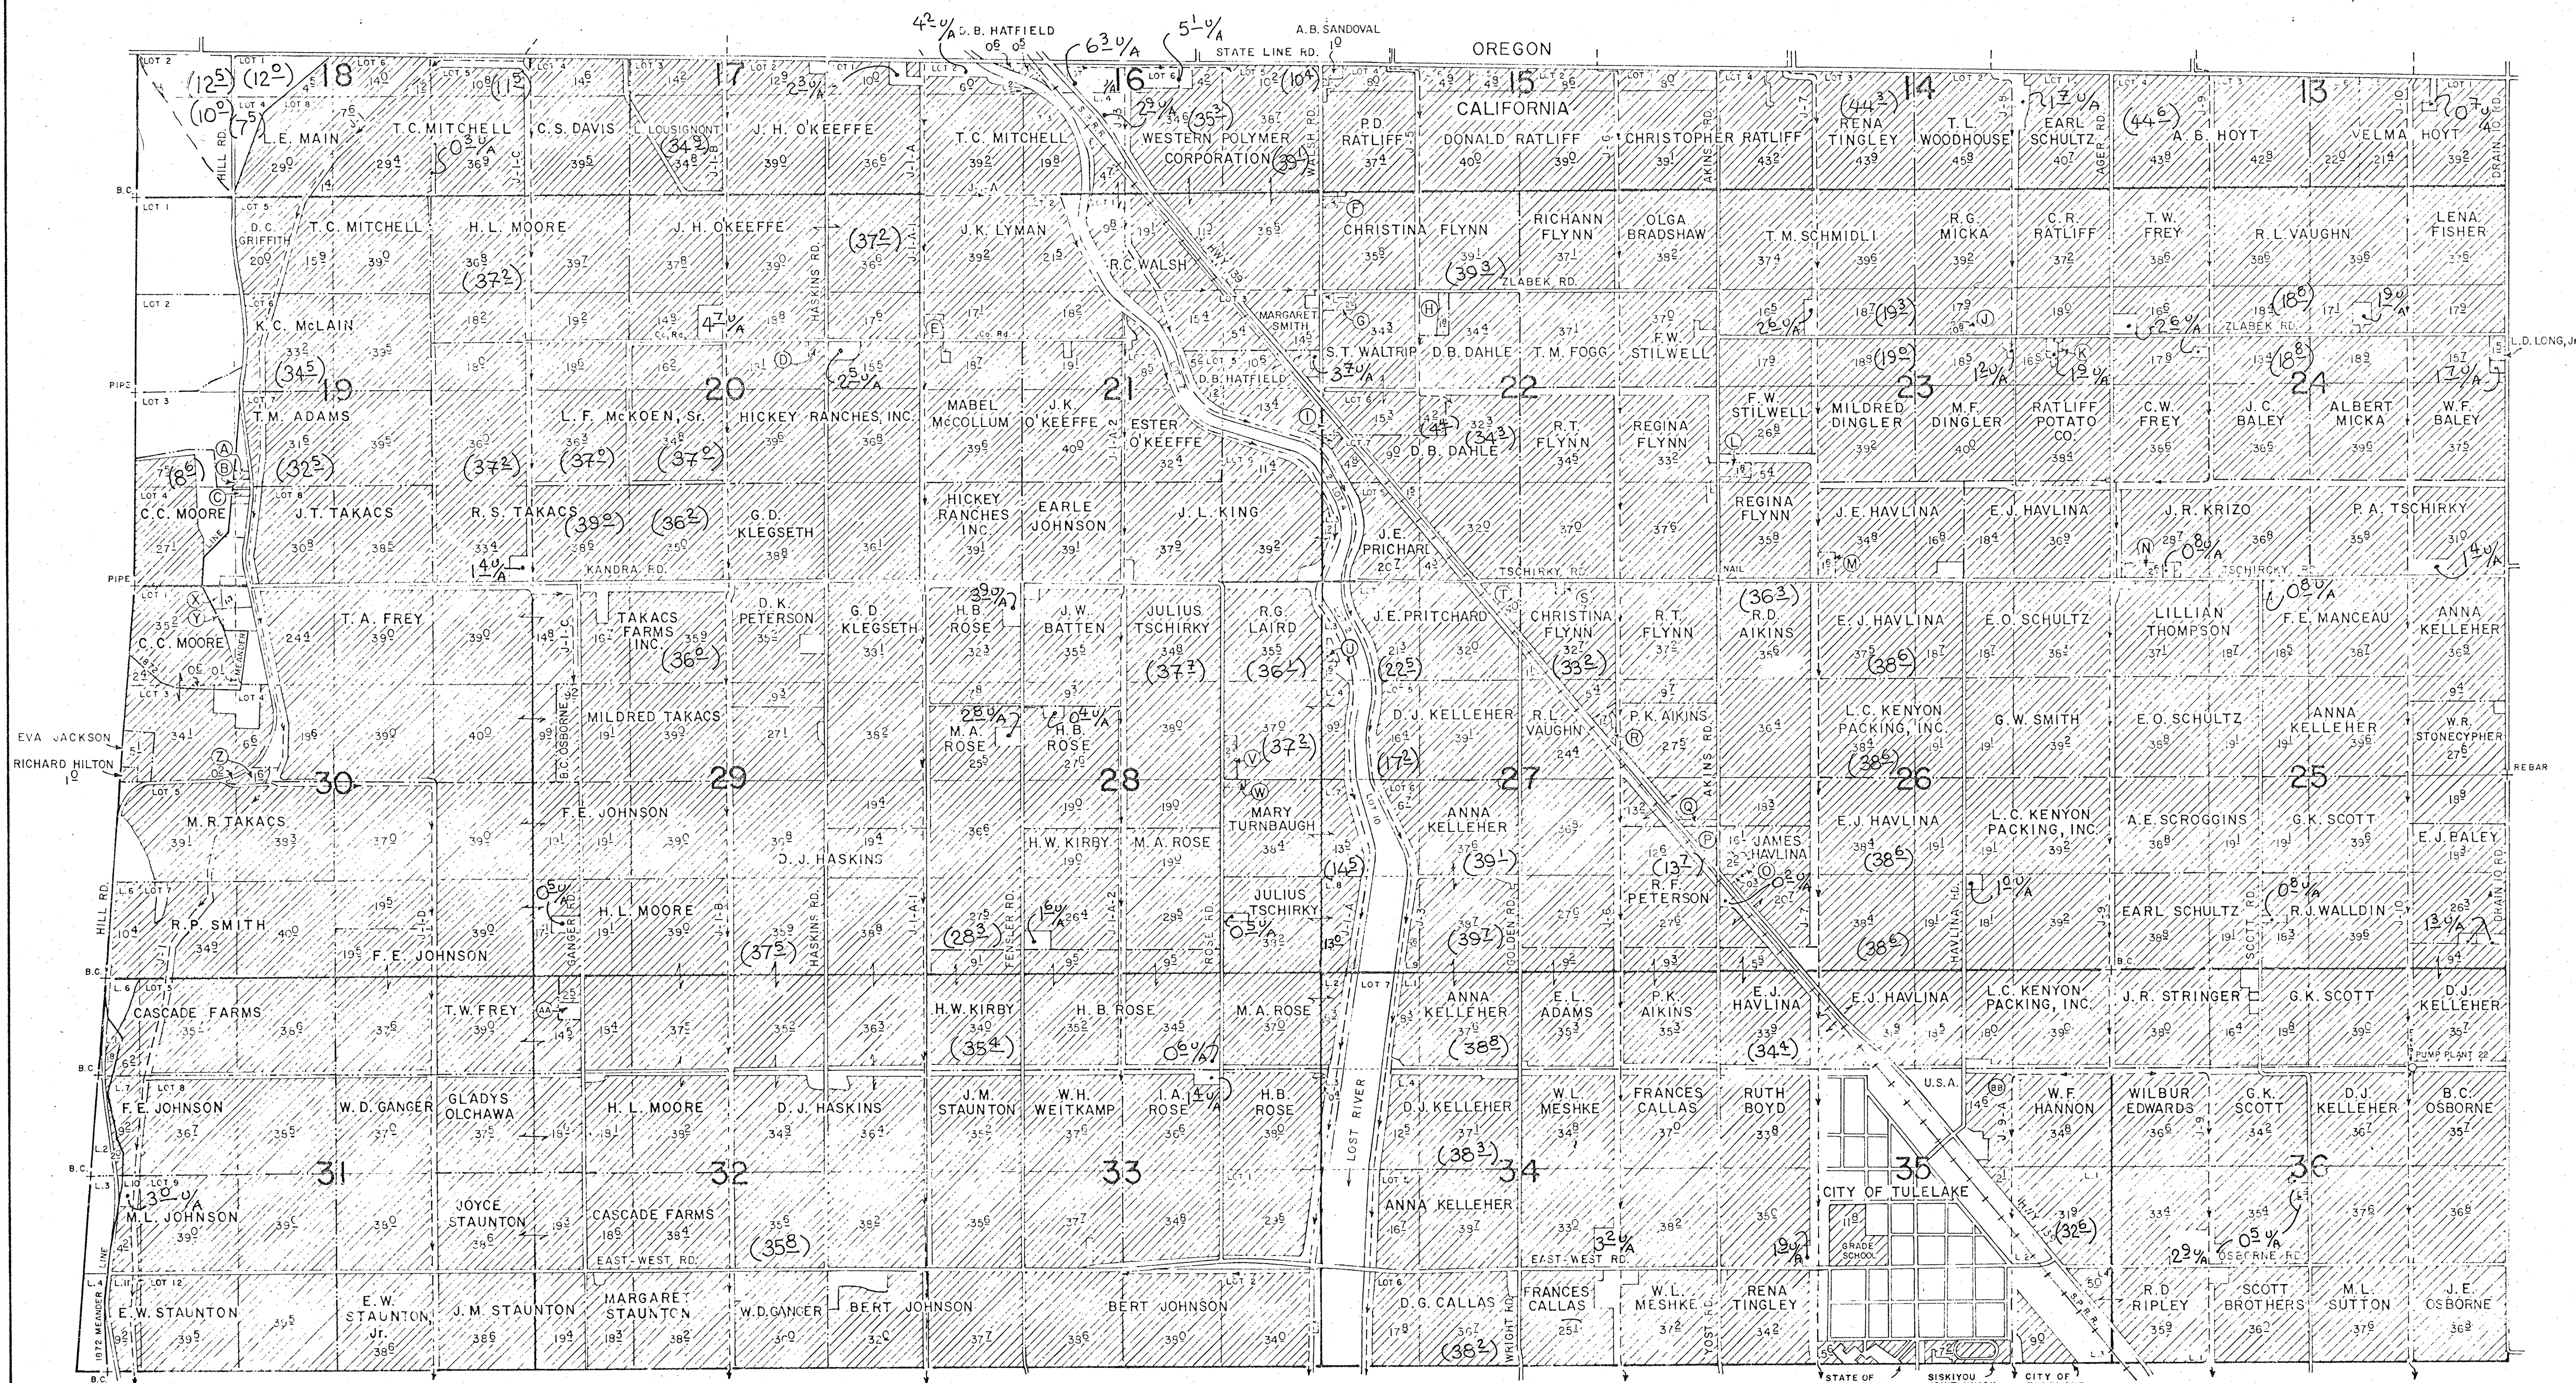

(34.5) Indicates corrected acreage for the area  
 34.5 u/a Indicates unirrigated acreage under contract