


TOWNSHIP 47 NORTH, RANGE 3 EAST, M.D.M.

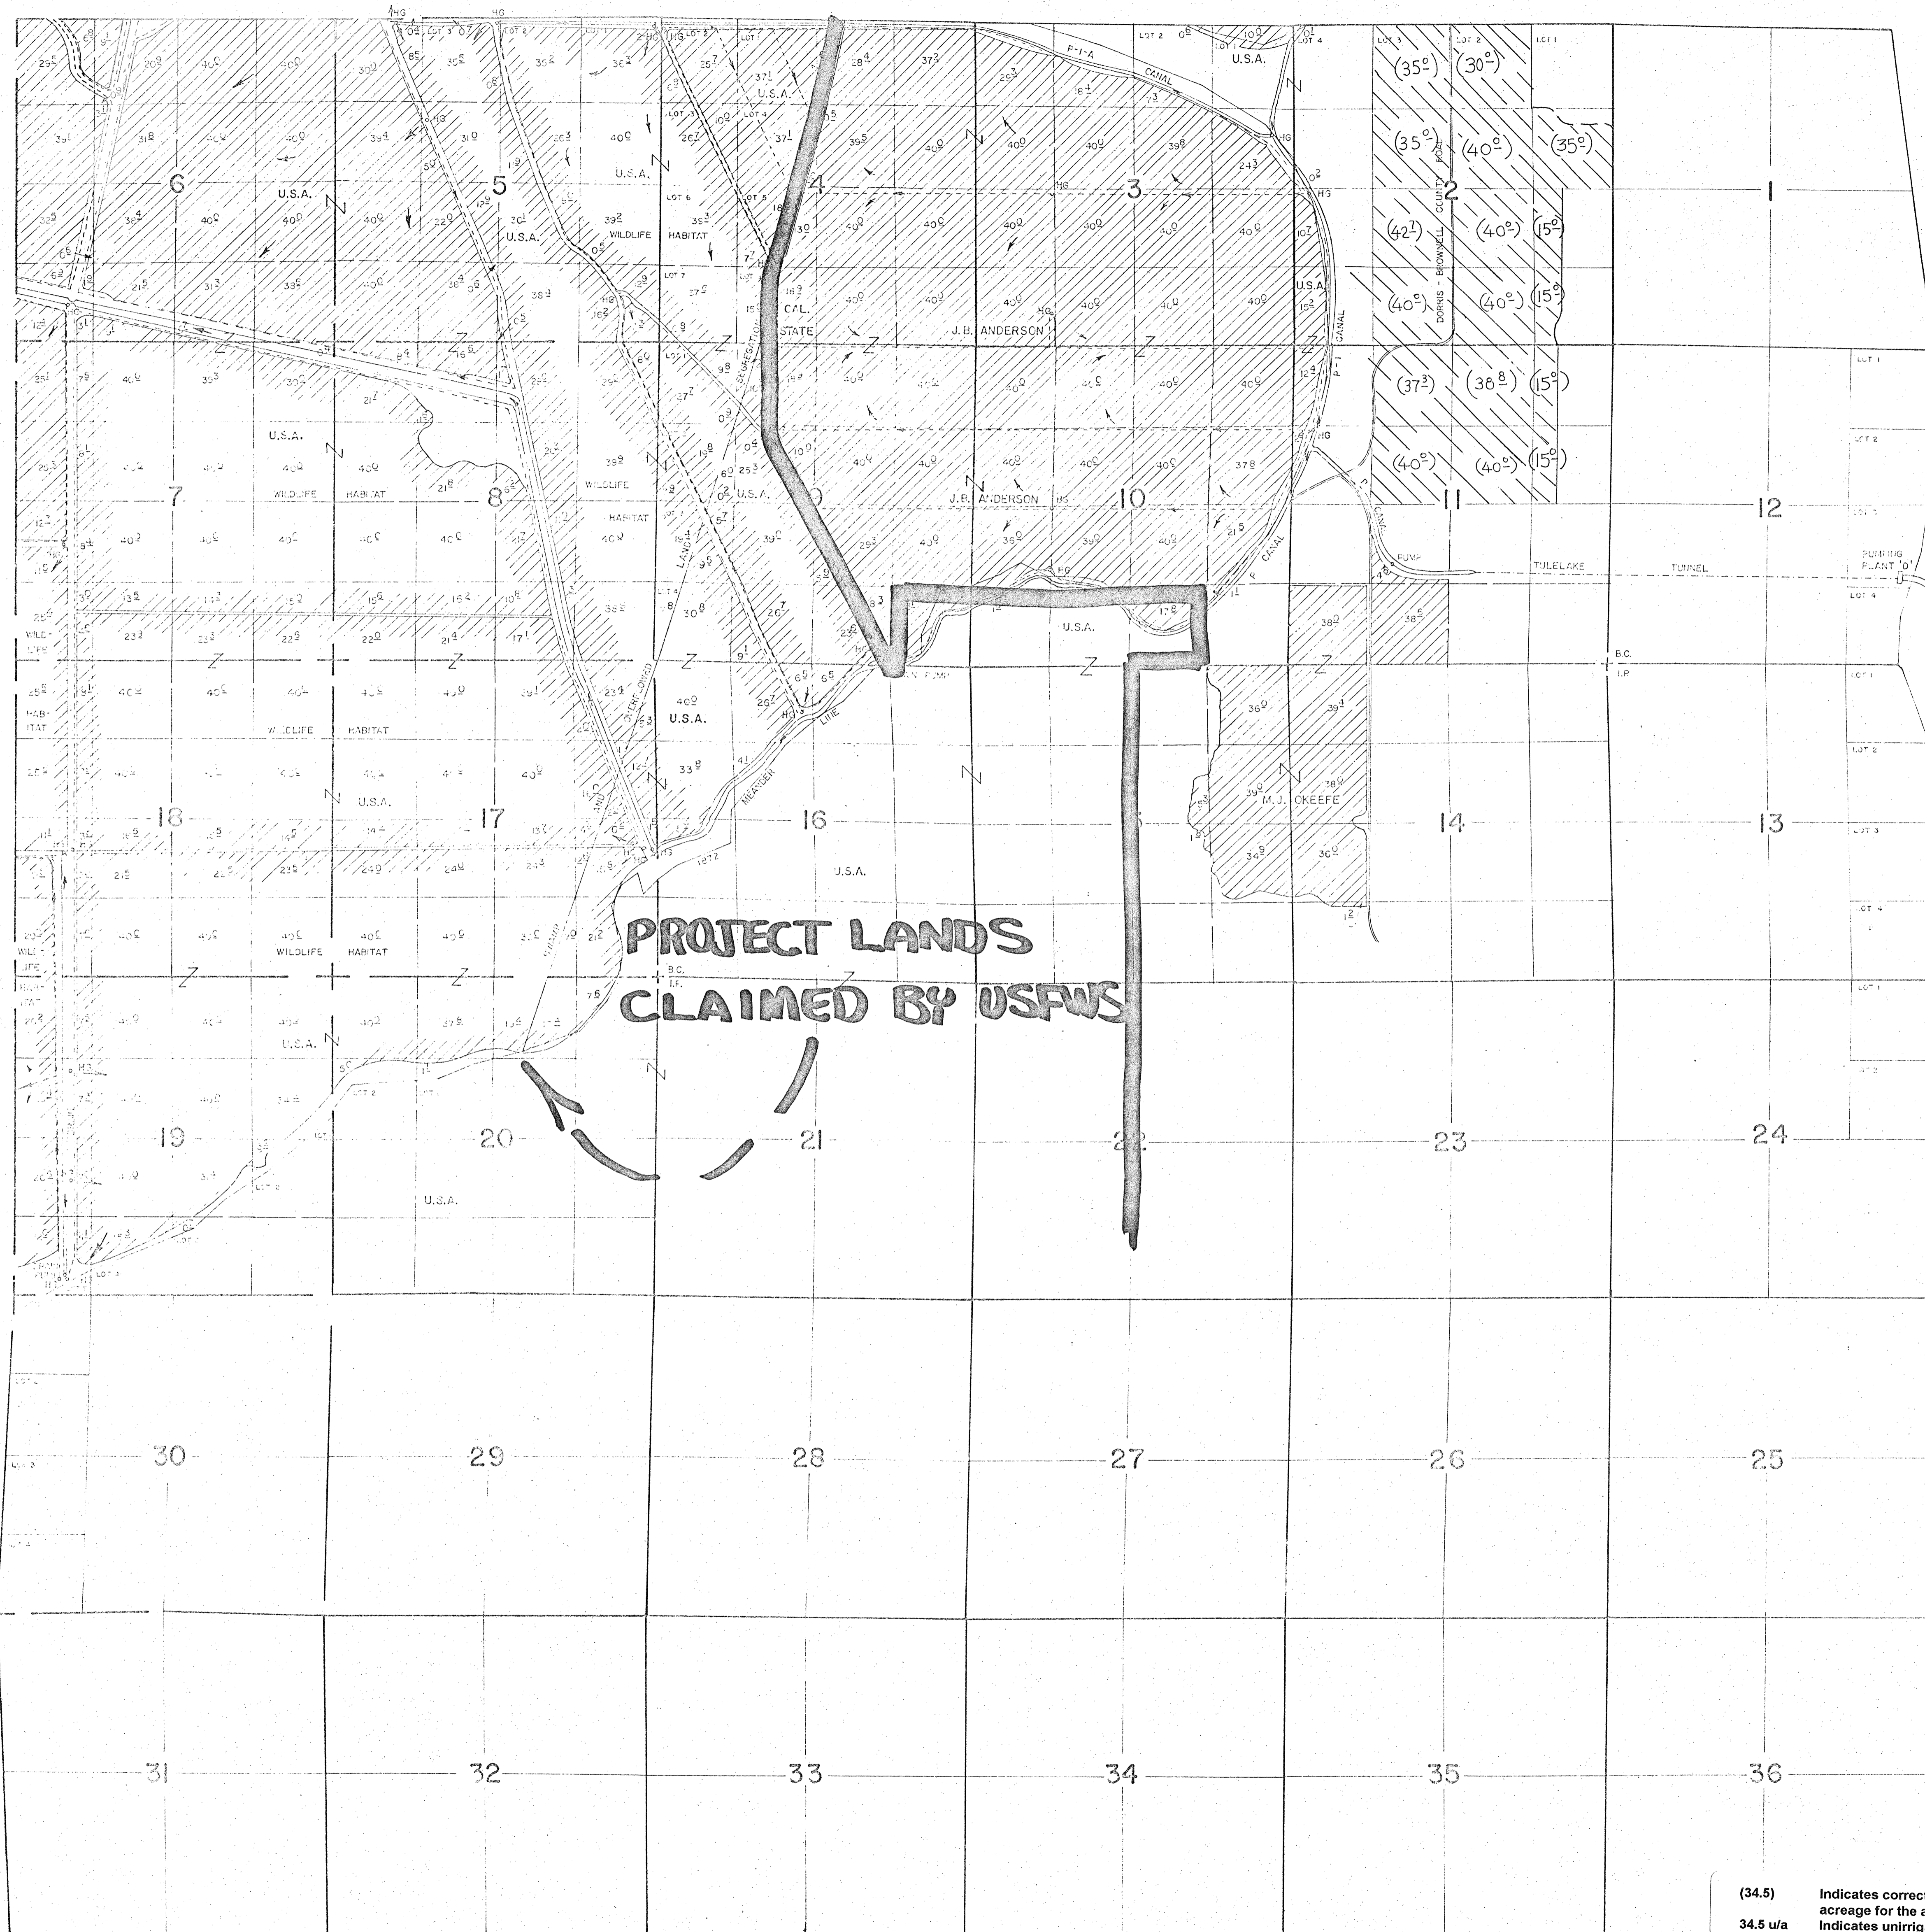

**PROJECT LANDS
CLAIMED BY USFWS**

(34.5) Indicates corrected acreage for the area
 34.5 u/a Indicates unirrigated acreage under contract