


TOWNSHIP 47 NORTH, RANGE 4 EAST, M.D.M.

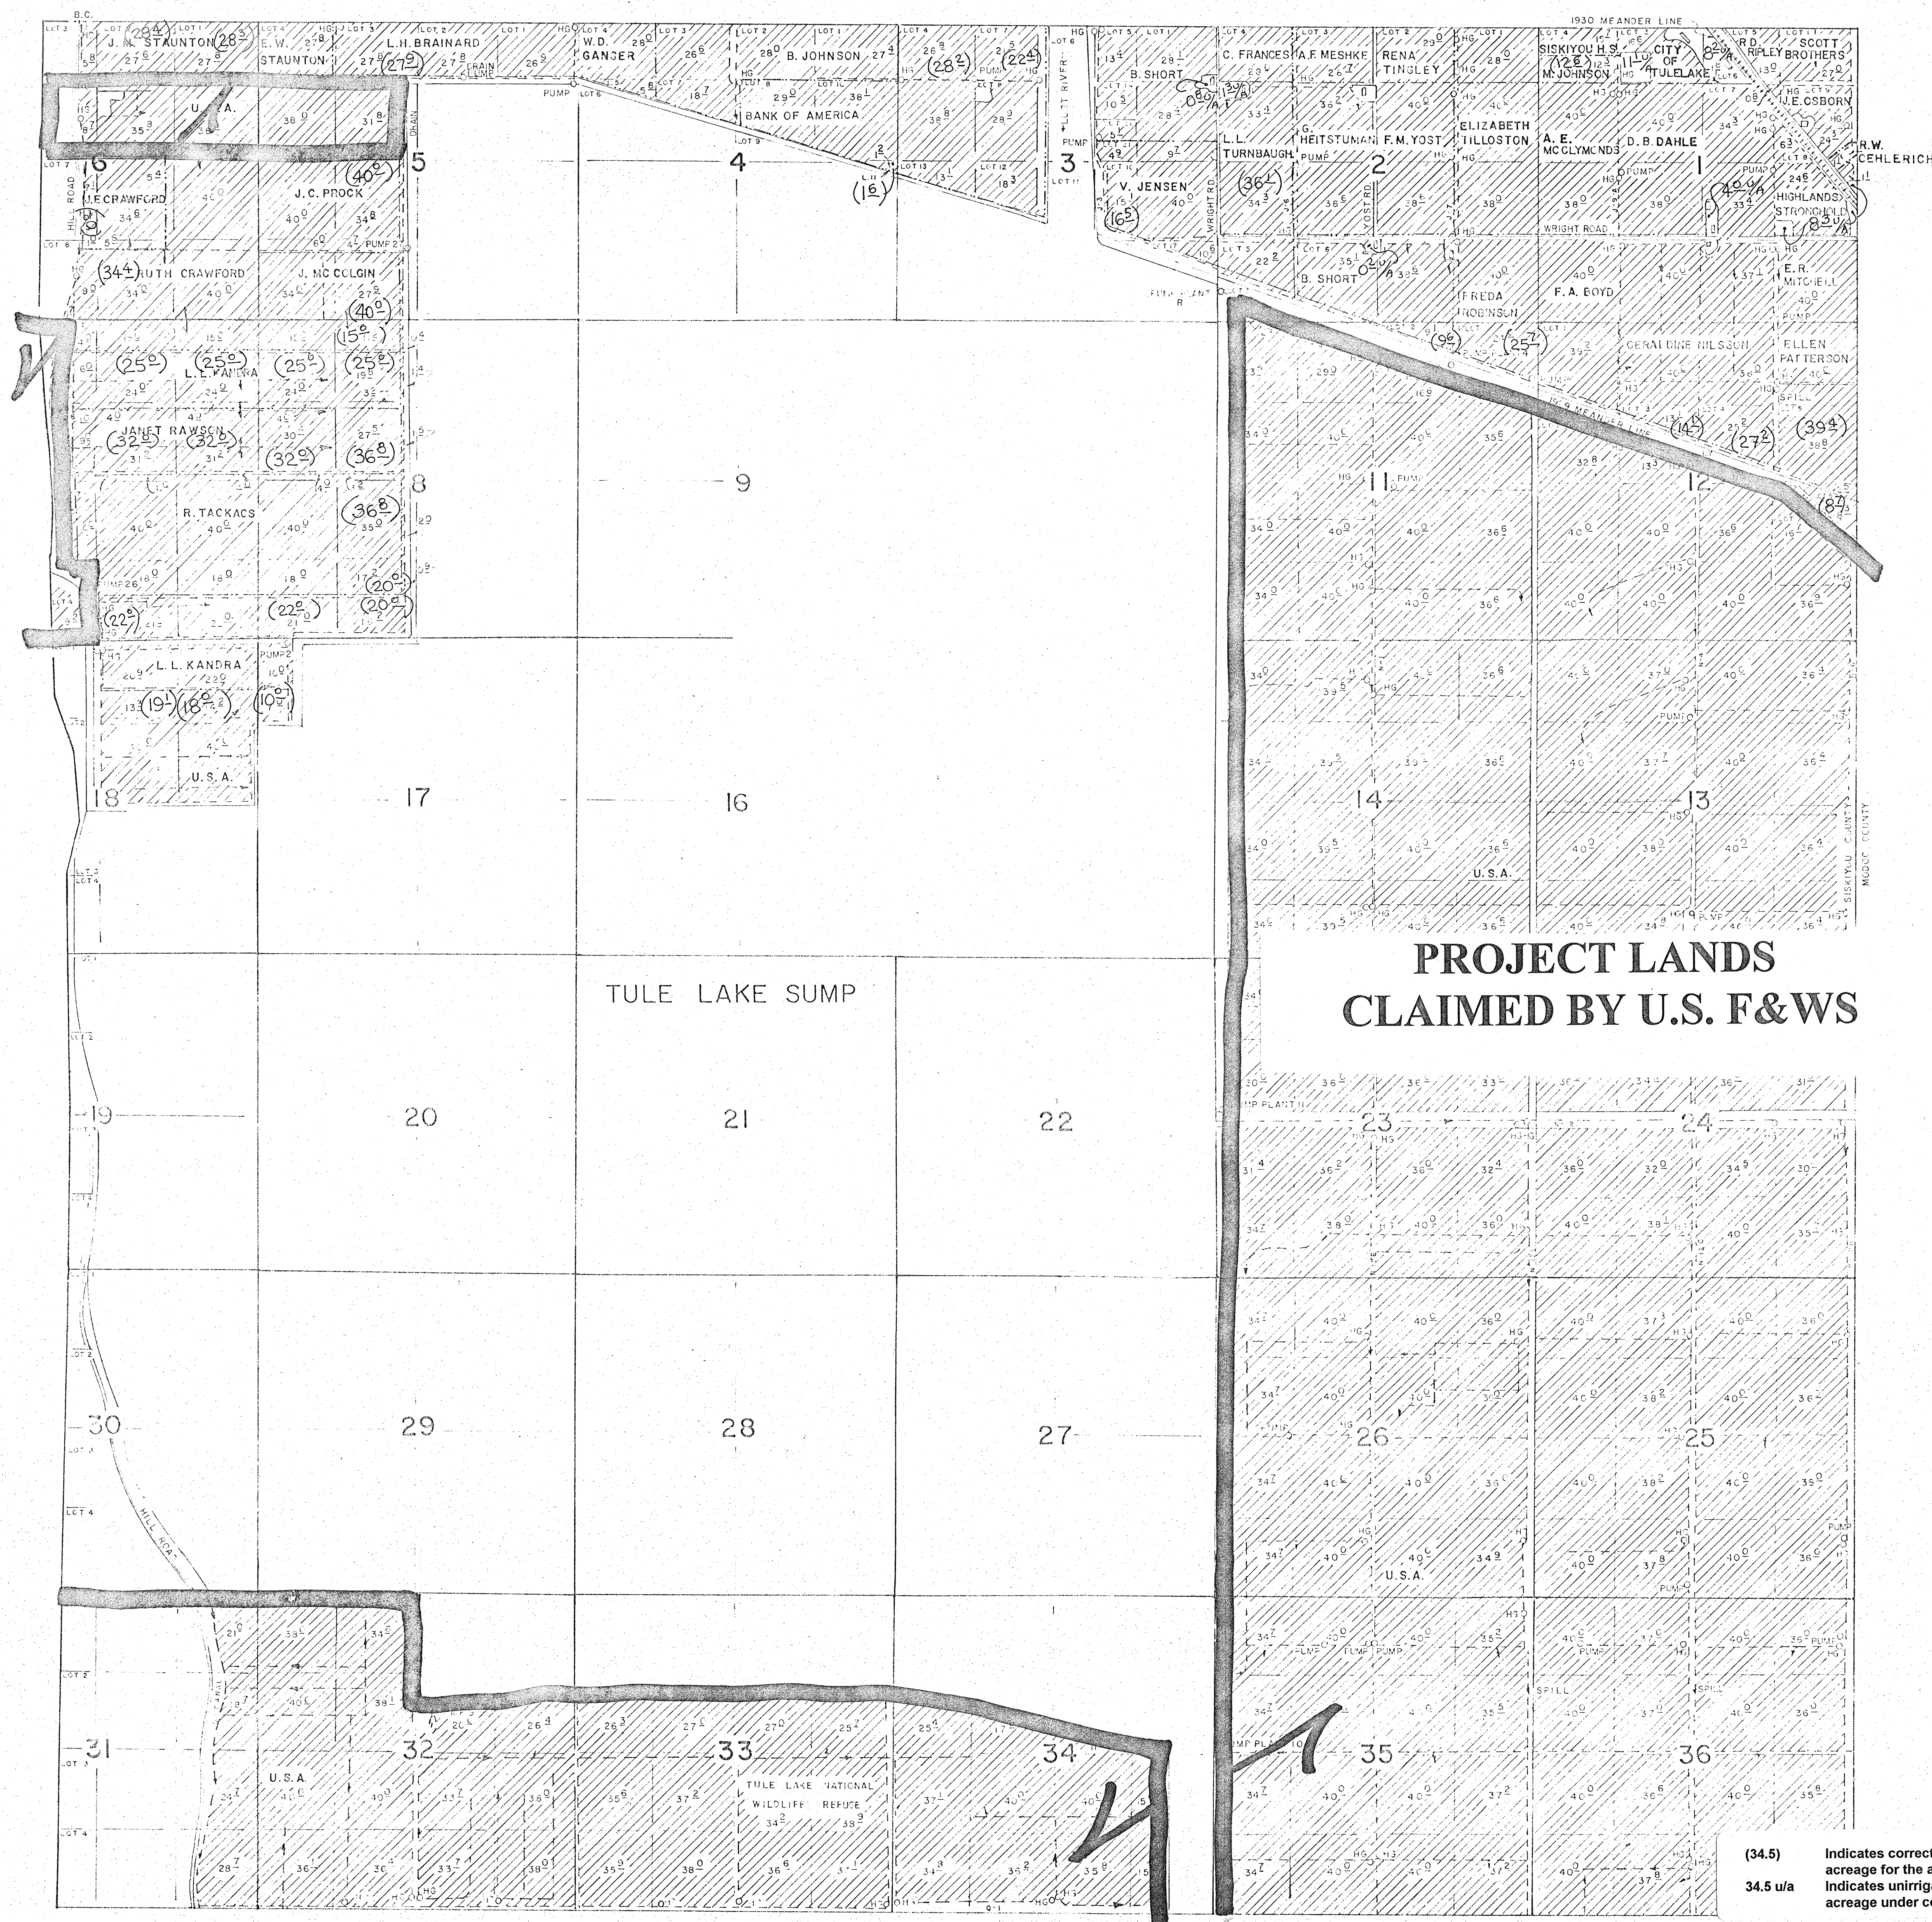

**PROJECT LANDS
CLAIMED BY U.S. F&WS**

(34.5) Indicates corrected acreage for the area
34.5 u/a Indicates unirrigated acreage under contract