


TOWNSHIP 47 NORTH, RANGE 5 EAST, M.D.M.

(34.5) Indicates corrected acreage for the area
34.5 u/a Indicates unirrigated acreage under contract

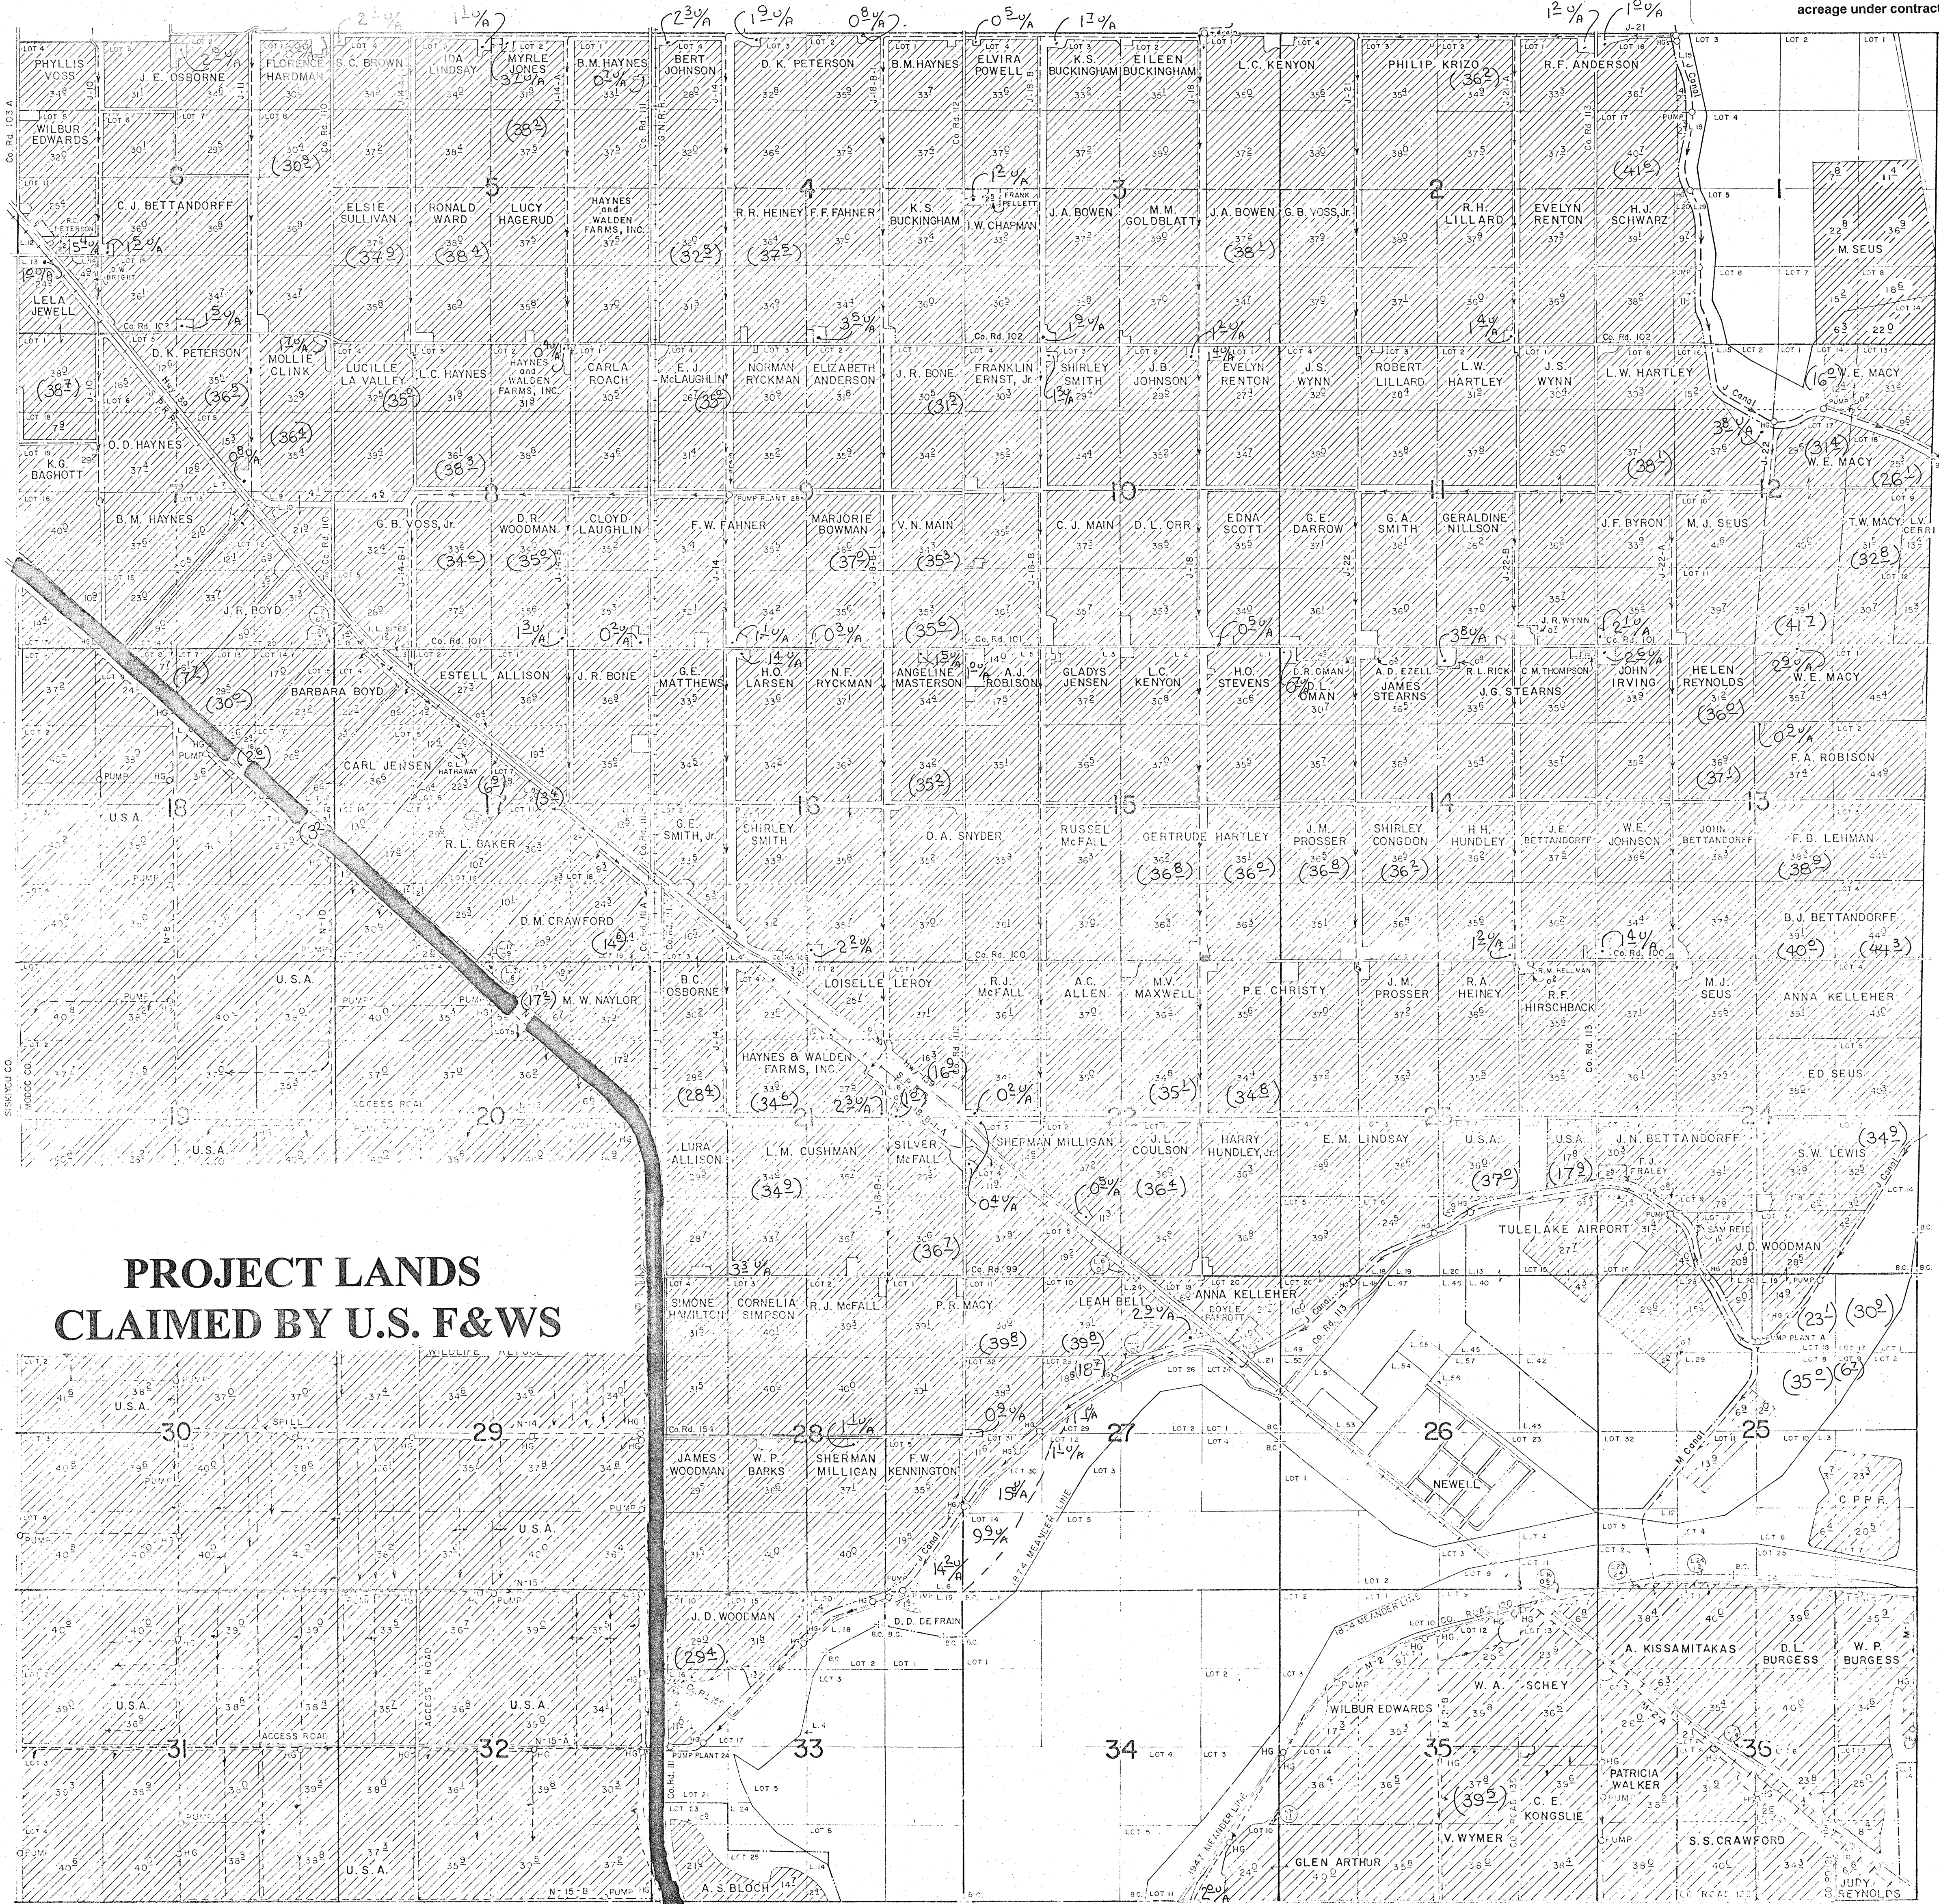

**PROJECT LANDS
CLAIMED BY U.S. F&WS**