

97 328

0034

# SUPPLEMENTAL MAP FOR CLAIM


IN THE NAME OF: U.S. FISH AND WILDLIFE SERVICE

SECTIONS 5 & 6, T. 47 N., R. 4 E., M.D.M.

1 INCH = 1320 FEET

KLAMATH ADJUDICATION

CLAIM # 317 PAGE #


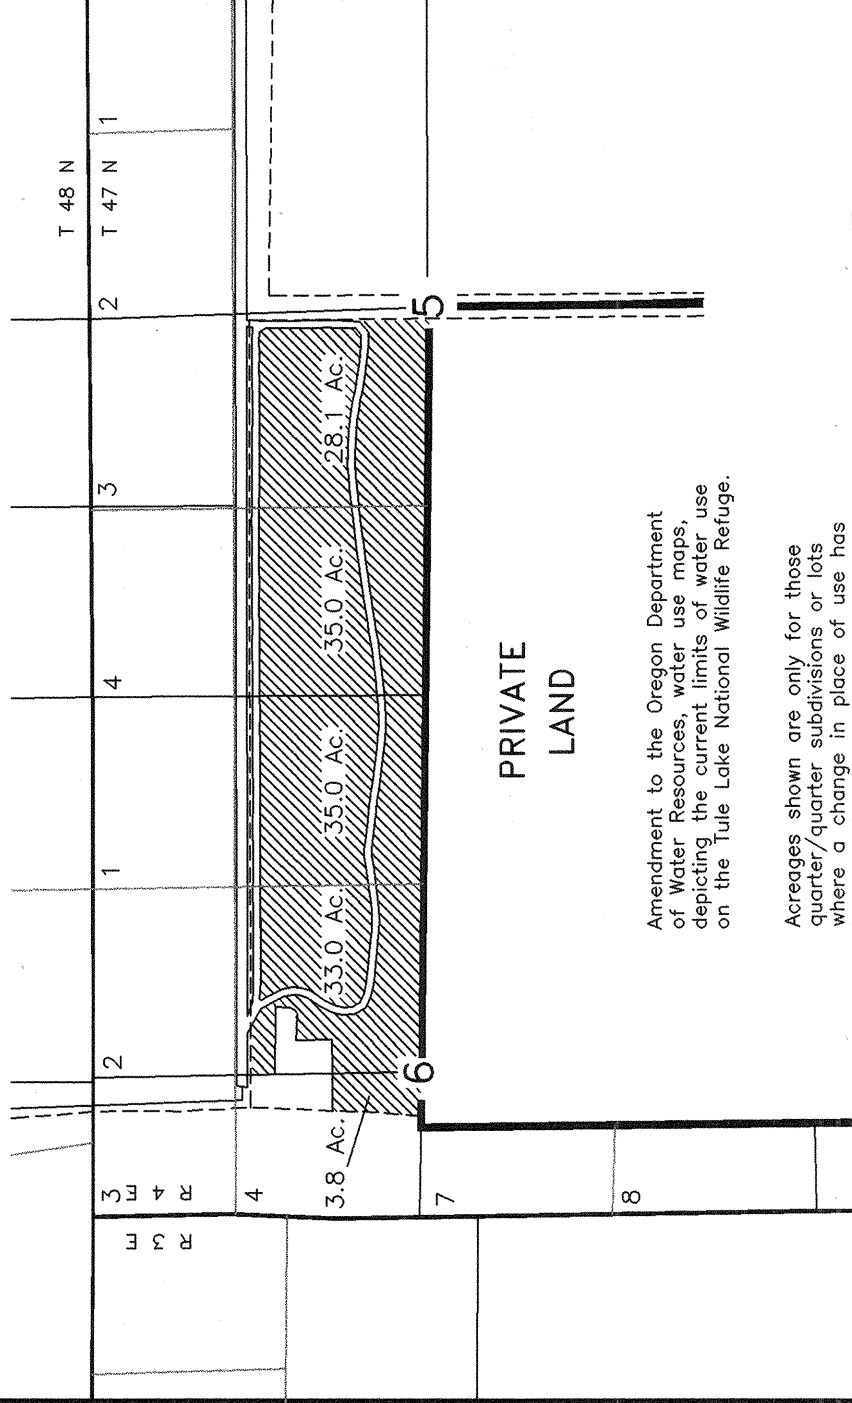


PRIVATE LAND

Amendment to the Oregon Department of Water Resources, water use maps, depicting the current limits of water use on the Tule Lake National Wildlife Refuge.

Acresages shown are only for those quarter/quarter subdivisions or lots where a change in place of use has been made.

The purpose of this map is to identify the location of the Water Right. It is not intended to provide information relative to the location of Property Ownership Boundary Lines.

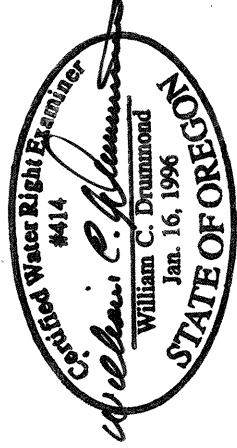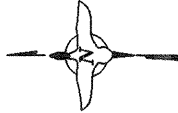

4/2/97