

FINAL PROOF SURVEY

APPLICATION NUMBER: T-6030

PERMIT NUMBER: 47792

SURVEYED: 6-22-90

PREPARED FOR:

W.J. MARTIN


2934 JUMPOFF JOE CREEK ROAD
GRANTS PASS, OREGON 97526

SECTION 32 T.34 S., R.5 W., W.M.
JOSEPHINE COUNTY, OREGON

THE PURPOSE OF THIS MAP IS TO IDENTIFY THE LOCATION
OF THE WATER RIGHT AND IS NOT INTENDED TO PROVIDE
DIMENSIONS OR LOCATION OF PROPERTY OWNERSHIP LINES.

30 29

31 32

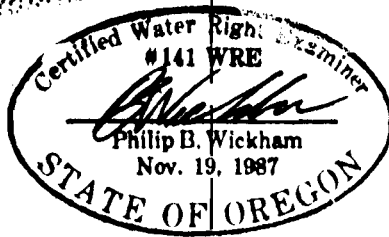

SCALE: 1" = 400'

