


This map was prepared for assessment purpose only.

all water rights identified on this map are primary water rights.

CANCELLED
3700
3701
3801
3901

CEN. SEC. 21
T 36S R 5W.W.M.

SEE MAP 36 5 21-24

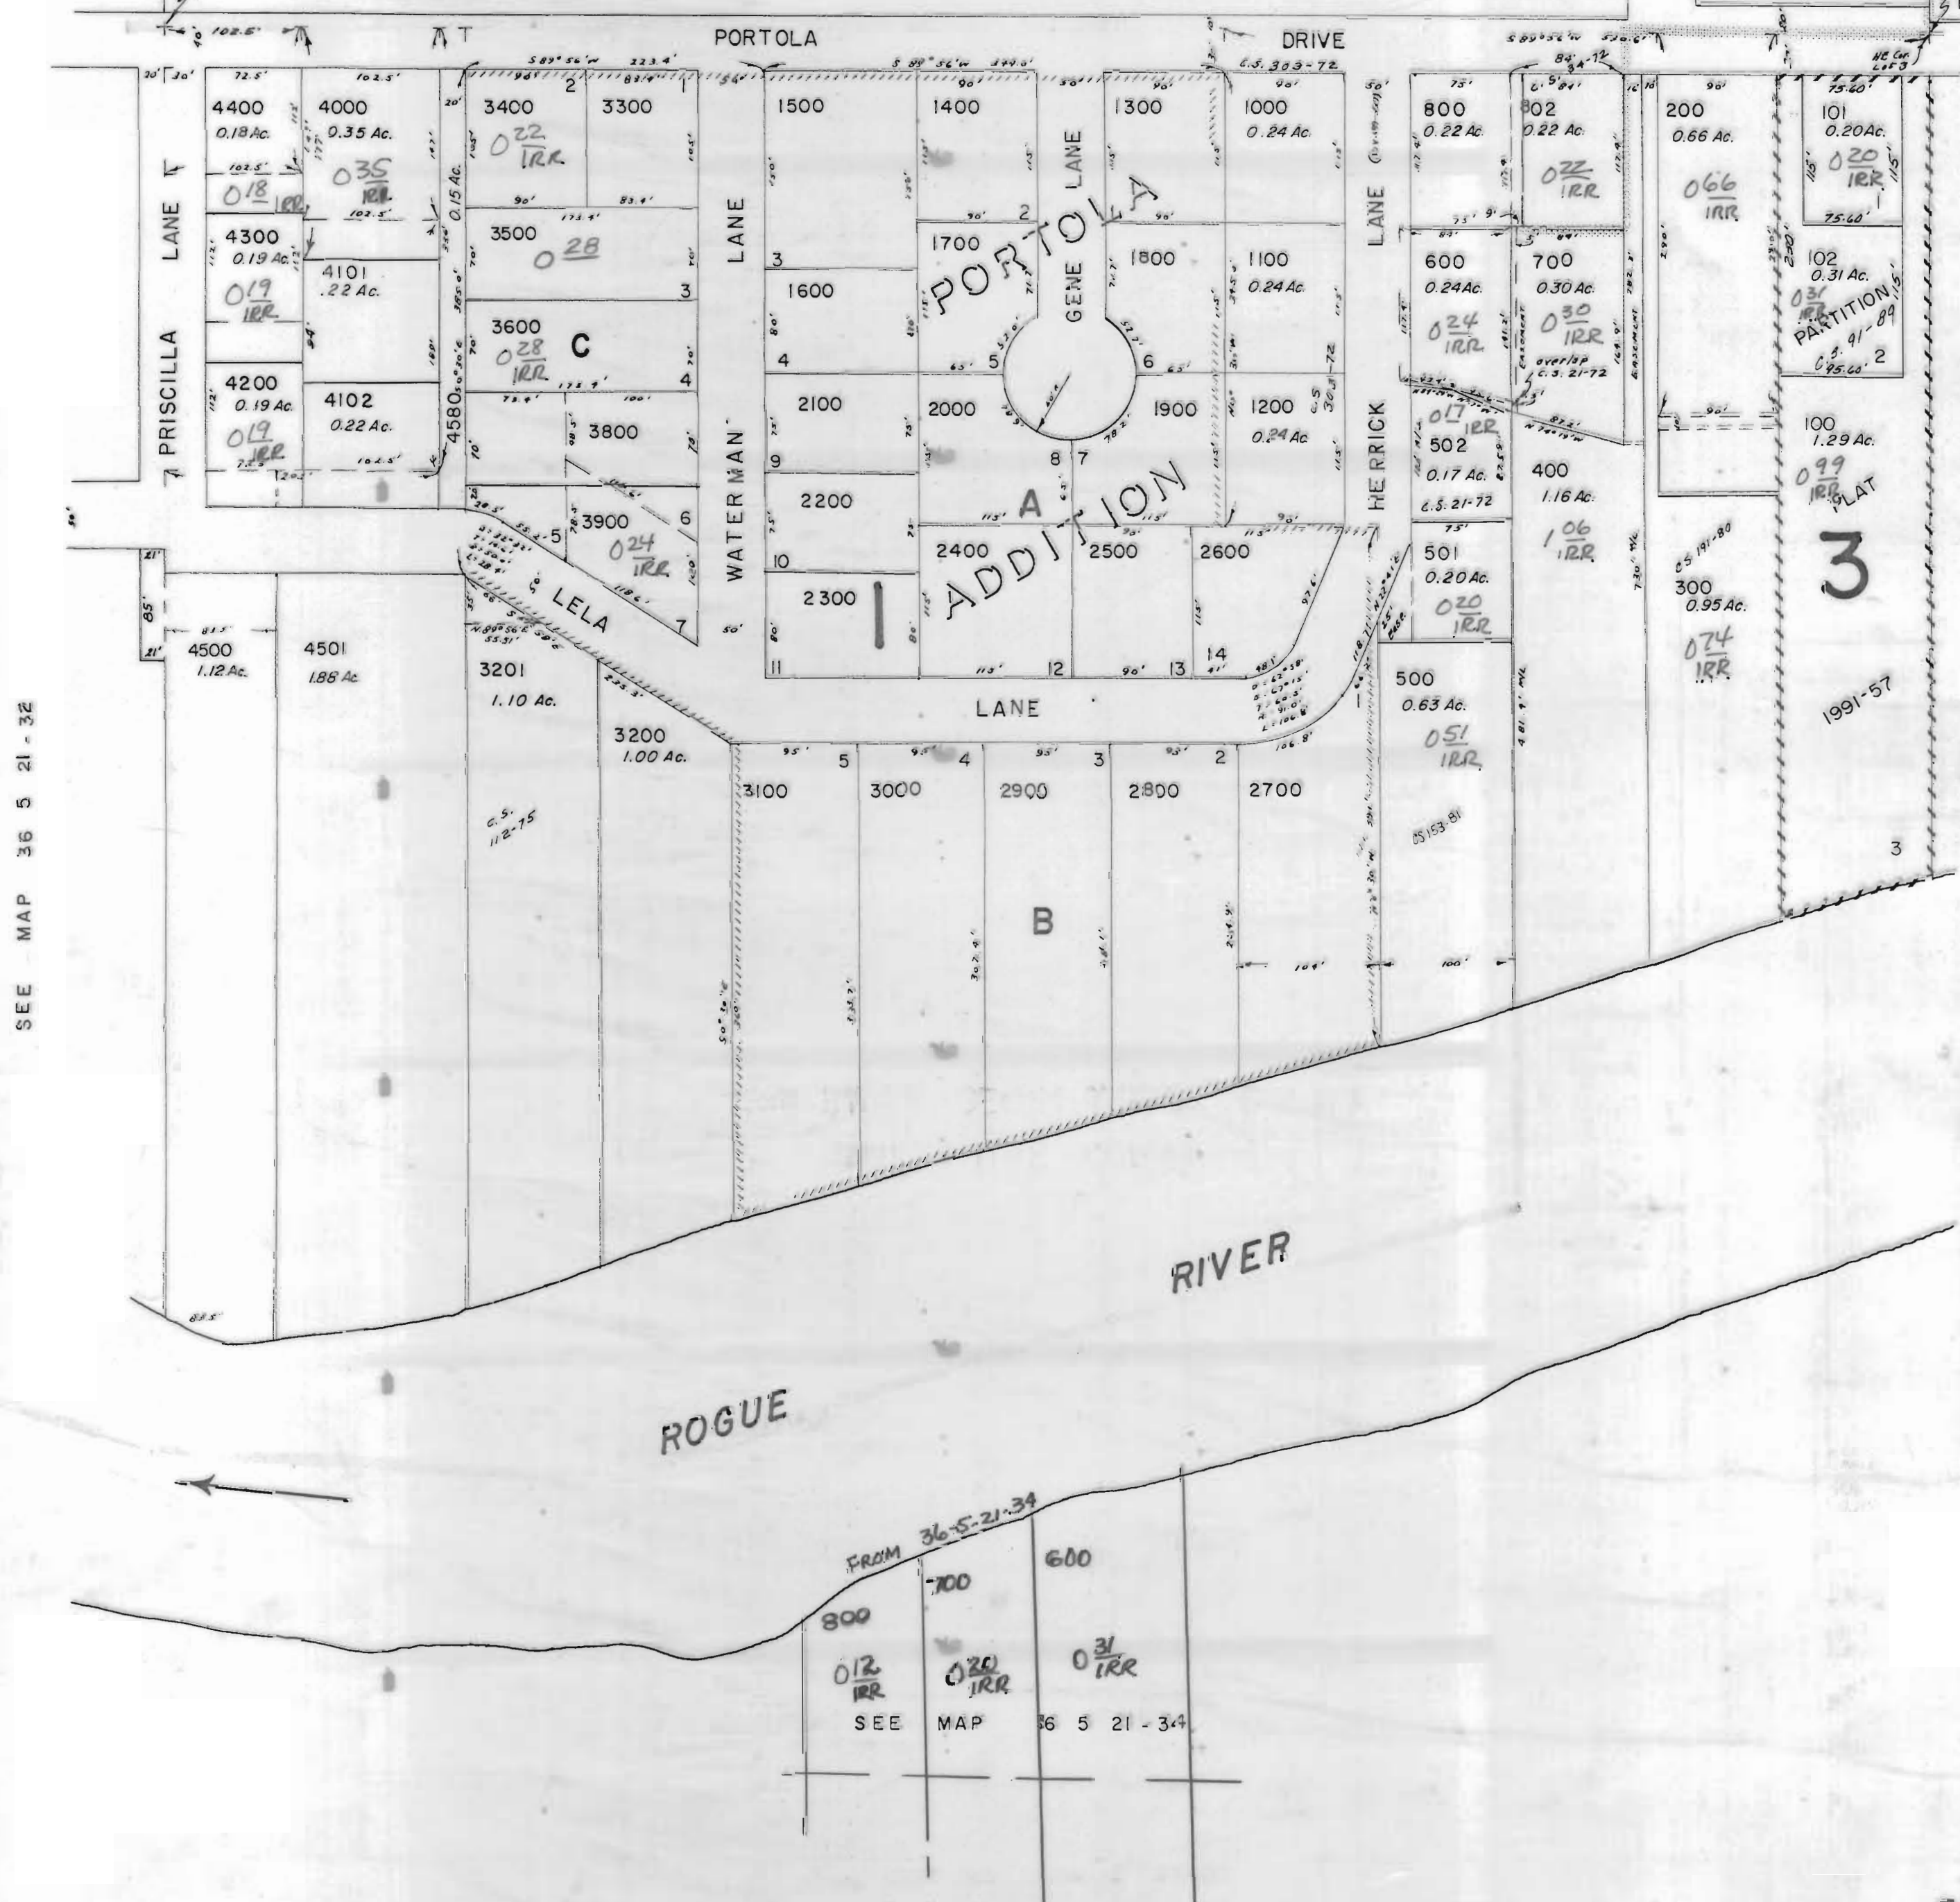

4581
4590
4201
4582
4301
4100
900
390

SEE MAP 36 5 21-42

SEE MAP 36 5 21-32

FROM 36-5-21-34
800
700
600
012 IRR
020 IRR
031 IRR
SEE MAP 36 5 21-34